92

S 1/4 Cor. Sec. 33, T34, R23

found 4" sq. flat top Conc. Mon.
Iron pipe on North side
Mon. down 0.2'

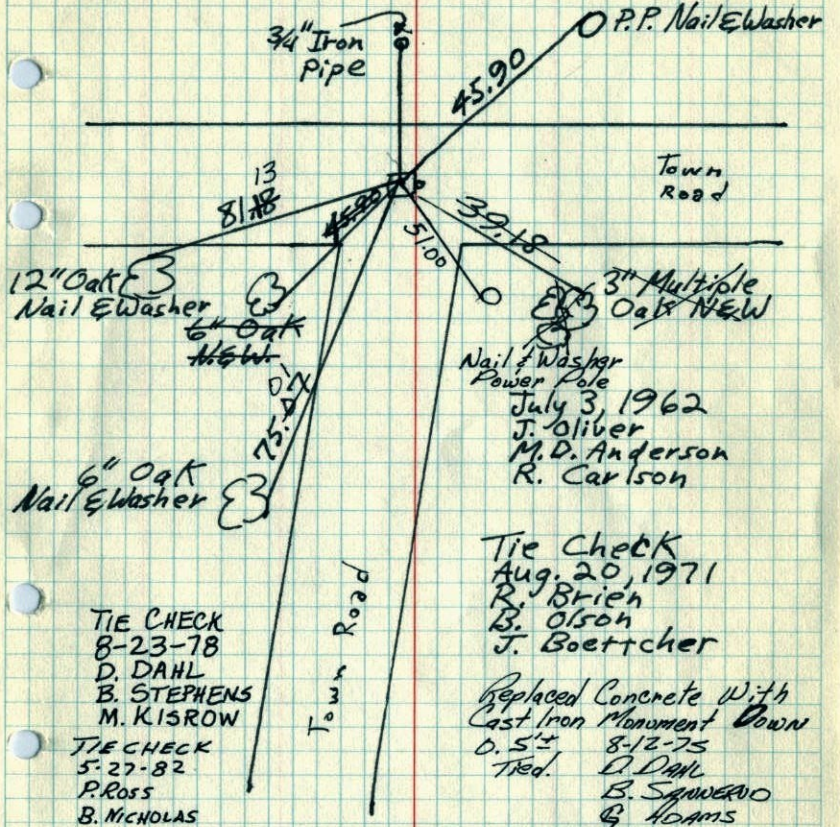

ROLAND W. ANDERSON
COUNTY SURVEYOR
ANOKA COUNTY, MINNESOTA

TEMPERATURE CORRECTED
AND HORIZONTALLY
TAPED MEASUREMENTS

30

S 1/4 Cor. Sec. 33, T34, R23

~~N 1/4 Cor. Sec. 4-33-23~~

found 4" Sq. flat top Conc. Mon.
Iron pipe on north side
Mon. down 0.2'

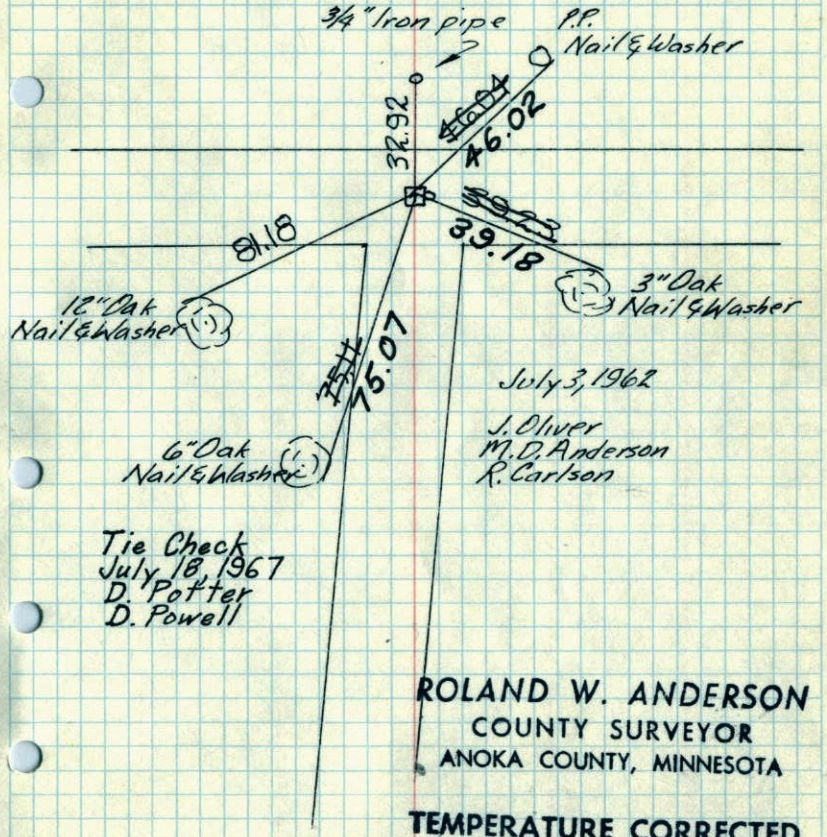

ROLAND W. ANDERSON
COUNTY SURVEYOR
ANOKA COUNTY, MINNESOTA

TEMPERATURE CORRECTED
AND HORIZONTALLY
TAPED MEASUREMENTS

X S 1/4 Cor. Sec. 33, T 34, R 23 ~~26~~

~~N 1/4 Cor. Sec. 4-33-23~~

found 4" Sq. flat top Conc. Mon.

Iron pipe on north side

Mon. down 0.2'

7/18/67

D. POTTER

D. POWELL

✓#7 - 78✓

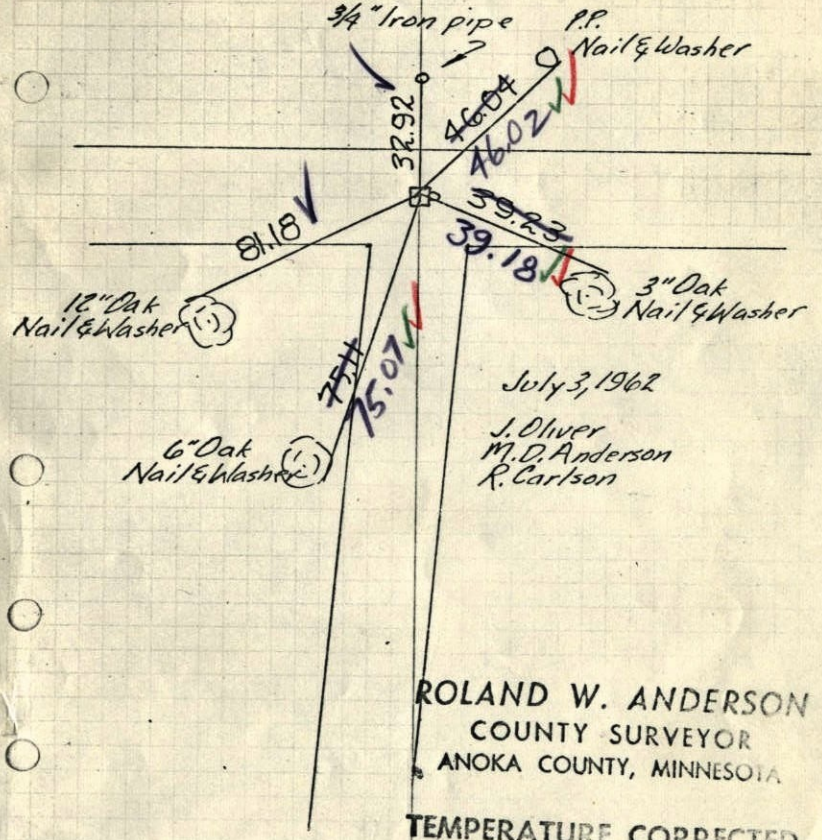

July 3, 1962

J. Oliver

M.D. Anderson

R. Carlson

ROLAND W. ANDERSON
COUNTY SURVEYOR
ANOKA COUNTY, MINNESOTA

TEMPERATURE CORRECTED AND HORIZONTALLY TAPED MEASUREMENTS