18

SE Cor Sec 31 T34 - R22

Tied 1" Iron pipe set by N.C. Hoium

PKs 2.00' N. + E.

Nov 19 - 1971
Tape 0 32°

H. Larson
F. Waks
M. Jenson

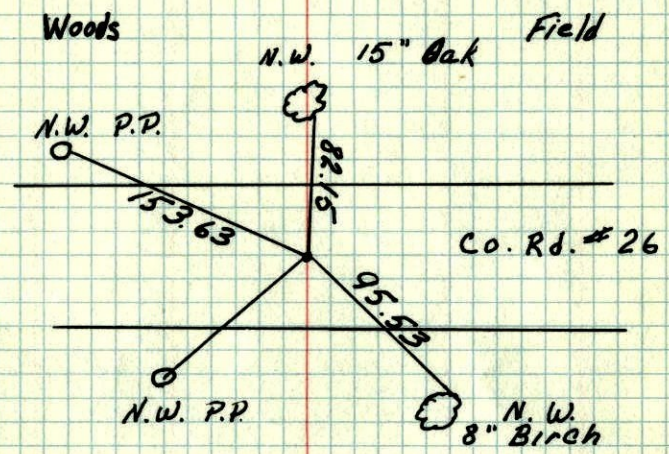

TEMPERATURE CORRECTED
AND HORIZONTALLY
TAPED MEASUREMENTS

ROLAND W. ANDERSON
COUNTY SURVEYOR
ANOKA COUNTY, MINNESOTA

SE Cor. Sec. 31 T34-R22

Tied 1" Iron pipe set by
N. C. Hoium.

PK's 2.00' North
and East.

Nov. 19-1971
Tape 0 32°

H. Larson
F. Waks
M. Jenson

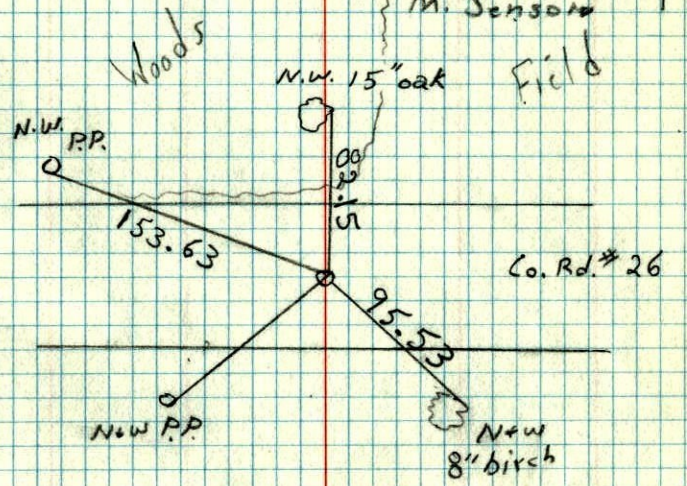

10-27-71

SE SEC. 31 T. 34 R. 22

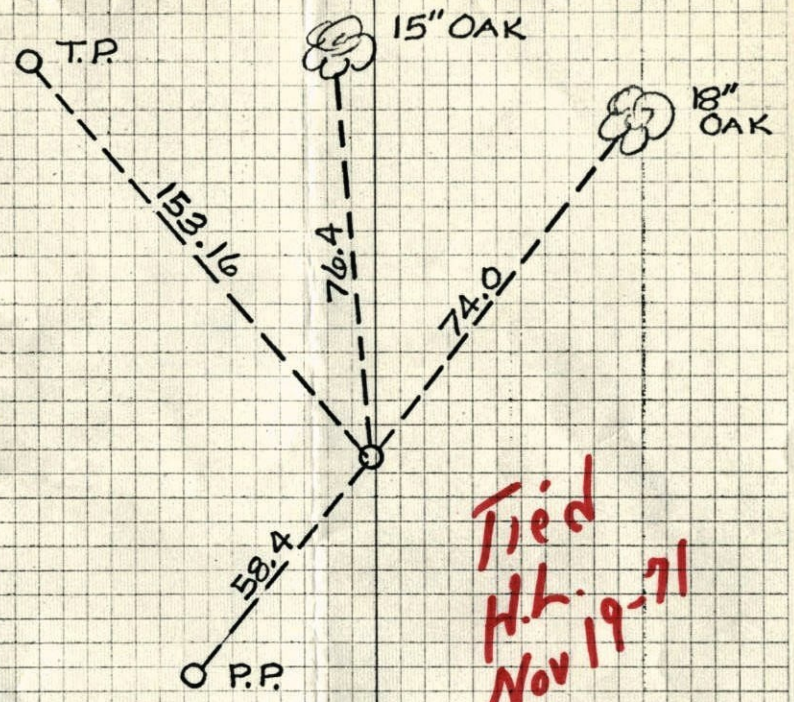

Tied
H.L.
Nov 19-71

N. C. Hoium and Associates, Inc.

ENGINEERS AND SURVEYORS
10130 Central Ave. N. E. (Hwy. 65)
Minneapolis, Minnesota 55433