S.E. COR SEC. 32-34-23

3" I.P. 4' LONG UP 1.8' IN SWAMP

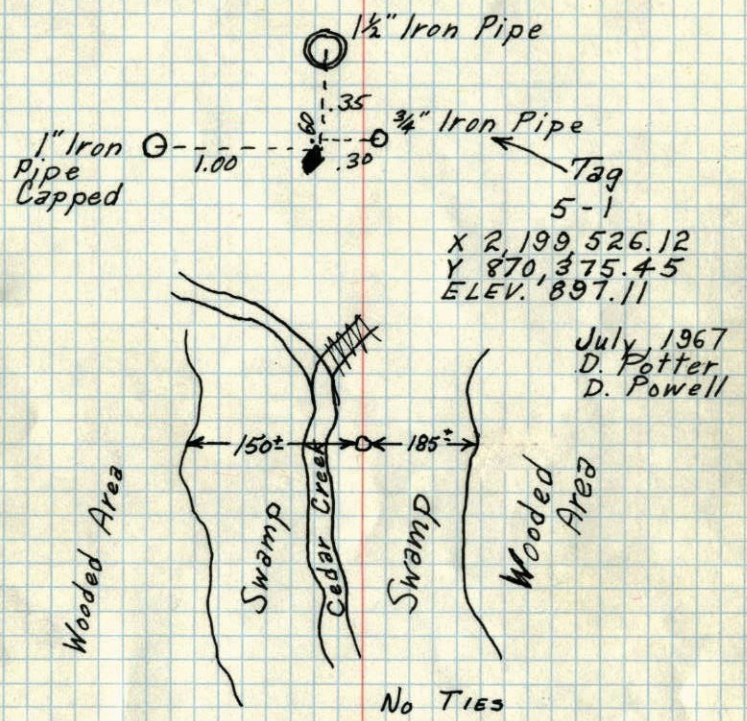

1-24-74
Found 1½" and ¾" pipes
H. Larson

Could not get to corner, Wet. 9-20-71

Set Red & white iron pipe
12.10.72 H. Larson
See New Tie

NORMAN C. HOLUM

X

S.E. COR SEC. 32-34-23

3" I.P. 4' LONG UP 1.8' IN SWAMP

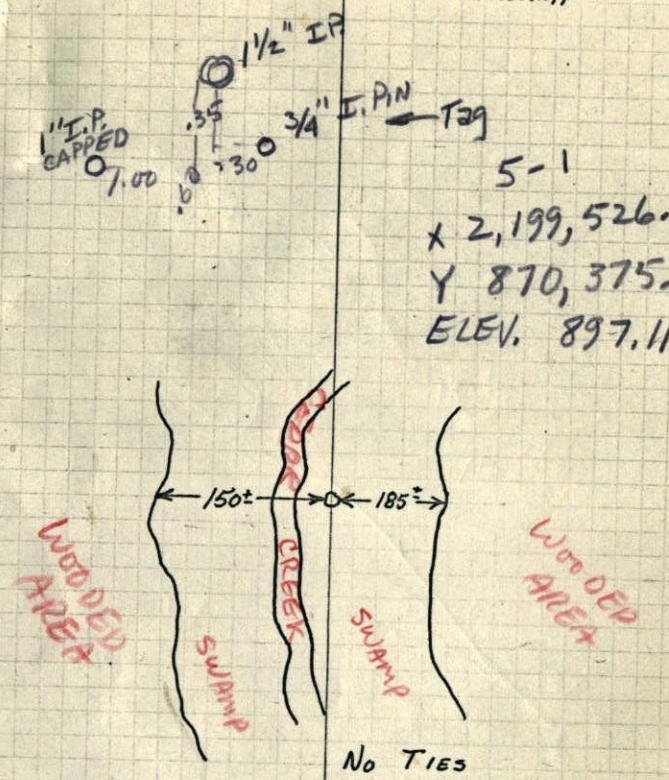

NORMAN C. HOLUM