S.W. Cor. Sec. 33 - T34 - R23

set red & white iron pipe in place of 1½" iron pipe.

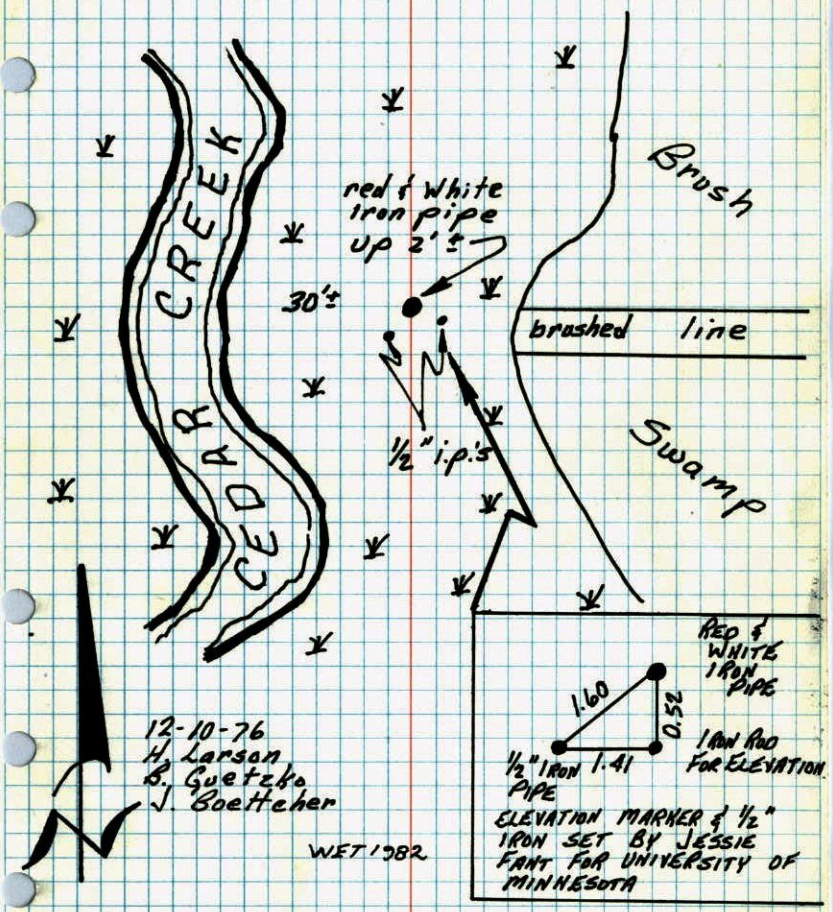

TEMPERATURE CORRECTED AND HORIZONTALLY TAPED MEASUREMENTS

ROLAND W. ANDERSON
COUNTY SURVEYOR
ANOKA COUNTY, MINNESOTA

SW Cor. Sec. 33 T34 R23
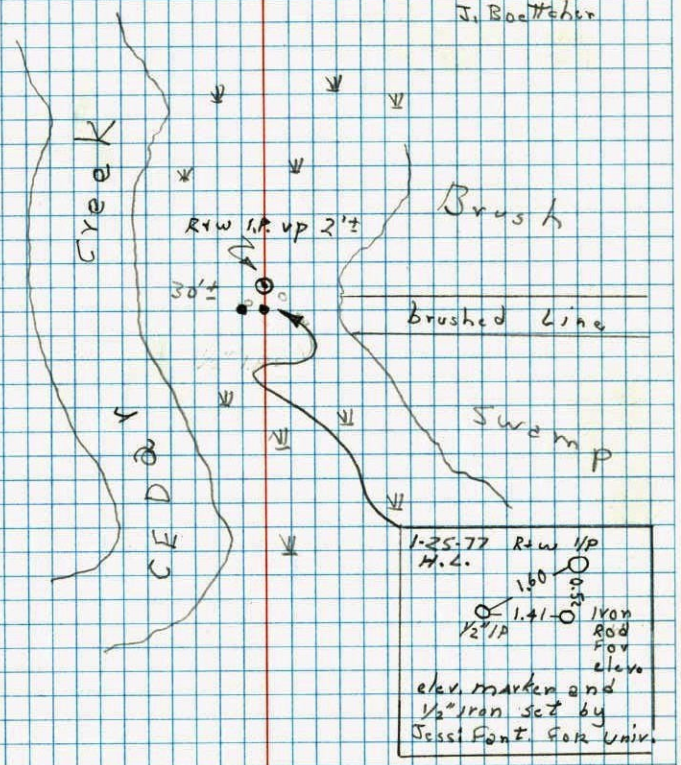
Set red + white iron pipe in place of 1½ iron pipe {R+W iron up 1.5'± with sign.}