W1/4 Cor. Sec 32, T34, R23

W.C. TO NORTH
3/4" IRON PIPE

8/22/67
D. Potter
D. Powell
#7-60°

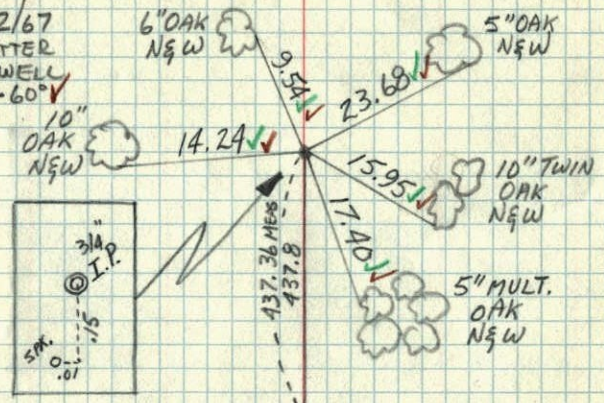

W1/4 Cor. Sec. 32, T34, R23

25

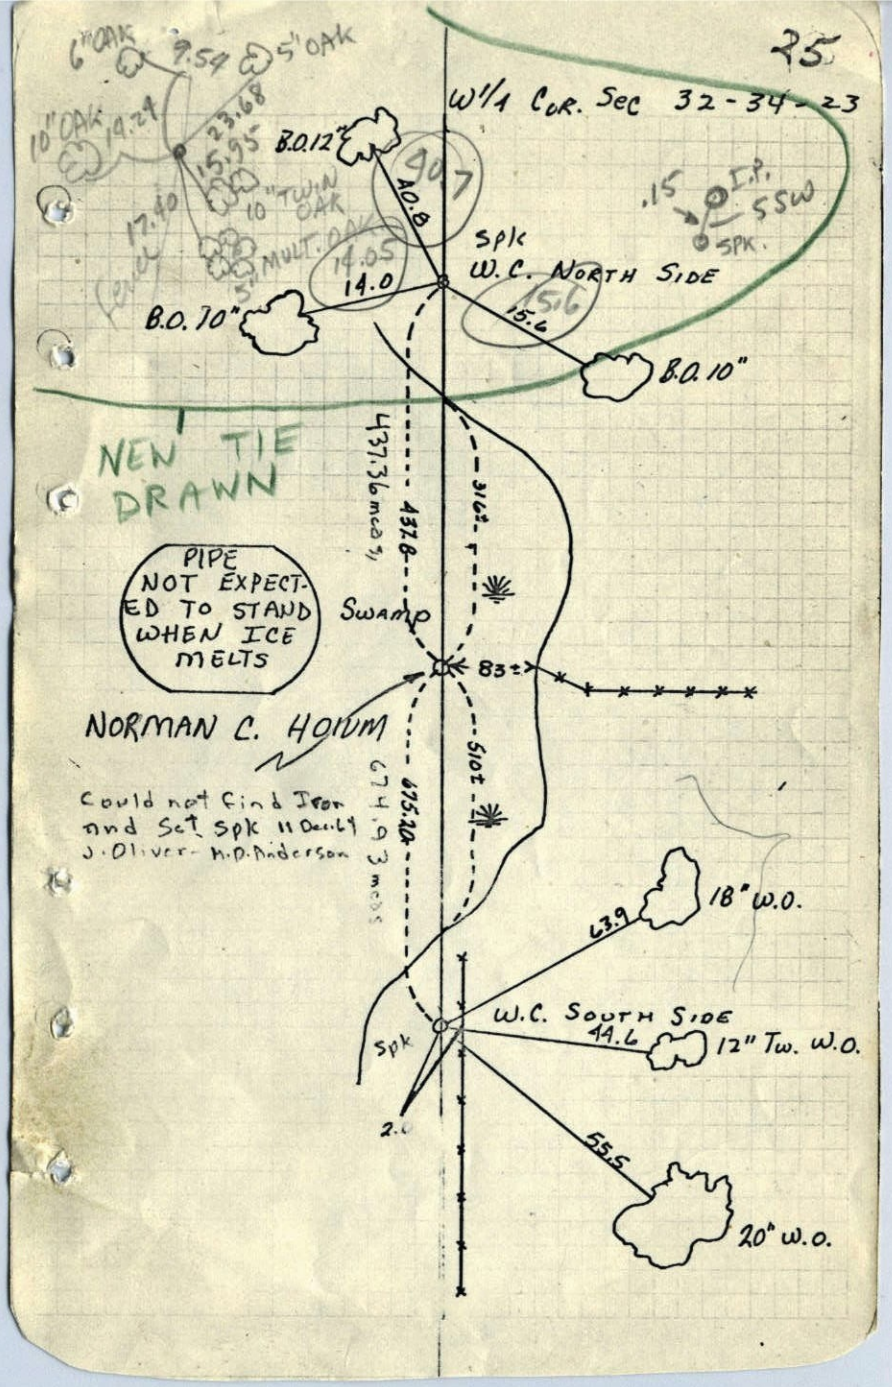

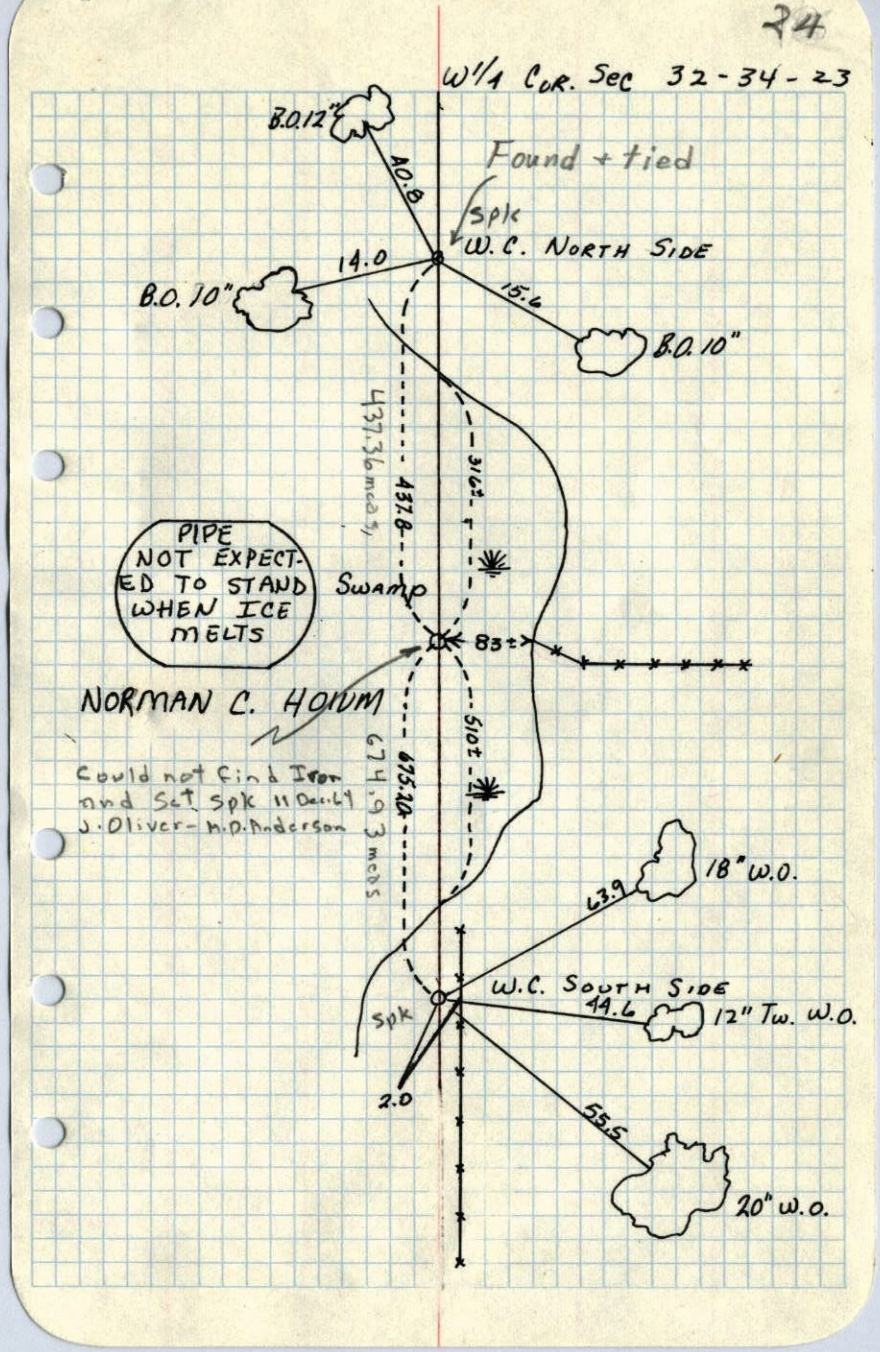
W1/4 Cor. Sec 32-34-23
B.O.12"
40.8
Found + tied
Spk
W.C. North Side
14.0
B.O. 10"
15.6
B.O. 10"
437.36 meas.
437.8
316±
PIPE NOT EXPECTED TO STAND WHEN ICE MELTS
Swamp
83±
NORMAN C. HOLM
Could not find Iron and Set Spk 11 Dec. 64 J. Oliver - N.D. Anderson
674.93 meas
675.2
510±
18" W.O.
63.9
W.C. South Side
Spk
44.6
12" Tw. W.O.
2.0
55.5
20" W.O.