

# CERTIFICATE OF LOCATION OF GOVERNMENT CORNER

County of Anoka State of Minnesota


Southwest Corner of Sec. 26 Township 33 Range 23

On the 13th day of June, 1960, the described corner was evidenced by a concrete monument

and to perpetuate the location of said corner, at the exact location thereof, a permanent marker was placed consisting of a cast iron monument

AND on the 18th day of June, 2002, said permanent marker was found and the ties were updated

Updated reference ties are as shown below.

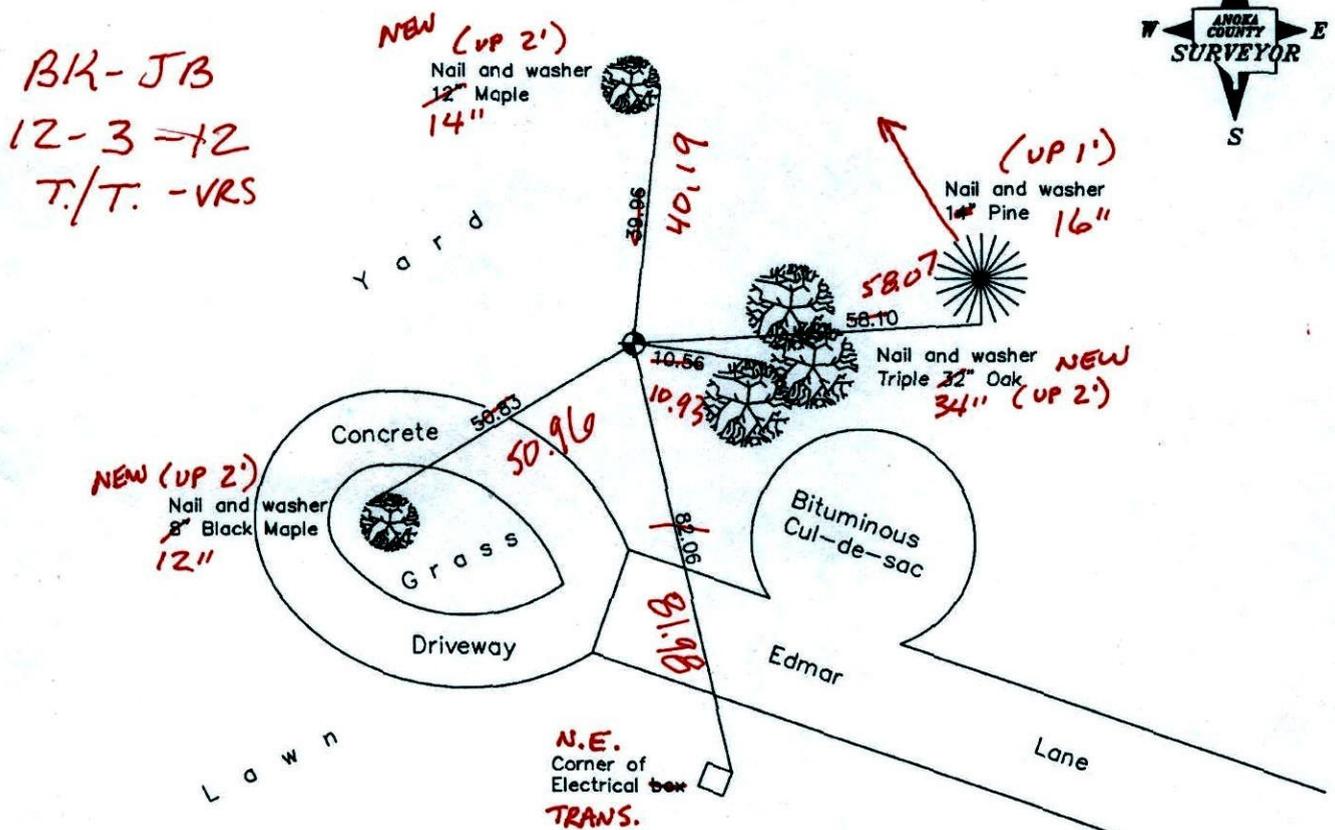

Revised date
8/17/92
8/10/00
6/18/02

N.A.D. 1983 Coordinates (1996 Adjustment)	
County Project Coordinates	
Northing	200986.8807
Easting	521232.6025
Date	6/18/02

I hereby certify that this United States public land survey monument record is correct and complete to the best of my knowledge and belief.

*Larry D. Holm* Date 6/18/02  
 Larry D. Holm, Anoka County Surveyor  
 Minnesota License Number: 18165

VRS 3D = 0.12      N = 200986.9348      E = 521232.4957

# CERTIFICATE OF LOCATION OF GOVERNMENT CORNER

County of Anoka


State of Minnesota

SOUTHWEST Corner of Sec. 26 Township 33 Range 23


I hereby certify that on the 13 day of JUNE, 1960, I found the described corner which was evidenced by CONCRETE MON.

and I further certify that to perpetuate the location of said corner, I did, at the exact location thereof, place a permanent marker consisting of CAST IRON MON. W. SIGN AND POST  
~~ON NORTH SIDE~~


which reference or witness monuments are located in the manner following:

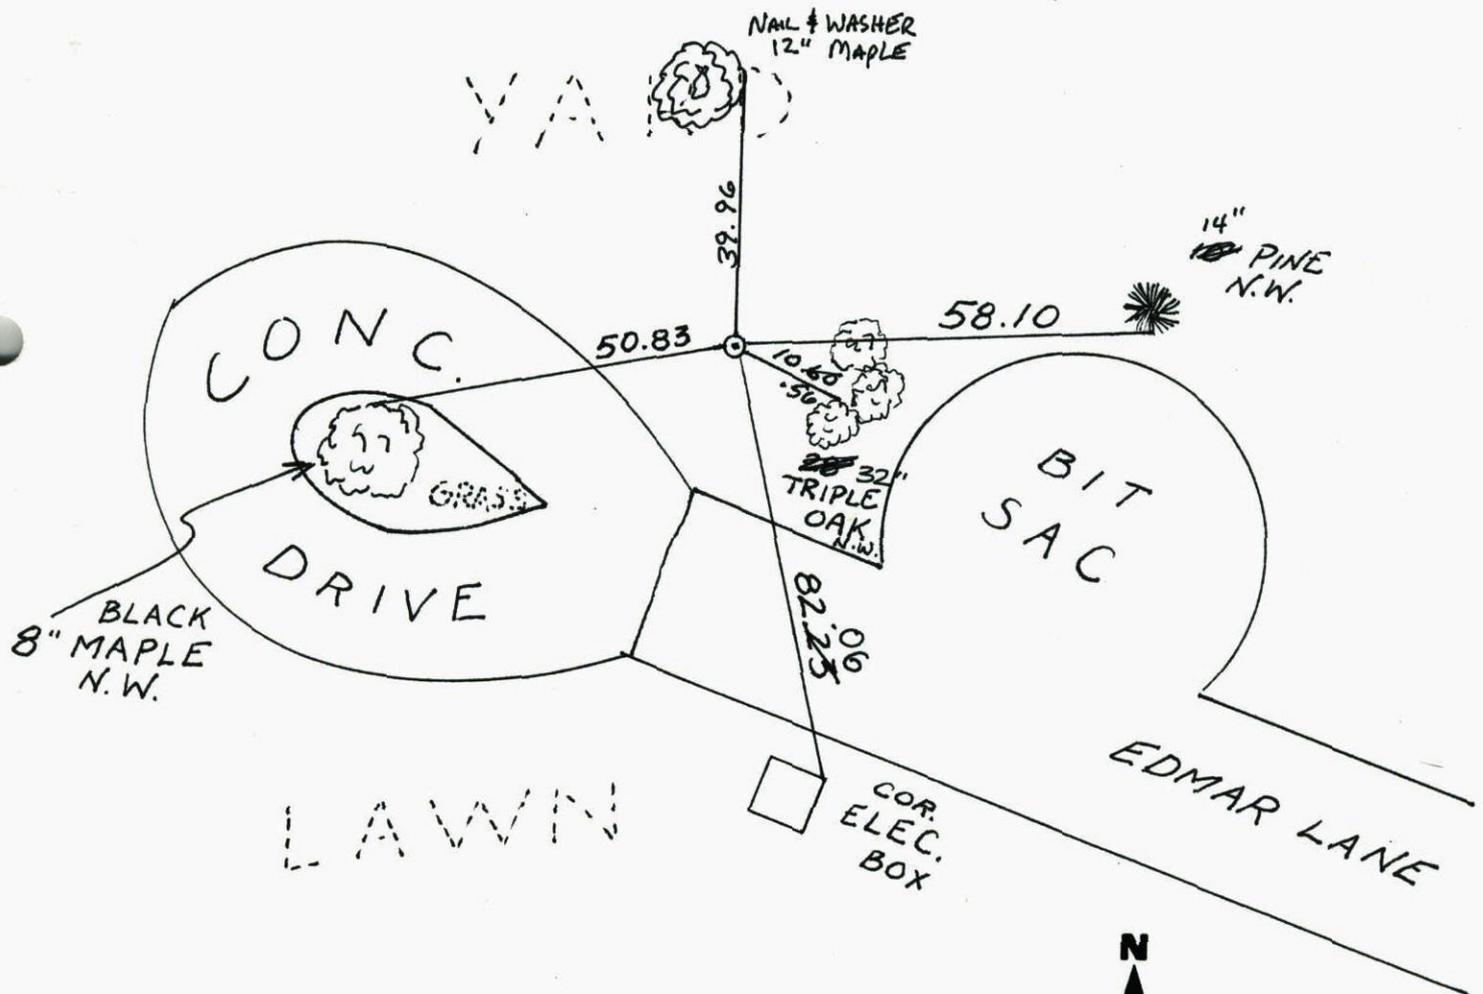

Revised date	Revised date	Revised date
6-18-84		
6-3-87		
8-17-92		
8-10-00		
6-18-02		

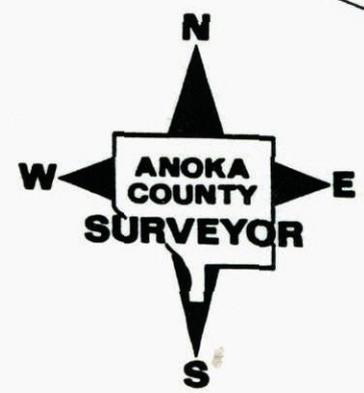

SOUTHWEST SEC. 26 T33 R23  
 RETIED CAST IRON MON

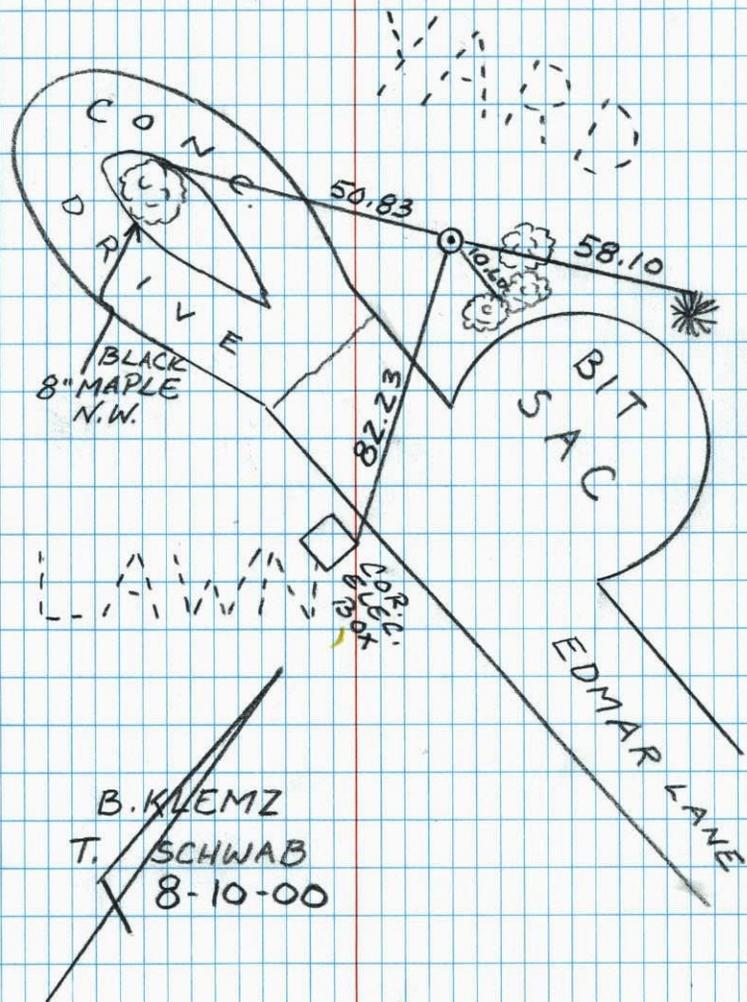


NO. 446

NATIONAL PRINTFAST

SW Cor. Sec. 26, T33, R23

Cont. Mon up .1'  
 broken off  
 Iron on South side

Tie Check  
 June 24, 1970  
 D. Powe '11  
 R. Brien  
 W. Westlander

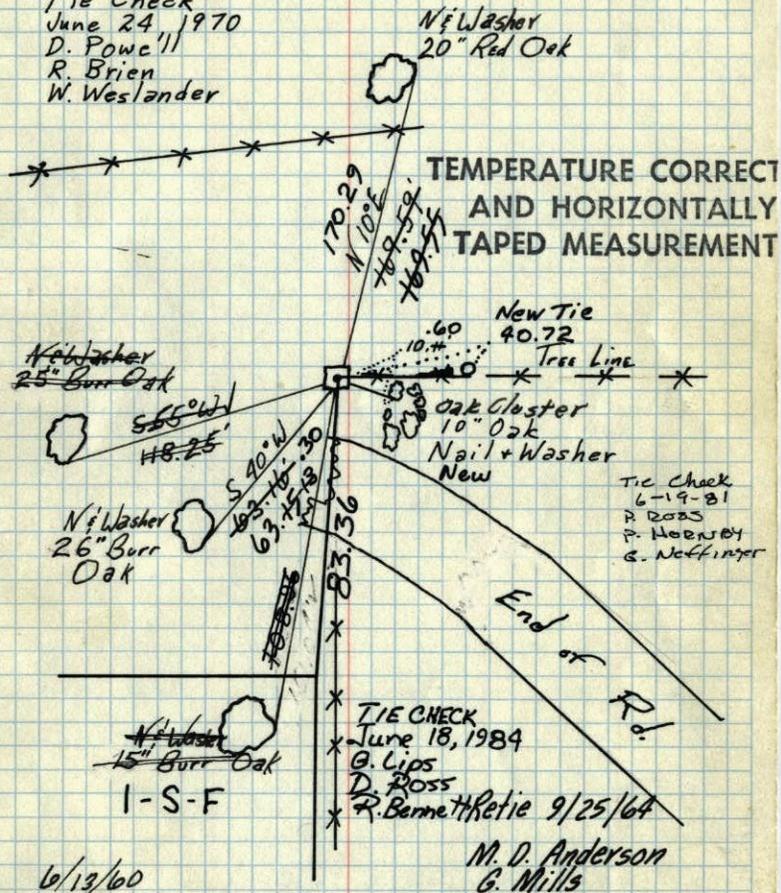

6/13/60  
 Dennis Potter  
 Ralph Robinson

ROLAND W. ANDERSON  
 COUNTY SURVEYOR  
 ANOKA COUNTY, MINNESOTA

Found conc. mon. SEX CASE  
 IRON - WARNING SIGN 1' IN  
 8-12-74  
 D. DAHL  
 G. ADAMS

90  
XX SW Cor. Sec. 26, T33, R23

Cont. Mon up .1'  
broken off  
Iron on South side

6/24/70  
#10 - 68

D. Powell  
R. Brien  
W. Westendor

N 1/2 Washer  
20" Red Oak

TEMPERATURE CORRECT  
AND HORIZONTALLY  
TAPED MEASUREMENT

N 1/2 Washer  
30" Burr Oak  
25"

N 1/2 Washer  
30" Burr Oak  
26"

New  
N 1/2 Washer  
26" Burr Oak  
15"

N 100°  
169.55'

Tree Line

Oak Cluster

End of Rd.

Retie 9/25/64

M. D. Anderson  
G. Mills

6/13/60  
Dennis Pether  
Ralph Robinson

ROLAND W. ANDERSON  
COUNTY SURVEYOR  
ANOKA COUNTY, MINNESOTA