

# CERTIFICATE OF LOCATION OF GOVERNMENT CORNER

County of Anoka

State of Minnesota

West 1/4 Corner of Sec. 32 Township 33 Range 23


On the 1st day of November, 1963, the described corner was evidenced by area resurvey

and to perpetuate the location of said corner, at the exact location thereof, a permanent marker was placed consisting of a cast iron monument SIGN & POST ON NORTH SIDE

\* ~~NEEDS NEW SIGN~~ NEEDS NEW SIGN

AND on the 27th day of March, 2003, said permanent marker was found and the ties were updated

Updated reference ties are as shown below.

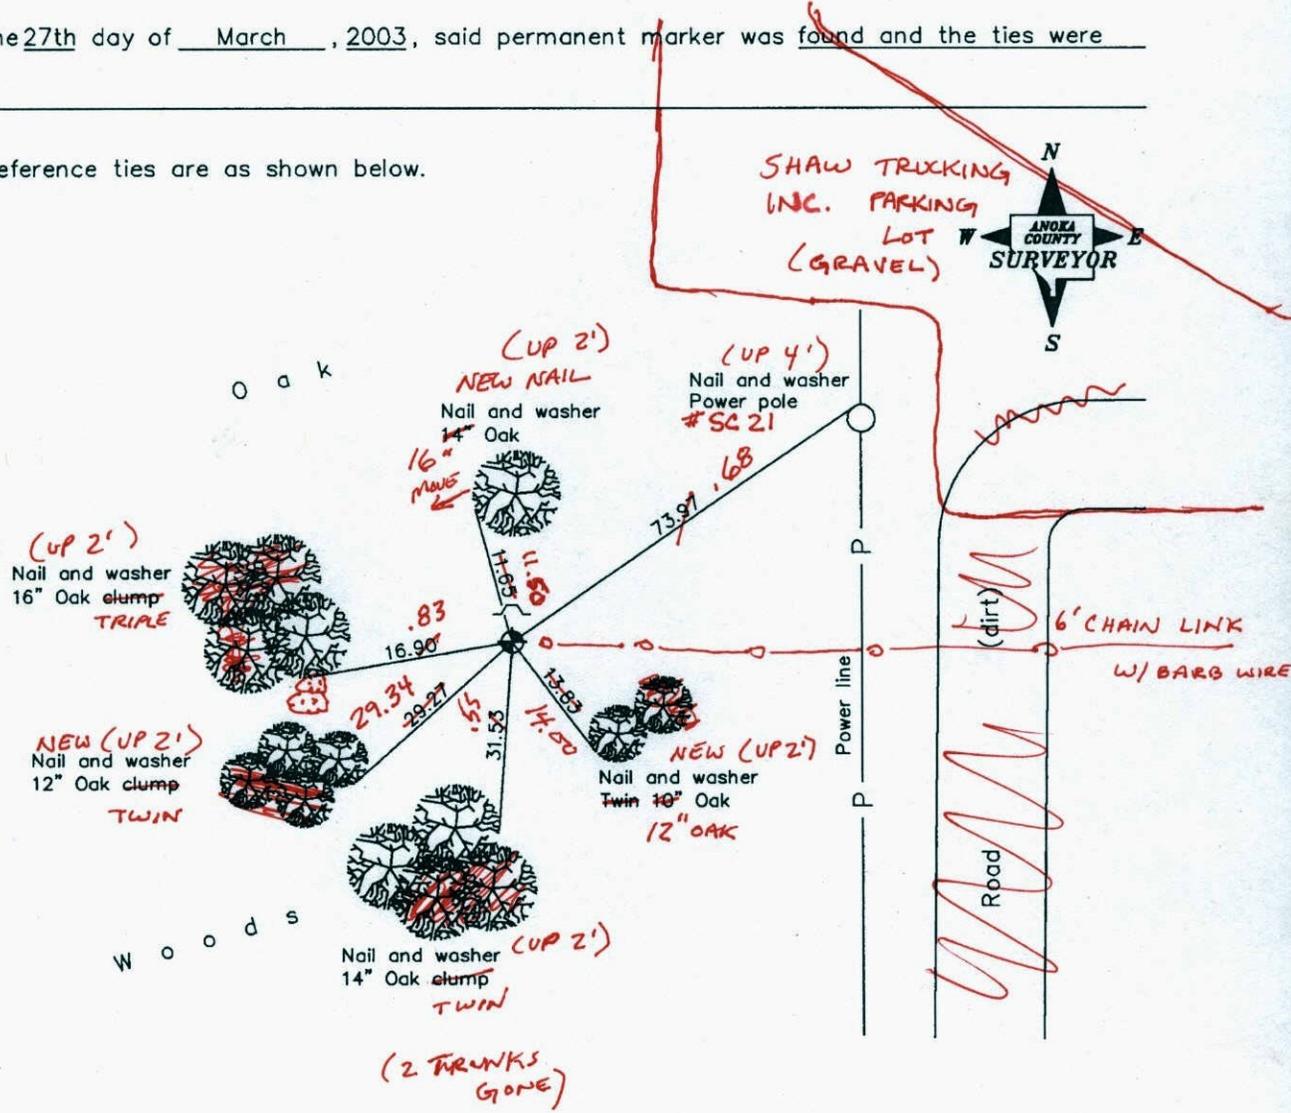

1-15-13  
BK-55  
TAPED

Revised date
11/19/87
8/24/92
3/27/03

N.A.D. 1983 Coordinates (1996 Adjustment)	
County Project Coordinates	
Northing	198455.9156
Easting	505484.5722
Date	3/27/03

I hereby certify that this United States public land survey monument record is correct and complete to the best of my knowledge and belief.

*Larry D. Hoium* Date 3/27/03  
 Larry D. Hoium, Anoka County Surveyor  
 Minnesota License Number 18165

(2 TRUNKS GONE)

# CERTIFICATE OF LOCATION OF GOVERNMENT CORNER

County of Anoka


State of Minnesota

W 1/4 CORNER Corner of Sec. 32 Township 33 Range 23

I hereby certify that on the 1 day of NOVEMBER, 1963, I found the described corner which was evidenced by RE SURVEY

and I further certify that to perpetuate the location of said corner, I did, at the exact location thereof, place a permanent marker consisting of CAST IRON

which reference or witness monuments are located in the manner following:  
CHECKED AND RETIED. SET SIGN POST ON NORTH SIDE

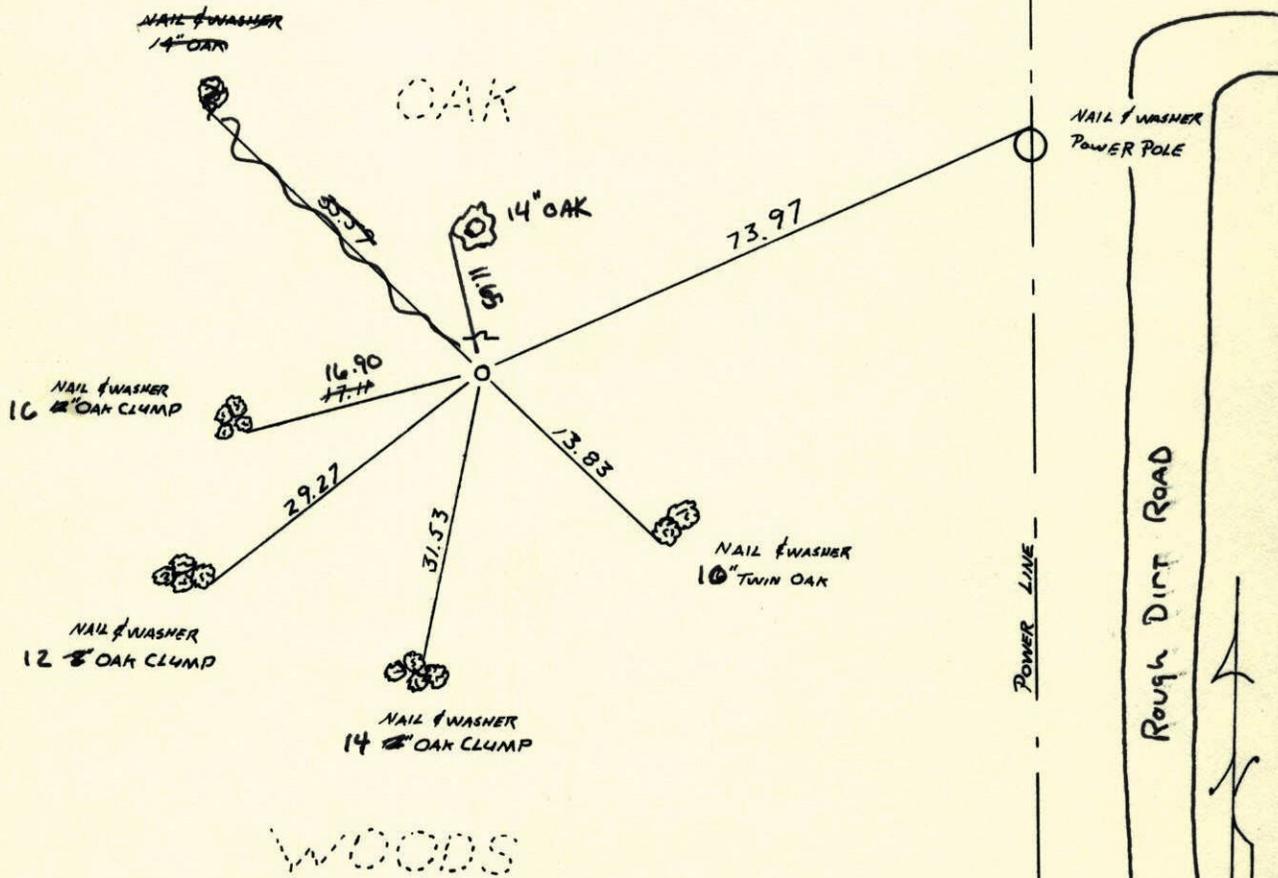

Revised date
11-19-87
8-24-92
3-27-03

By
H. LARSON
JA + T2
BK & MJ

Minnesota State Plane Coordinates  
South Zone

Y \_\_\_\_\_ X \_\_\_\_\_


County Surveyor \_\_\_\_\_ Date \_\_\_\_\_

Registered Land Surveyor No. \_\_\_\_\_

REDRAWN By J. STEVENSON

WEST 1/4 CORNER SECTION 32 T33 R23  
 CHECKED AND RETIED SIGN + POST ON  
 NORTH SIDE.

\*5 35°  
 11-19-87  
 H. LARSON  
 B. GUETZKO  
 J. STEVENSON

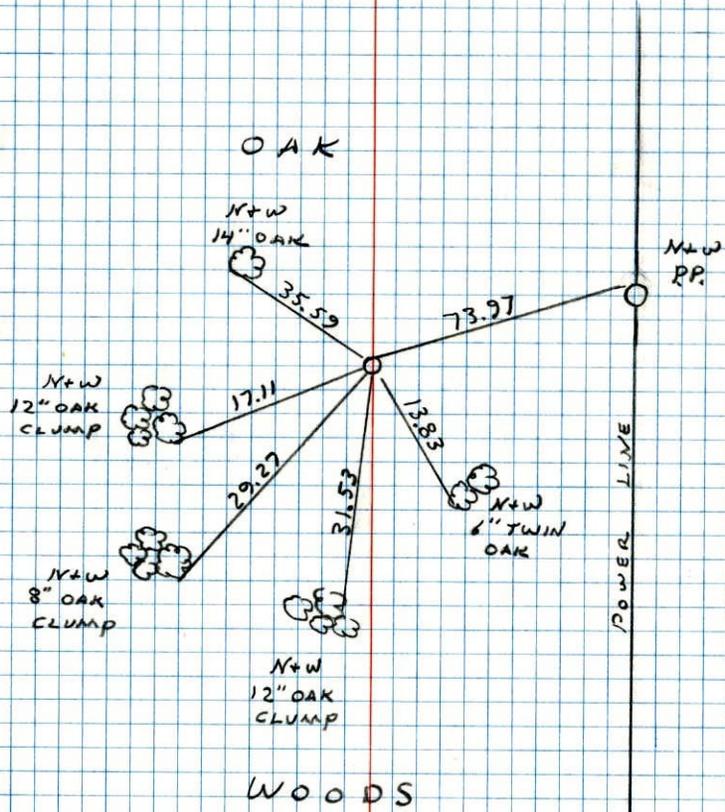


W 1/4 Cor. Sec. 32, T33, R23

Set Cast Iron Monument From Resurvey.

Nails and Washers in all tie trees.

Check in Winter

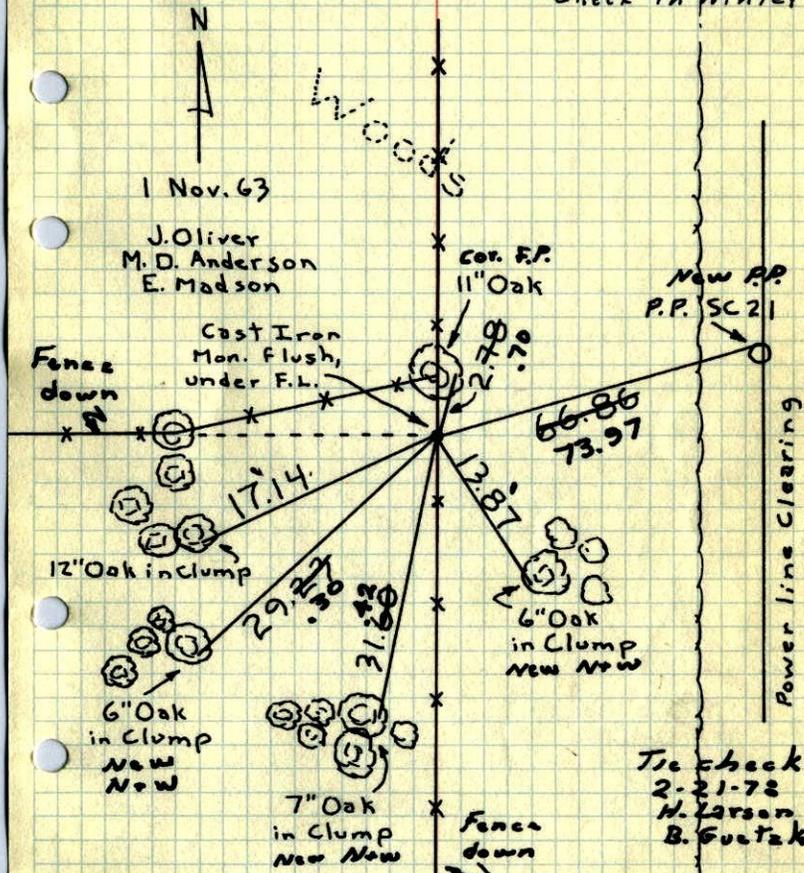

ROLAND W. ANDERSON  
 COUNTY SURVEYOR  
 ANOKA COUNTY, MINNESOTA

TEMPERATURE CORRECTED  
 AND HORIZONTALLY  
 TAPED MEASUREMENTS

W 1/4 Cor. Sec. 32, T33, R23

Set Cast Iron Monument From Resurvey

1 Nov. 63  
430 #2  
J. Oliver  
M.D. Anderson  
E. Midson

C.I. Mon.  
Flush under  
Fence line

N+win  
P.P. SC 21

N+win  
12" Oak  
in Clump

N+win  
11" Oak

17.14

2.18  
66.86  
+01 -01

29.23

13.87

+01 -01  
31.60

N+win  
6" Oak  
in Clump

N+win  
6" Oak  
in Clump

N+win  
7" Oak  
in Clump

Power Line Clearing

Woods

