

CERTIFICATE OF LOCATION OF GOVERNMENT CORNER

County of Anoka

State of Minnesota


Meander Corner of Sec. 35 Township 33 Range 23
 (Meander Cor. No. 15—On west line of section)

On the 20th day of January, 1961, the described corner was evidenced by a 1 1/2" iron pipe

and to perpetuate the location of said corner, at the exact location thereof, a permanent marker was placed consisting of a cast iron monument

AND on the ___ day of _____, _____, said permanent marker was _____

Updated reference ties are as shown below.

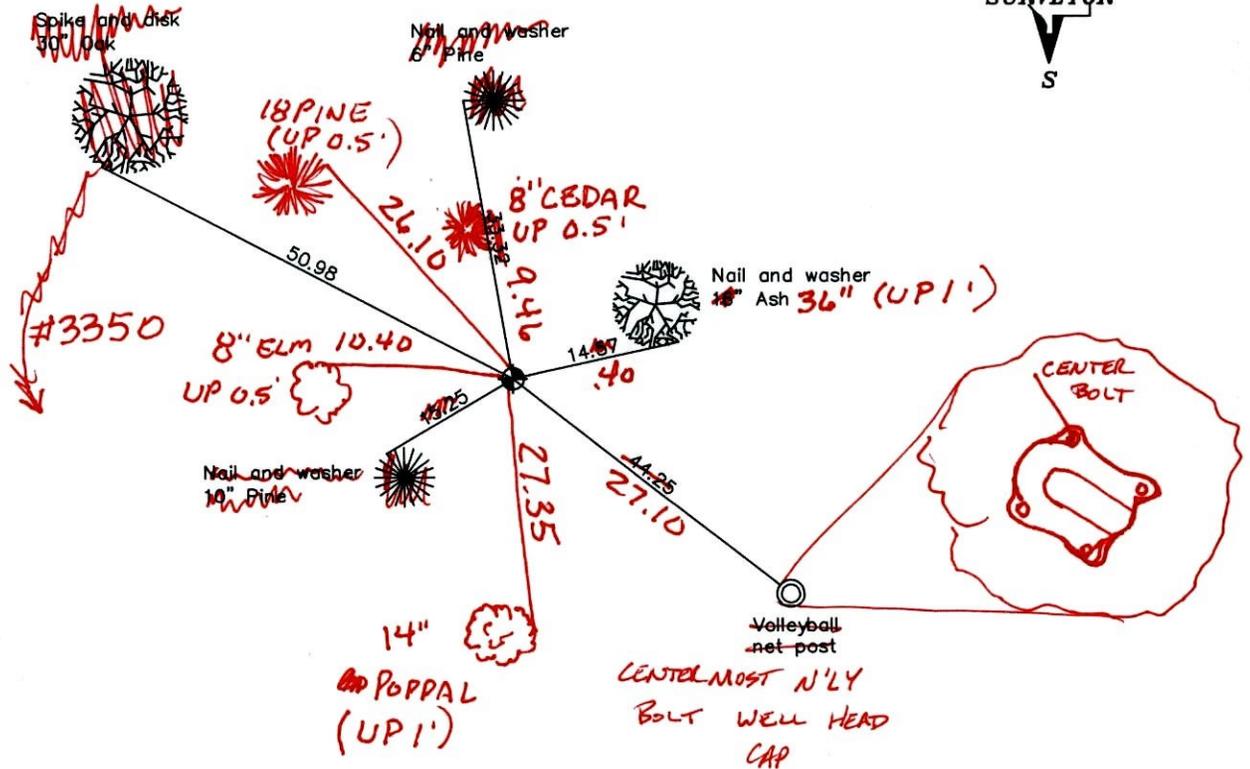

BK-SH
4-4-13
 TAPED
 NO VRS
 WOODED

Revised date
6/04/87
8/18/92
8/18/97

N.A.D. 1983 Coordinates (1996 Adjustment)
County Project Coordinates
Northing <u>196885.4544</u>
Easting <u>521318.5335</u>
Date <u>3/18/03</u>

I hereby certify that this United States public land survey monument record is correct and complete to the best of my knowledge and belief.

_____ Date _____
 _____, Anoka County Surveyor
 Minnesota License Number _____

CERTIFICATE OF LOCATION OF GOVERNMENT CORNER

County of Anoka


State of Minnesota

MEANDER ^{*15} Corner of Sec. 35 Township 33 Range 23
ON WEST LINE


I hereby certify that on the 20 day of JAN, 19 61, I found the described corner which was evidenced by 1 1/2" IRON PIPE

and I further certify that to perpetuate the location of said corner, I did, at the exact location thereof, place a permanent marker consisting of CAST IRON MONUMENT

which reference or witness monuments are located in the manner following:

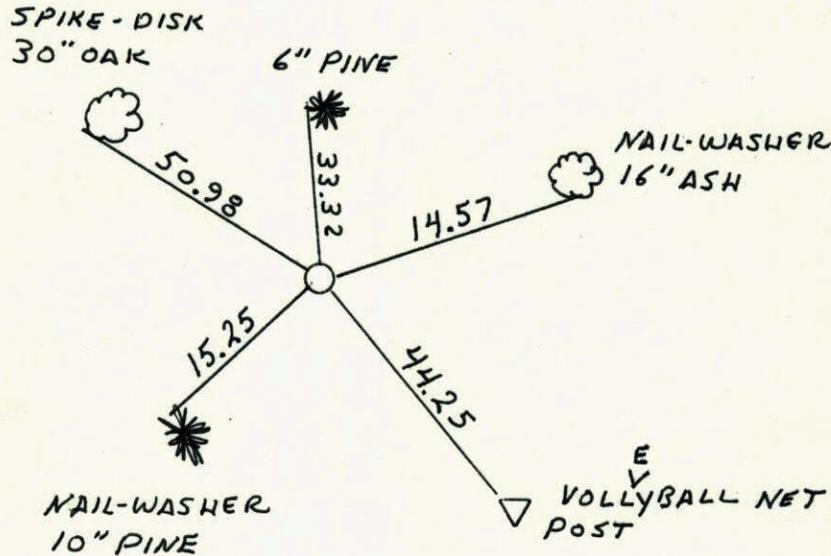

Revised date	Revised date	Revised date
6-4-87		
8-18-92		
" " 97		

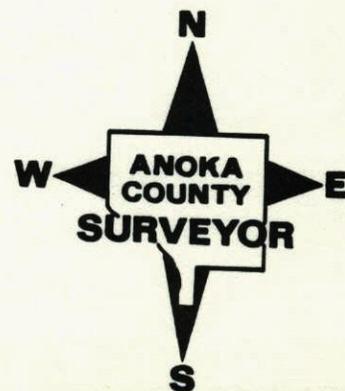

M.C. #5 on W. Line of SEC. 35-33-23

Found 1 1/2" iron down 0.5' 4.0' h

Iron beside

ALL TIES ARE SPIKES + DISCS.

TIE CHECK
July 9, 1984
D. ROSS
C. Ljos
R. Bennett

CAST IRON MONUMENT

Tie Check
6-19-81
P. ROSS
P. Hornley
G. Nelson

30' W. OAK
Spike + Disc

1" Scotch
PINE

16" Ash
Spike + Disc
New Nail & Washer

145.74

105.26
Set CAST IRON IN PLACE
(FLUSH)
8-14-74
R. FARMER
D. DAHL

Nail & WASHER
7" Pine

Volleyball
net post

8" poplar
Spike + Disc

Retie 6-9-65
M.D. Anderson
John Dunlap

TEMPERATURE CORRECTED
AND HORIZONTALLY
TAPED MEASUREMENTS

8" Poplar
Spike + Disc
New Nail & Washer

1-20-61
FREEMAN - ANDERSON
Temp. Cor +3

COON LAKE


ROLAND W. ANDERSON
COUNTY SURVEYOR
ANOKA COUNTY, MINNESOTA

M.C. #5 on W. Line of SEC. 35-33-23

Found 1 1/2" iron down 0.5' ~~4.0' h~~

IRON beside

ALL TIES ARE SPIKES + DISCS.

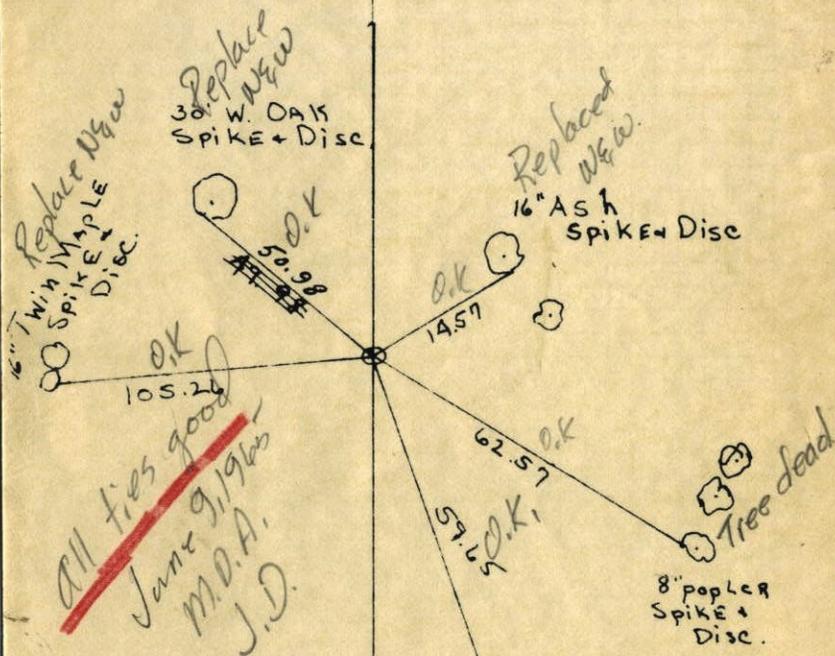

TEMPERATURE CORRECTED
AND HORIZONTALLY
TAPED MEASUREMENTS

entered

