

# CERTIFICATE OF LOCATION OF GOVERNMENT CORNER

County of Anoka

State of Minnesota


North 1/4 Corner of Sec. 5 Township 33 Range 23

On the 14th day of July, 1967, the described corner was evidenced by an iron pipe

and to perpetuate the location of said corner, at the exact location thereof, a permanent marker was placed consisting of a cast iron monument (Mon. 6' ± FROM N. EDGE BIT.)

AND on the 20th day of May, 2002, said permanent marker was found and the ties were updated

Updated reference ties are as shown below.

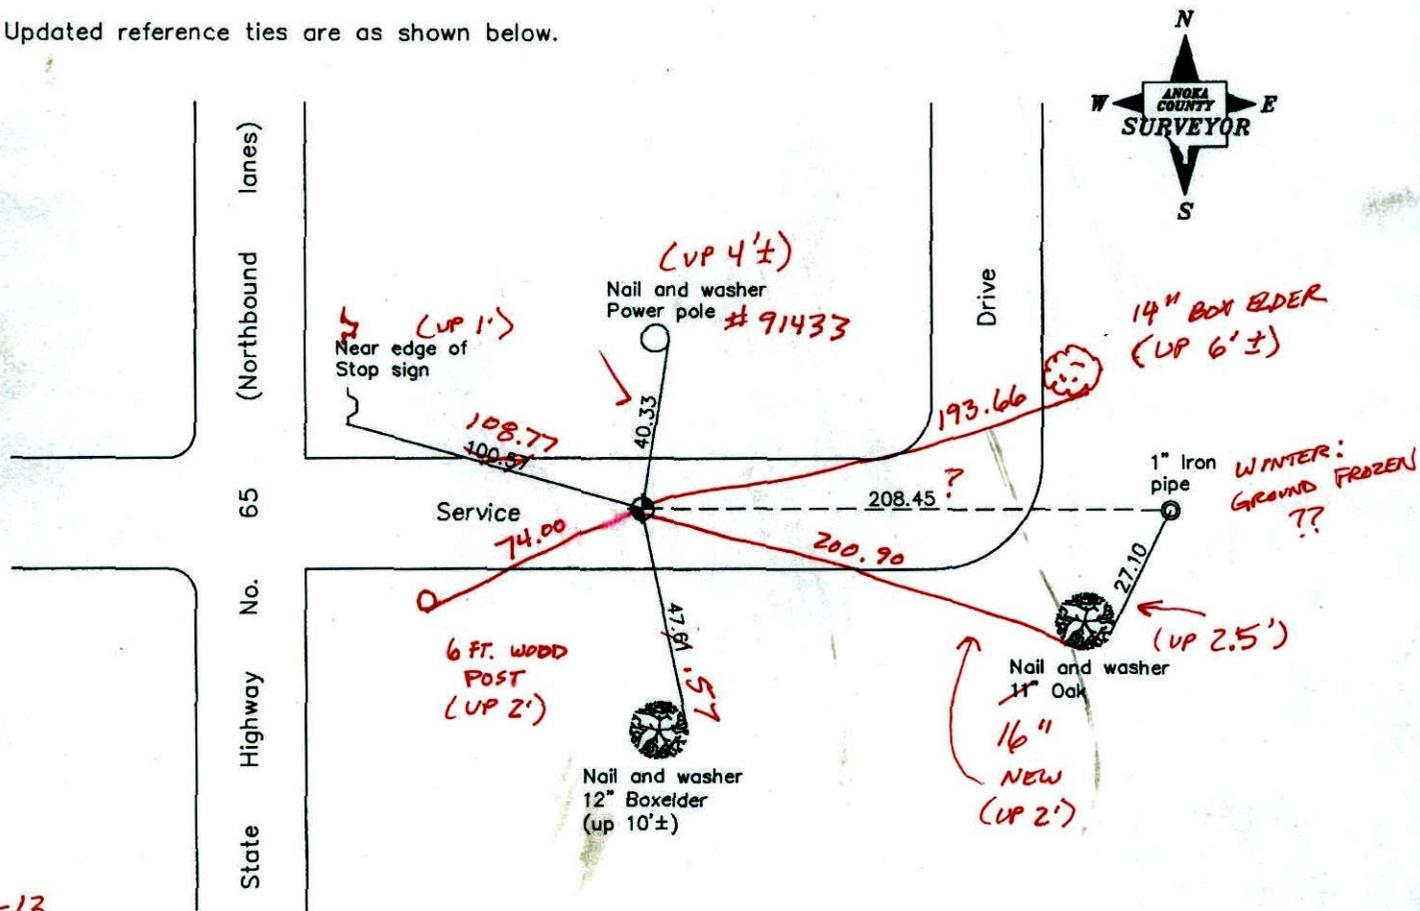

1-18-13  
BK-55  
T/H VRS

|              |
|--------------|
| Revised date |
| 8/26/92      |
| 8/03/00      |
| 5/20/02      |
|              |
|              |

|  |             |
|--|-------------|
| N.A.D. 1983 Coordinates<br>(1996 Adjustment) |             |
| County Project Coordinates                   |             |
| Northing                                     | 227442.5257 |
| Easting                                      | 508335.8710 |
| Date   | 5/20/02     |

I hereby certify that this United States public land survey monument record is correct and complete to the best of my knowledge and belief.

*Larry D. Hoium* Date 5/20/02

Larry D. Hoium, Anoka County Surveyor

Minnesota License Number 18165

3DQ = 0.04      N = 227442.5189      E = 508335.8284


# CERTIFICATE OF LOCATION OF GOVERNMENT CORNER

NORTH *County of Anoka* *State of Minnesota* 33  
SOUTH QTR. Corner of Sec. 32 Township 34 Range 23


I hereby certify that on the 14 day of JULY, 1967, I found the described corner which was evidenced by I.P.

and I further certify that to perpetuate the location of said corner, I did, at the exact location thereof, place a permanent marker consisting of CAST IRON

which reference or witness monuments are located in the manner following:

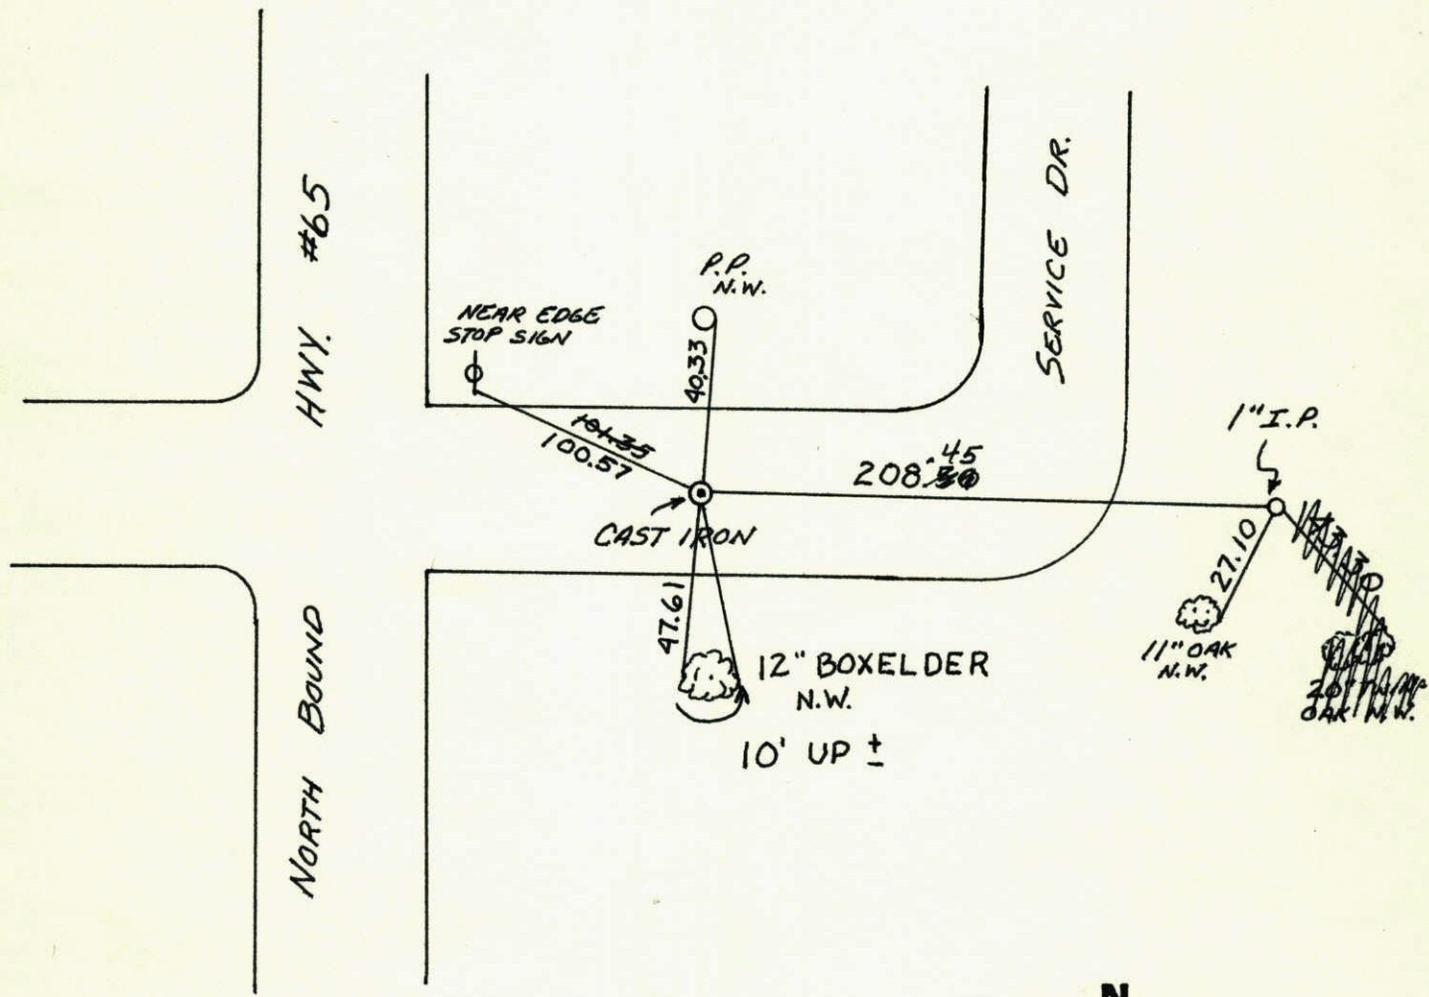

| Revised date | Revised date | Revised date |
|--------------|--------------|--------------|
| 8-12-86      |              |              |
| 8-26-92      |              |              |
| 8-3-00       |              |              |
| 5-20-02      |              |              |
|              |              |              |
|              |              |              |
|              |              |              |

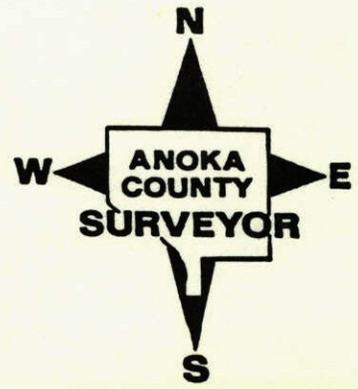

N<sup>1</sup>/<sub>4</sub>  
~~S<sup>1</sup>/<sub>4</sub>~~ Cor. Sec. ~~32~~<sup>5</sup>, T 33, R 23

2-19-54 Bill Radcheck

