Page No. 122

CERTIFICATE OF LOCATION OF GOVERNMENT CORNER

County of Anoka State of Minnesota

East 1/4 Corner of Sec. 12 Township 33 Range 23

On the 30th day of September, 1963, the described corner was evidenced by 1960 ties

and to perpetuate the location of said corner, at the exact location thereof, a permanent marker was placed consisting of a cast iron monument MON. 5'± NORTH OF ℄

AND on the ___ day of _____, ____, said permanent marker was _____

Updated reference ties are as shown below.

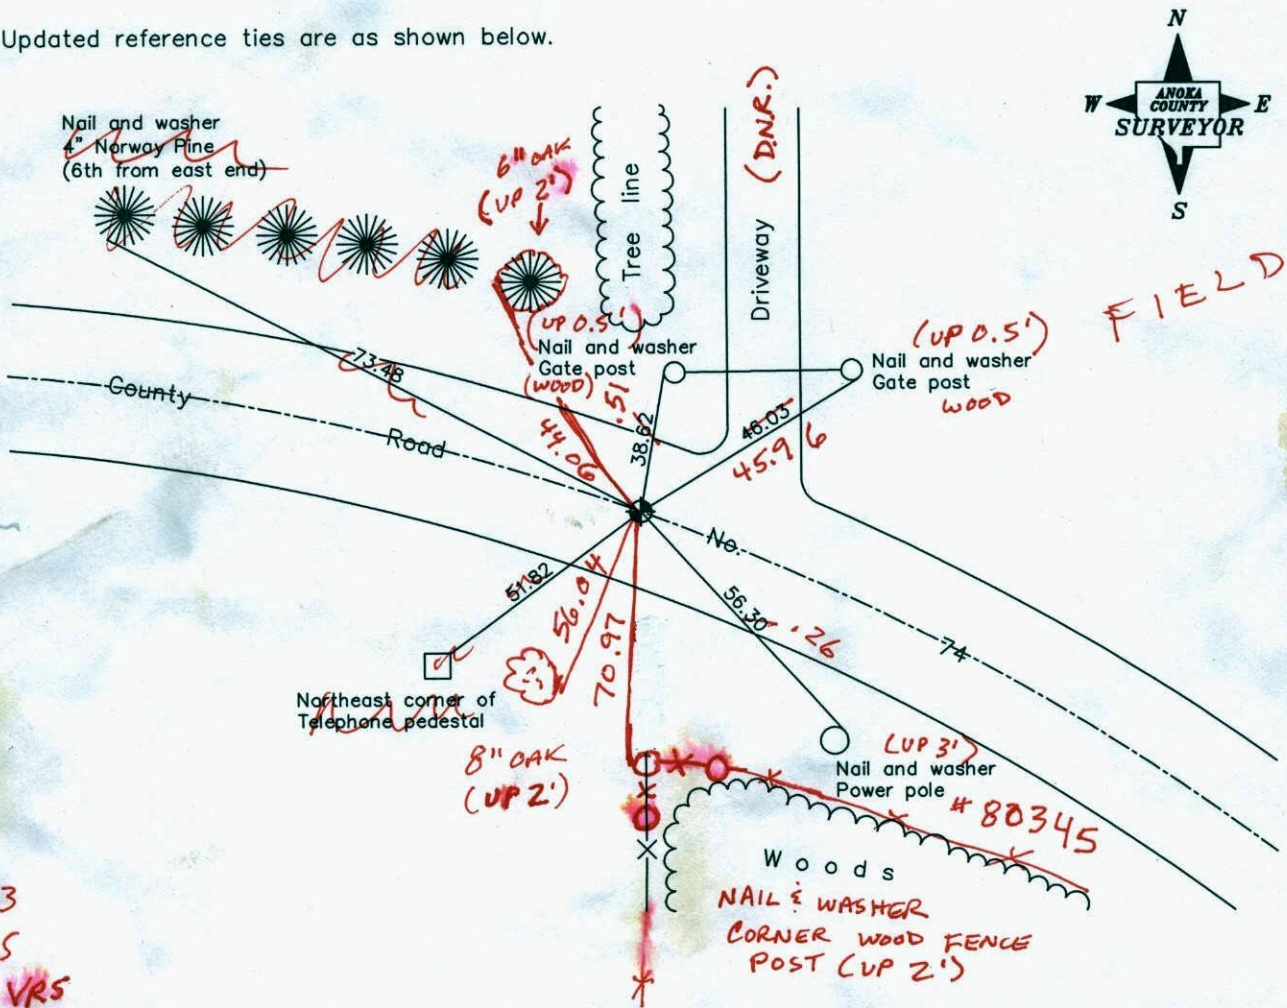

1-29-13
BK-55
T/T-VRS

Revised date

10/18/90
6/16/93
8/11/97

N.A.D. 1983 Coordinates
(1996 Adjustment)

County Project Coordinates	
Northing	219395.0542
Easting	531580.2993
Date	5/08/02

I hereby certify that this United States public land survey monument record is correct and complete to the best of my knowledge and belief.

_____ Date _____

_____, Anoka County Surveyor

Minnesota License Number _____

VRS 3DQ = 0.05 N = 219395.0930 E = 531580.2478

CERTIFICATE OF LOCATION OF GOVERNMENT CORNER

County of Anoka State of Minnesota

EAST ~~WEST~~ QTR. Corner of Sec. 17 Township 33 Range 23 ~~22~~

I hereby certify that on the 30 day of SEPTEMBER, 1963, I found the described corner which was evidenced by 1960 TIES

and I further certify that to perpetuate the location of said corner, I did, at the exact location thereof, place a permanent marker consisting of CAST IRON

which reference or witness monuments are located in the manner following:

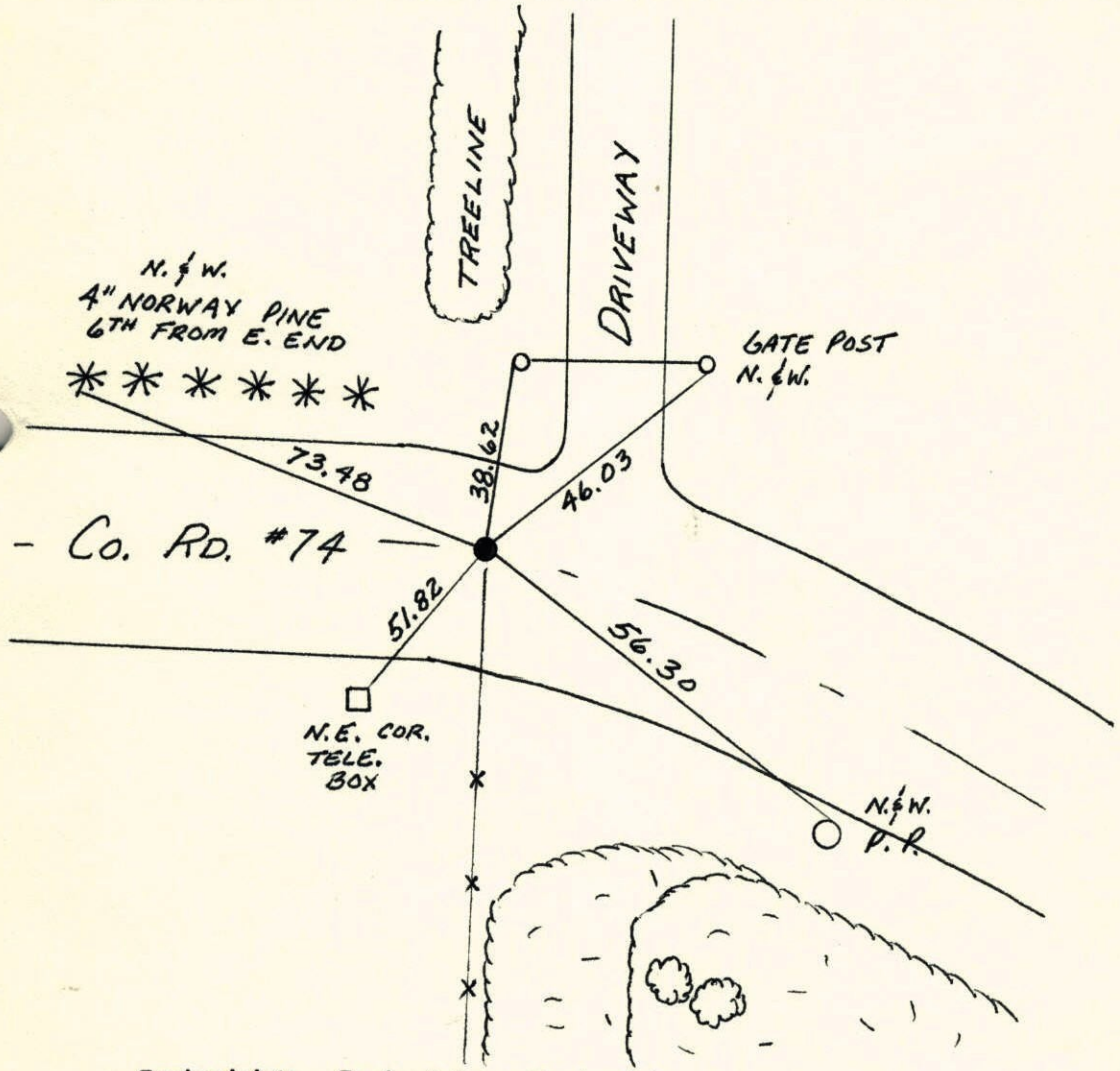
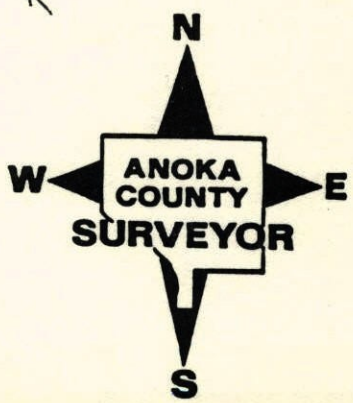
Revised date	Revised date	Revised date
10-18-90		
6-16-93		
8-11-97