

CERTIFICATE OF LOCATION OF GOVERNMENT CORNER

County of Anoka State of Minnesota



Witness Corner of Sec. 24 Township 33 Range 23
 (On east line of NE 1/4)

On the 5th day of November, 1970, the described corner was evidenced by area resurvey

and to perpetuate the location of said corner, at the exact location thereof, a permanent marker was placed consisting of a cast iron monument with a sign and post on the north side

AND on the ___ day of _____, _____, said permanent marker was _____

Updated reference ties are as shown below.

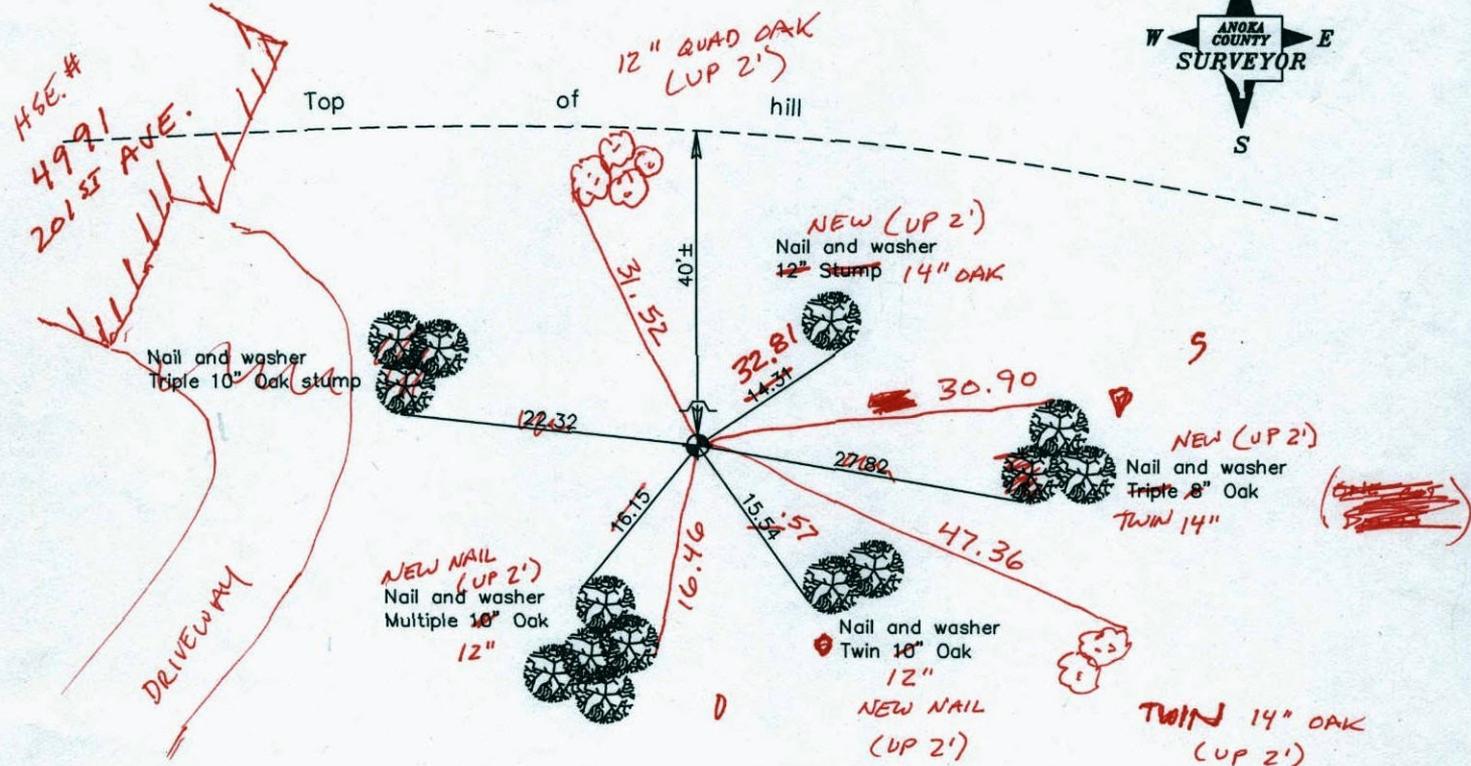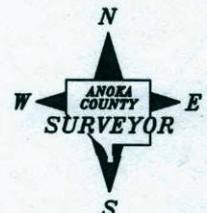

1-14-13
BK-SS
T/T

Revised date
6/13/87
7/14/93

N.A.D. 1983 Coordinates (1996 Adjustment)	
County Project Coordinates	
Northing	209107.5817
Easting	531824.8166
Date	3/13/03

I hereby certify that this United States public land survey monument record is correct and complete to the best of my knowledge and belief.

Date _____

_____, Anoka County Surveyor

Minnesota License Number _____

CERTIFICATE OF LOCATION OF GOVERNMENT CORNER

County of Anoka


State of Minnesota

W.C. ON EAST Corner of Sec. 24 Township 33 Range 23
LINE OF N.E. QTR.

I hereby certify that on the 5 day of Nov., 19 70, I found the described corner which was evidenced by AREA RESURVEY

and I further certify that to perpetuate the location of said corner, I did, at the exact location thereof, place a permanent marker consisting of CAST IRON, SIGN AND POST
ON NORTH SIDE

which reference or witness monuments are located in the manner following:

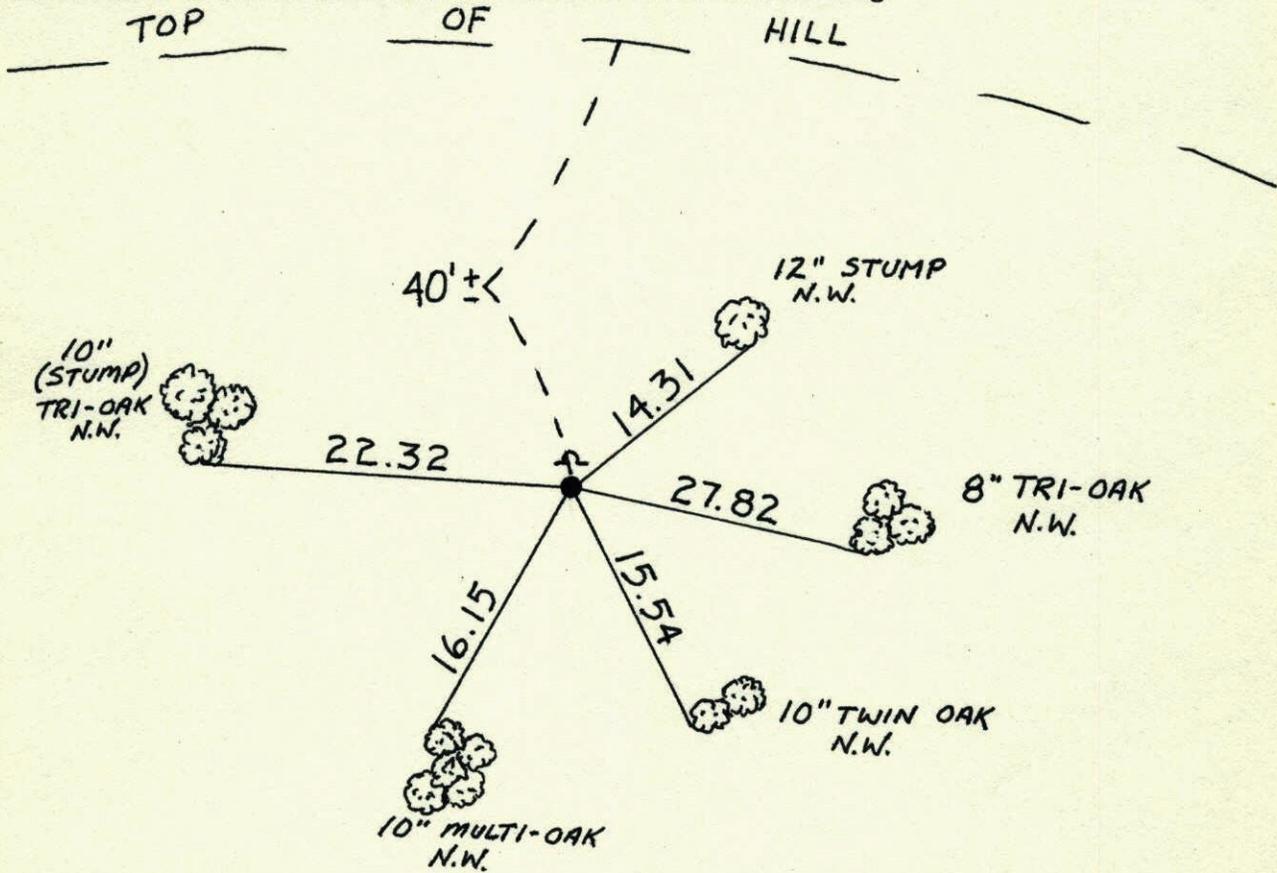

Revised date	Revised date	Revised date
6-13-87		
7-14-93		

