

CERTIFICATE OF LOCATION OF GOVERNMENT CORNER

County of Anoka

State of Minnesota

East 1/4 Corner of Sec. 2 Township 33 Range 23


On the 8th day of November, 1963, the described corner was evidenced by area resurvey

and to perpetuate the location of said corner, at the exact location thereof, a permanent marker was placed consisting of a cast iron monument (3' E. OF E)

AND on the 26th day of March, 2002, said permanent marker was found and the ties were updated

Updated reference ties are as shown below.

5/15/13
BK-SH
T/T AND VRS
LOOSENED AND
PAINTED FOR
OVERLAY.

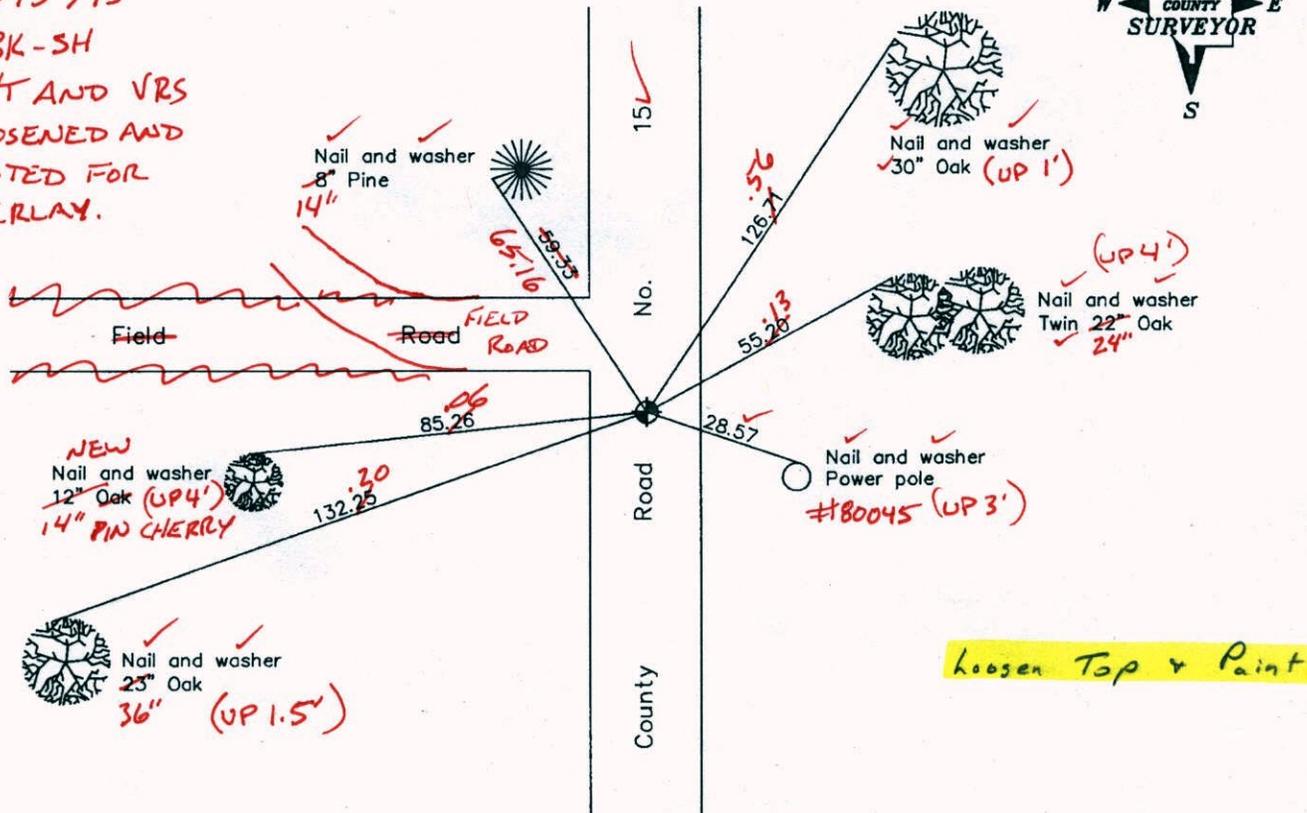

Revised date

8/04/92
8/11/97
3/26/02

N.A.D. 1983 Coordinates
 (1996 Adjustment)

County Project Coordinates	
Northing	<u>224759.5045</u>
Easting	<u>526452.4403</u>
Date	<u>3/26/02</u>

I hereby certify that this United States public land survey monument record is correct and complete to the best of my knowledge and belief.

Larry D. Hoium Date 3/26/02
 Larry D. Hoium, Anoka County Surveyor
 Minnesota License Number 18165

VRS 3D QUAL: 0.04

N: 224759.5336 E: 526452.3623

CERTIFICATE OF LOCATION OF GOVERNMENT CORNER

County of Anoka

State of Minnesota


East 1/4 Corner of Sec. 2 Township 33 Range 23

On the 8th day of November, 1963, the described corner was evidenced by area resurvey

and to perpetuate the location of said corner, at the exact location thereof, a permanent marker was placed consisting of a cast iron monument

AND on the 23rd day of April, 2012, said permanent marker was found and the ties were updated

Updated reference ties are as shown below.

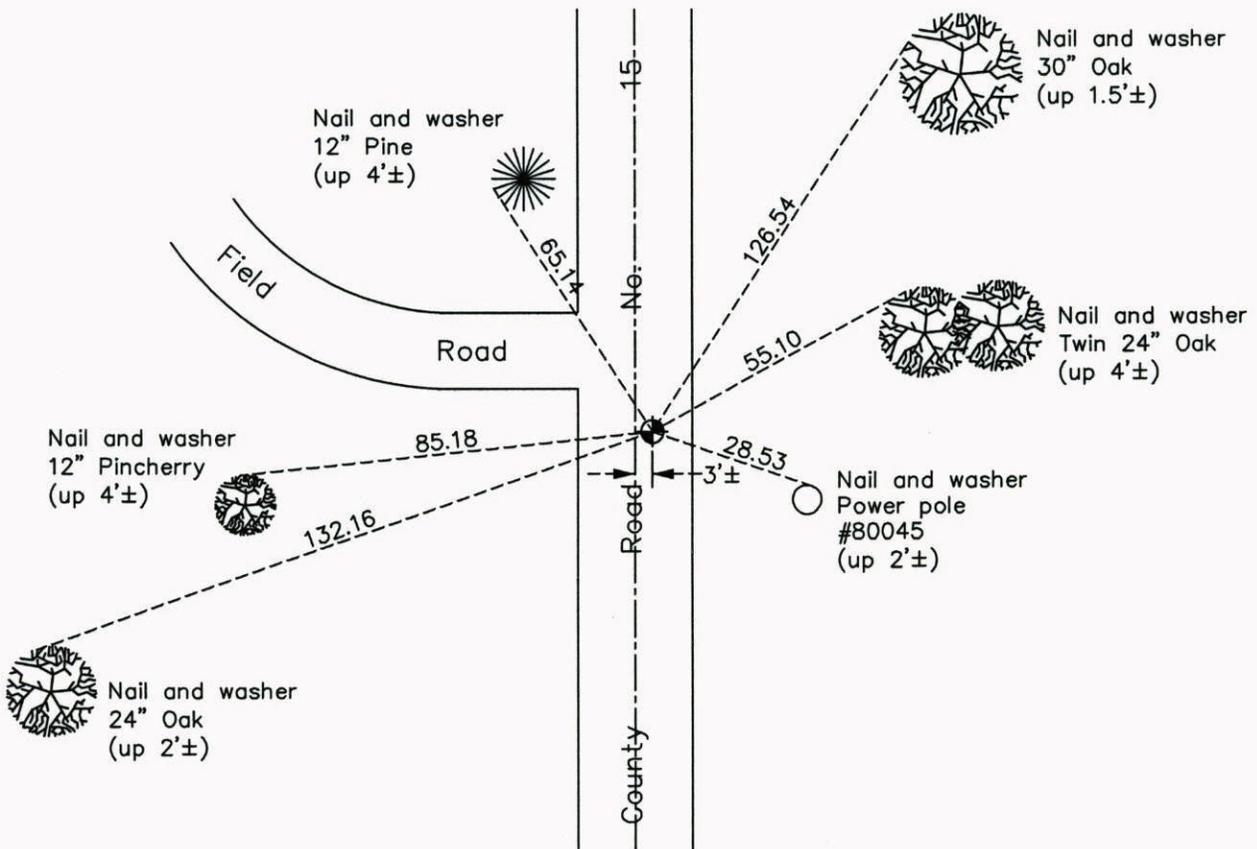

ANOKA COUNTY
SURVEYOR

Revision Date

4/17/13

N.A.D. 1983 Coordinates
(1996 Adjustment)

County Project Coordinates	
Northing	224759.5045
Easting	526452.4403
Date	3/26/02

I hereby certify that this United States public land survey monument record is correct and complete to the best of my knowledge and belief.

Larry D. Hoium Date 4/17/13

Larry D. Hoium, Anoka County Surveyor

Minnesota License Number 18165

CERTIFICATE OF LOCATION OF GOVERNMENT CORNER

County of Anoka State of Minnesota


East 1/4 Corner of Sec. 2 Township 33 Range 23

On the 8th day of November, 1963, the described corner was evidenced by area resurvey

and to perpetuate the location of said corner, at the exact location thereof, a permanent marker was placed consisting of a cast iron monument (MON. 3'± E. OF E)

AND on the 26th day of March, 2002, said permanent marker was found and the ties were updated

Updated reference ties are as shown below.

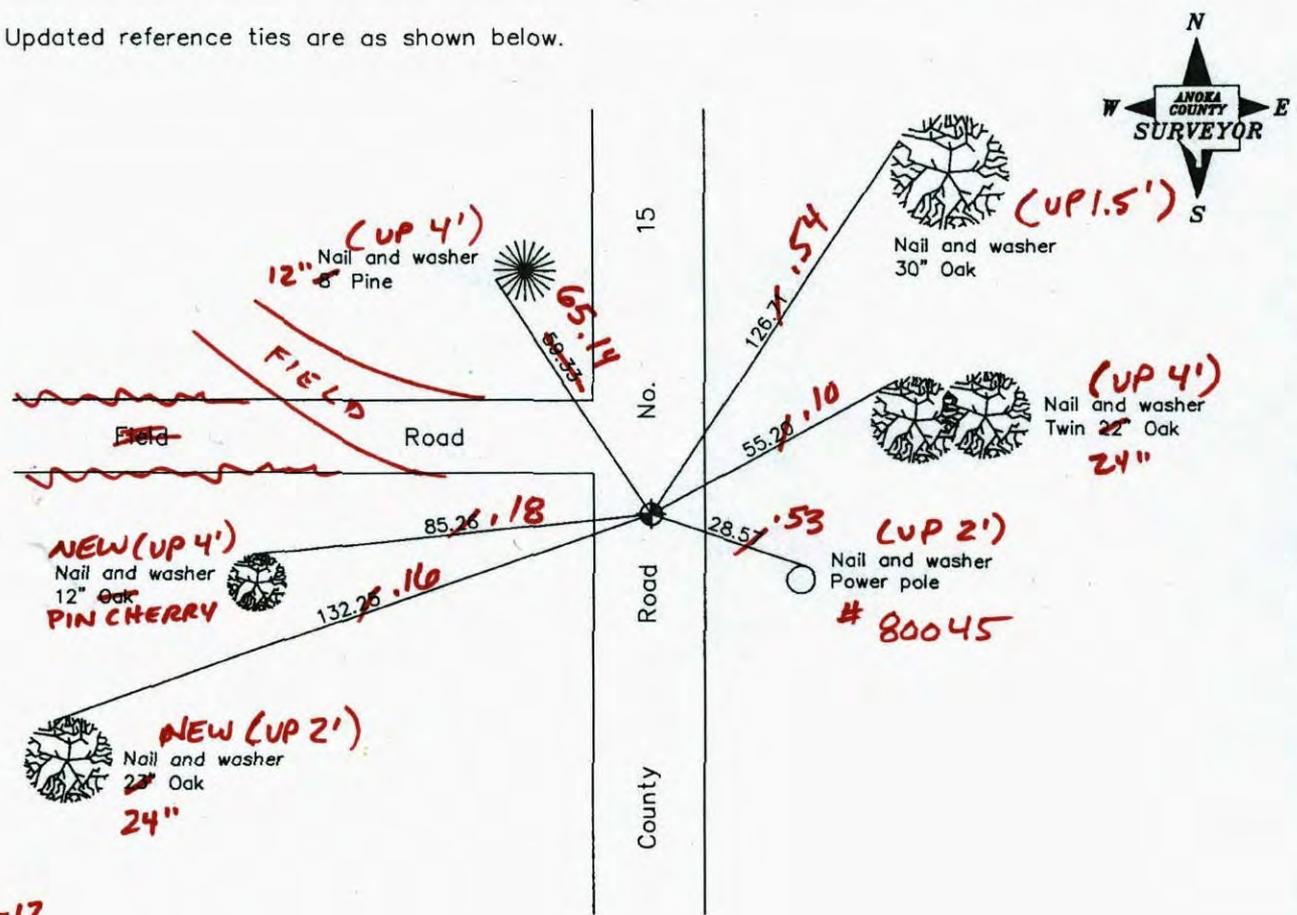

4-23-12
BK-SS
T/T - VRS

Revised date
8/04/92
8/11/97
3/26/02

N.A.D. 1983 Coordinates (1996 Adjustment)	
County Project Coordinates	
Northing	<u>224759.5045</u>
Easting	<u>526452.4403</u>
Date	<u>3/26/02</u>

I hereby certify that this United States public land survey monument record is correct and complete to the best of my knowledge and belief.

Larry D. Hoium Date 3/26/02

Larry D. Hoium, Anoka County Surveyor

Minnesota License Number 18165

VRS 30 = 0.05 N = 224759.5580 E = 526452.4018

CERTIFICATE OF LOCATION OF GOVERNMENT CORNER

County of Anoka


State of Minnesota

EAST 1/4 Corner of Sec. 2 Township 33 Range 23


I hereby certify that on the 8th day of NOV., 19 63, I found the described corner which was evidenced by AREA RESURVEY

and I further certify that to perpetuate the location of said corner, I did, at the exact location thereof, place a permanent marker consisting of CAST IRON MONUMENT


which reference or witness monuments are located in the manner following:

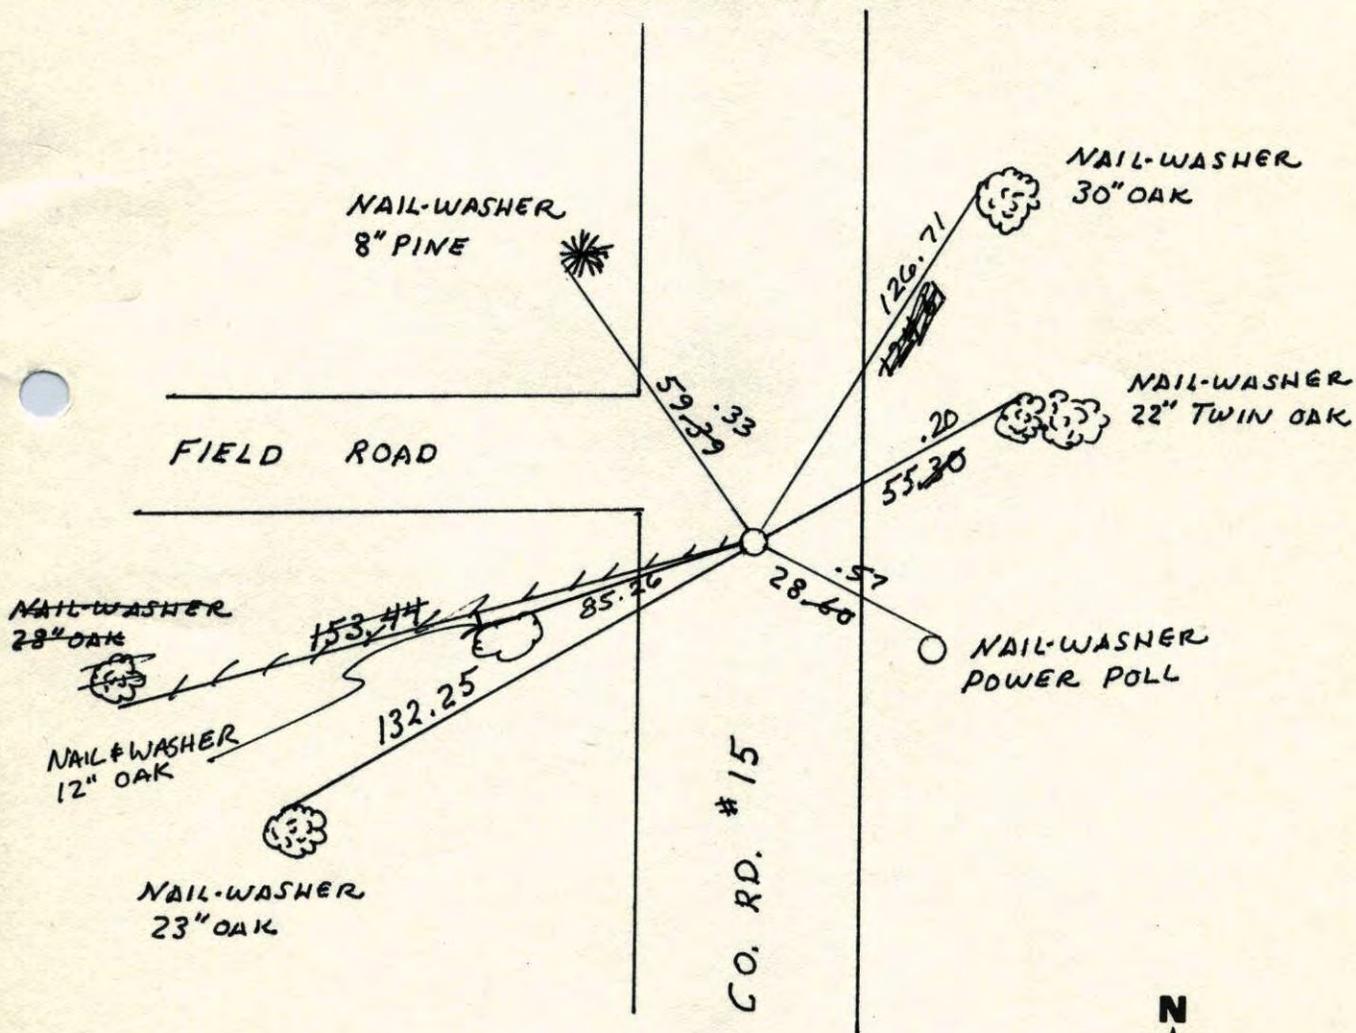

Revised date	Revised date	Revised date
8-21-86		
8-4-92		
8-11-97		
3-26-02		

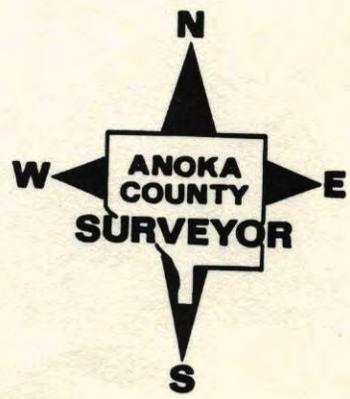

E 1/4 Cor. Sec. 2-33-23
 Set 1/2" IRON PIPE DOWN 0.2'
 SET FROM COUNTY SURVEY
 REPLACE IRON PIPE WITH
 CAST IRON MONUMENT

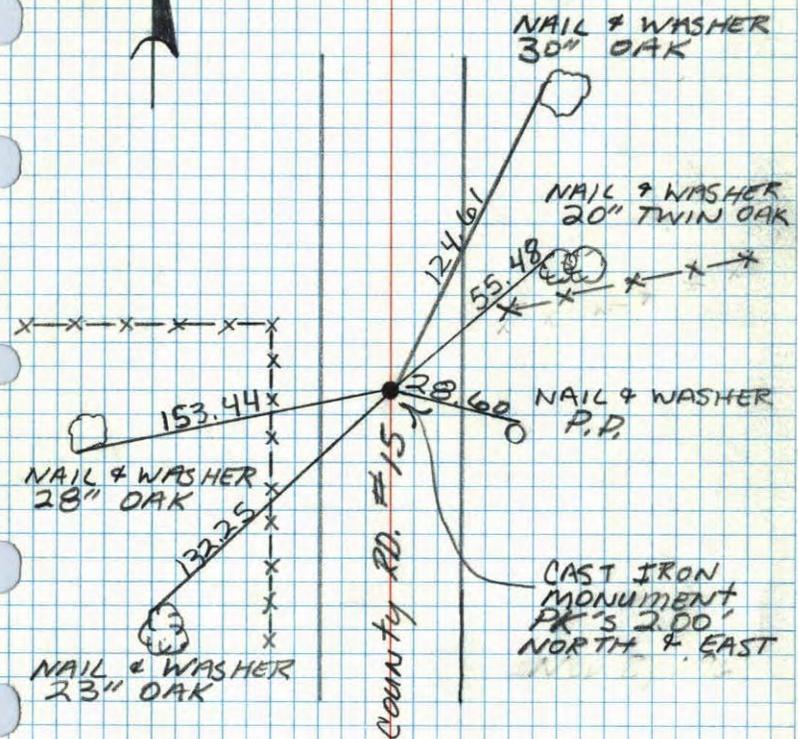


NO. 448 TELEPHONE

TIE CHECK
 6-12-84
 D. ROSS
 C. LIPS
 R. BENNETT
 75° #200

E 1/4 Cor. Sec. 2-33-23

Set 1/2" Iron pipe down 0.2'
 Set from County Resurvey
 Replace iron pipe with Cast Iron Mon.

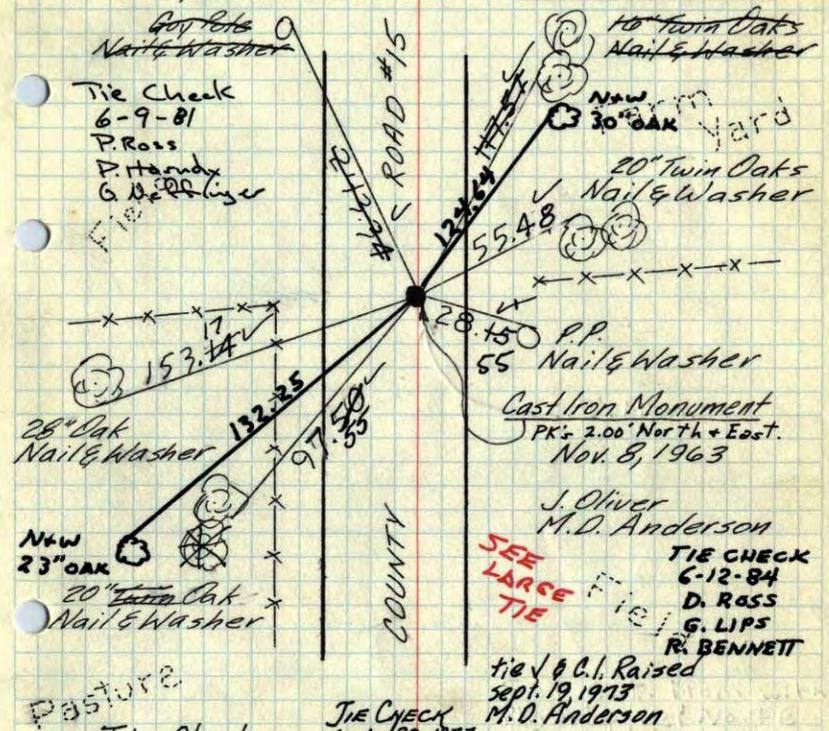

Tie Check
 June 16, 1970
 D. Powell
 R. Brien
 W. Westlander

TIE CHECK 7-23-74
 R. FARMER
 N. DAHL
 D. DAHL

tie & C.I. Raised
 Sept. 19, 1973
 M. O. Anderson

Set Cast Iron Mon.
 Aug. 3, 1964
 Oliver
 Livgard
 Dunlap

TEMPERATURE CORRECTED
 AND HORIZONTALLY
 TAPED MEASUREMENTS

ROLAND W. ANDERSON
 COUNTY SURVEYOR
 ANOKA COUNTY, MINNESOTA

