Page No. 24

CERTIFICATE OF LOCATION OF GOVERNMENT CORNER

County of Anoka State of Minnesota

North 1/4 Corner of Sec. 9 Township 33 Range 23

On the 22nd day of September, 1964, the described corner was evidenced by a concrete monument

and to perpetuate the location of said corner, at the exact location thereof, a permanent marker was placed consisting of a cast iron monument

(MON 2'± S OF ℄ - 5' W OF PALISADE EXT'D.

AND on the 4th day of April, 2002, said permanent marker was found and the ties were updated

Updated reference ties are as shown below.

N
W ANOKA COUNTY SURVEYOR E
S

BK-JB
8-30-12
T/A - VRS

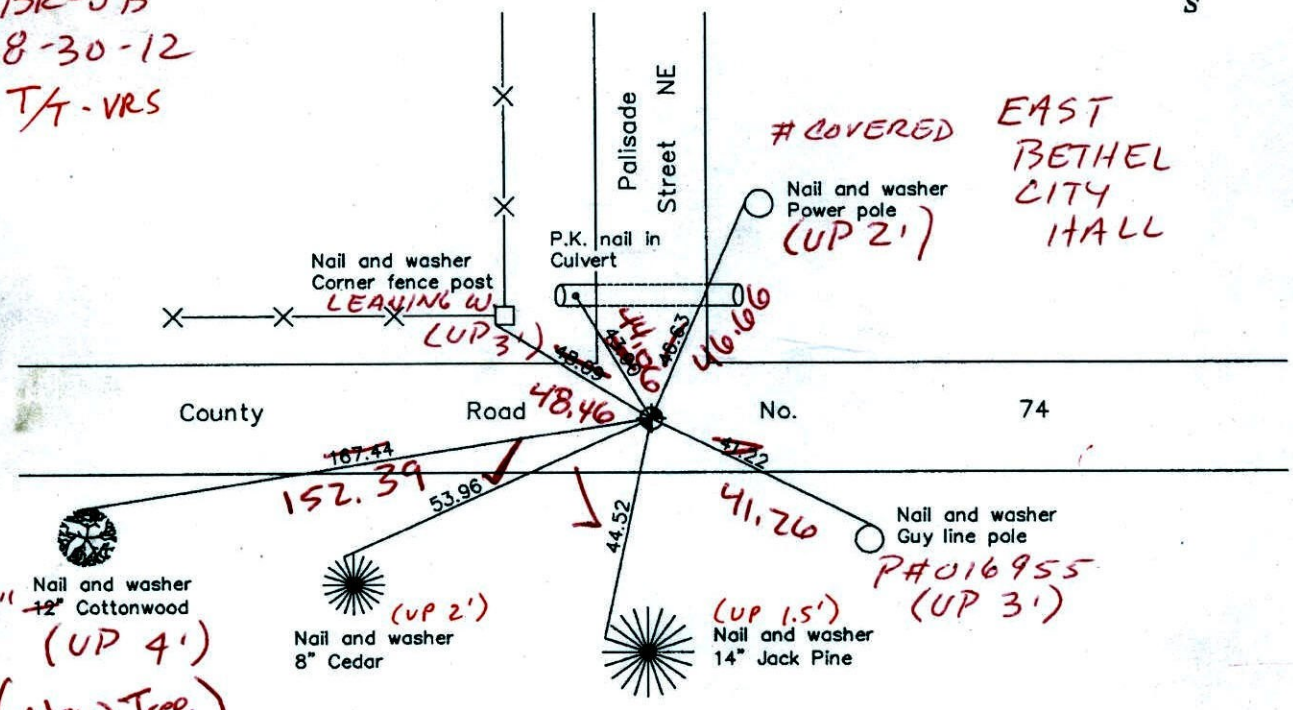

Revised date
8/04/97
6/20/00
4/04/02

N.A.D. 1983 Coordinates (1996 Adjustment)

County Project Coordinates	
Northing	222197.2056
Easting	513015.6450
Date	4/04/02

I hereby certify that this United States public land survey monument record is correct and complete to the best of my knowledge and belief.

Larry D. Hoium Date 4/04/02

Larry D. Hoium, Anoka County Surveyor

Minnesota License Number 18165

VRS 3DQ = 0.05 N = 222197.1713 E = 513015.6196

CERTIFICATE OF LOCATION OF GOVERNMENT CORNER

County of Anoka *State of Minnesota*

NORTH 1/4 Corner of Sec. 9 Township 33 Range 23

I hereby certify that on the 22 *day of* SEPTEMBER, 1964, *I found the described corner which was evidenced by* CONCRETE MONUMENT

and I further certify that to perpetuate the location of said corner, I did, at the exact location thereof, place a permanent marker consisting of CAST IRON MONUMENT

which reference or witness monuments are located in the manner following:

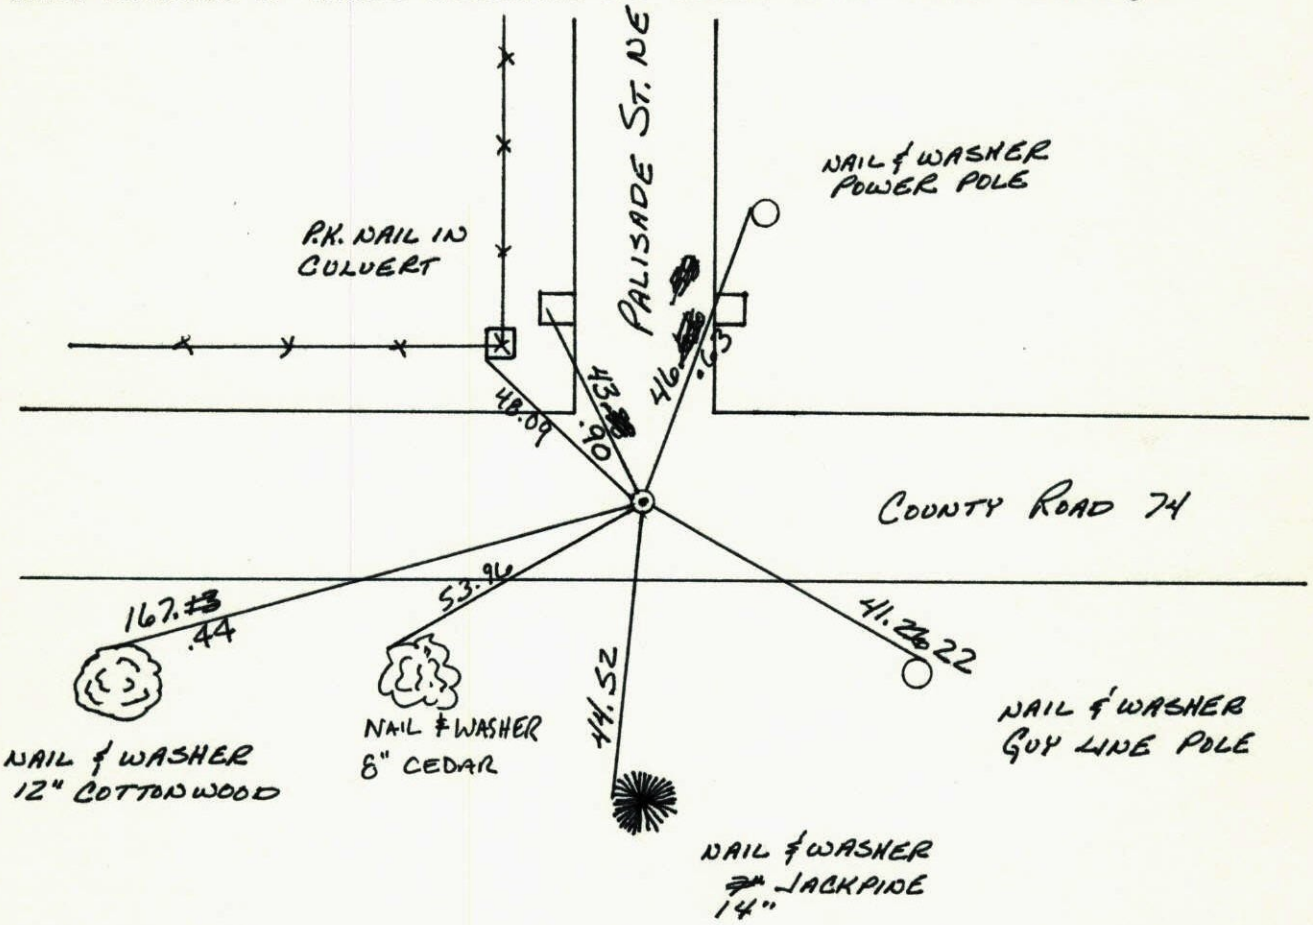

Revised date	Revised date	Revised date
9-2-69	8-4-97	
7-22-74	6-20-00	
6-29-77	4-4-02	
6-9-81		
6-12-84		
6-1-87		
8-6-92		

N
W ANOKA COUNTY SURVEYOR E
S

N1/4 Cor. Sec. 9 T33 R23

Conc. Mon. down 6" ~~Iron pipe on North~~ (flush)

Set Cast Iron Monument flush on top of broken concrete mon. PK's 2.00' North + East. Corner is 2'± South of ℄.

Sept. 2, 1969
D. Powell
R. Olson

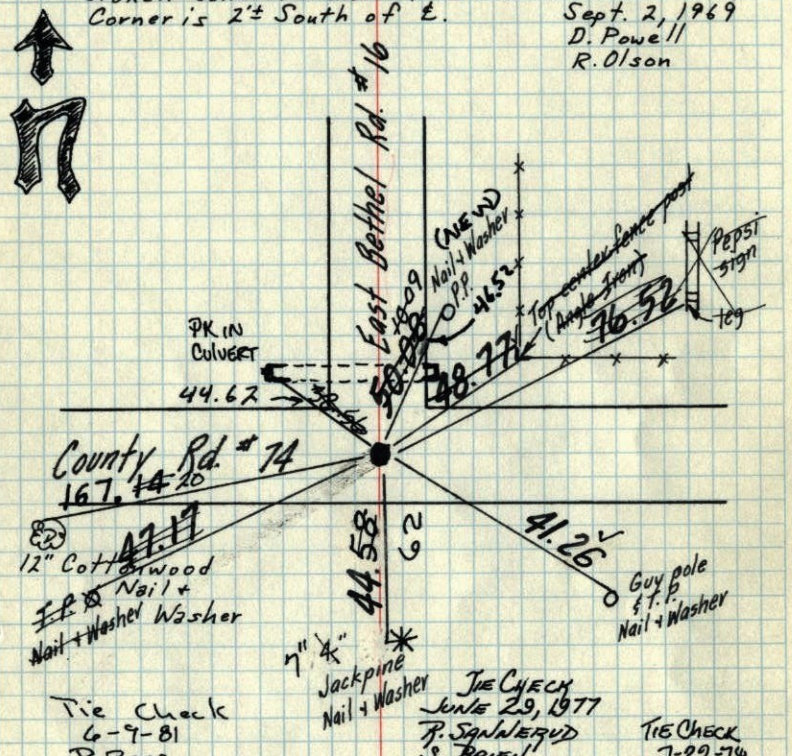

Tie Check
6-9-81
P. Ross
P. Hosuk
G. Deffings

TIE CHECK
6-12-84
D. ROSS
G. LIPS
R. BENNETT

TIE CHECK
JUNE 29, 1977
R. SANNERUD
J. BRIEN
J. STEPHENS

TIE CHECK
7-22-74
D. DAHL
N. DAHL

Retie 9/22/64
M. D. Anderson
G. Mills

TEMPERATURE CORRECTED AND HORIZONTALLY TAPED MEASUREMENTS

ROLAND W. ANDERSON
COUNTY SURVEYOR
ANOKA COUNTY, MINNESOTA

N1/4 Cor. Sec. 9 T33 R23

Conc. Mon. down 6" Iron pipe on North (flush)
Iron Pipe on West.

2'± South of ℄.

Set C.I. Mon. flush on top of broken concrete PK's 2.00' N & E.

9/2/69
#9-75
D. Powell
R. Olson

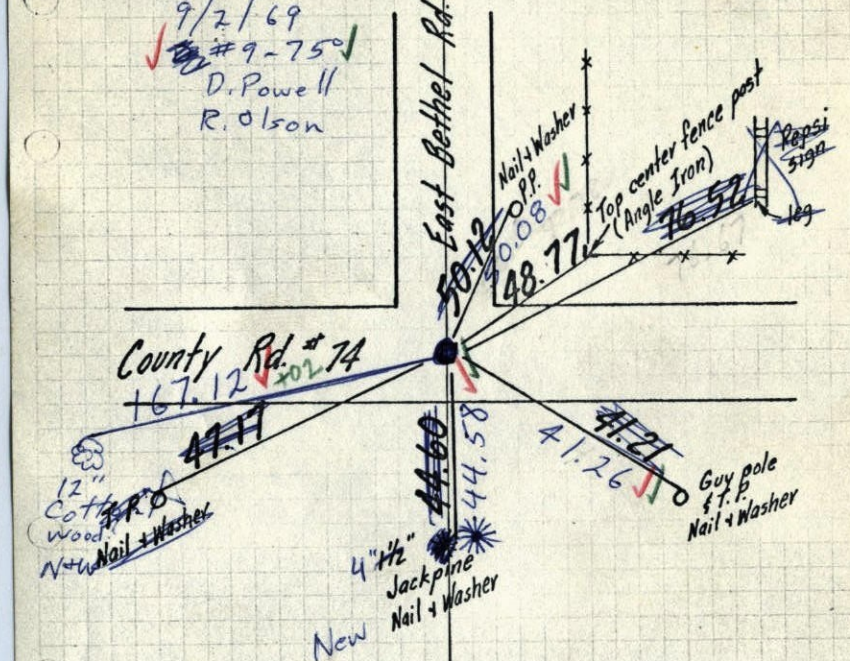

Retie 9/22/64
M. D. Anderson
G. Mills

TEMPERATURE CORRECTED AND HORIZONTALLY TAPED MEASUREMENTS

ROLAND W. ANDERSON
COUNTY SURVEYOR
ANOKA COUNTY, MINNESOTA

N 1/4 Cor. Sec. 9, T. 33, R. 23

Conc. Mon. down 6" with I. P. on No. Side (Flush)

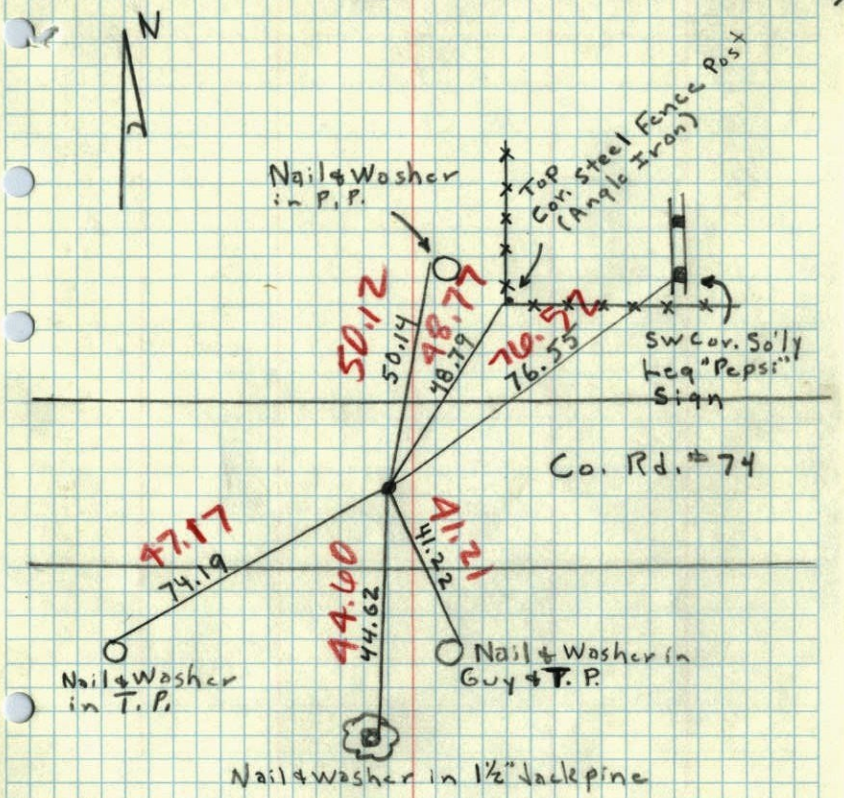

2/23/62
15°

V. Oliver
M. D. Anderson
H. Small

4

N 1/4 Corner of Sec. 9, T33, R23

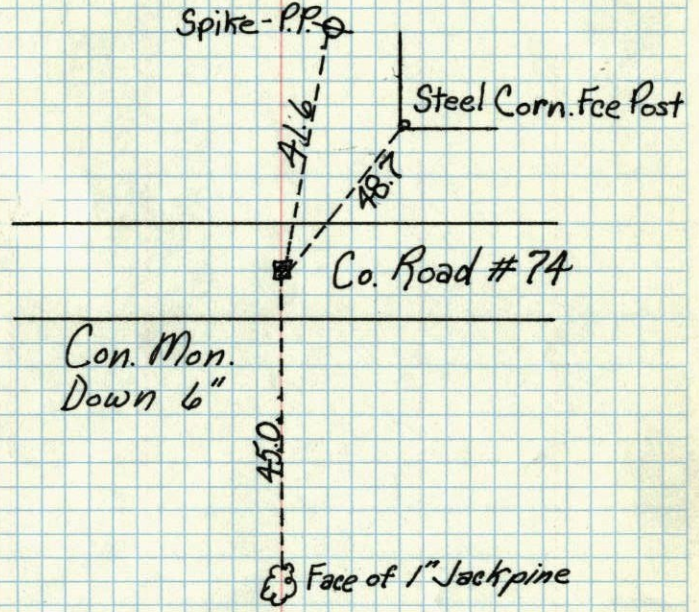

Apr. 30, 1957
C. Hwy Dept.

N 1/4 Corn. Sec. 9, T33, R23
County Hwy. Dept.
4-30-57
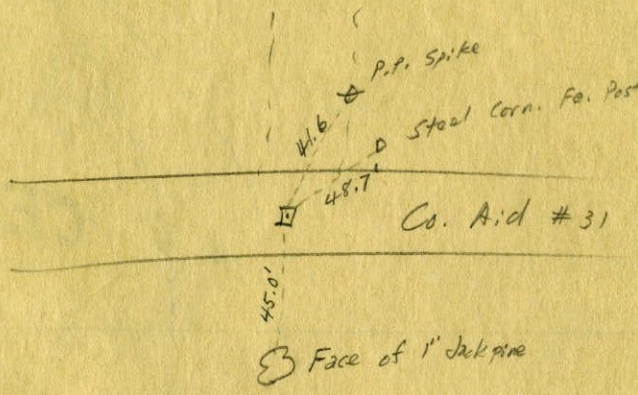
Conc. Mon. Down 6"