

# CERTIFICATE OF LOCATION OF GOVERNMENT CORNER

County of Anoka

State of Minnesota

East 1/4 Corner of Sec. 9 Township 33 Range 23

On the 20th day of March, 1973, the described corner was evidenced by area resurvey


and to perpetuate the location of said corner, at the exact location thereof, a permanent marker was placed consisting of a cast iron monument with a sign and post on the south side

(MIN. DOWN 0.3' ±)

AND on the 4th day of April, 2002, said permanent marker was found and the ties were updated

Updated reference ties are as shown below.

POLE # 86522

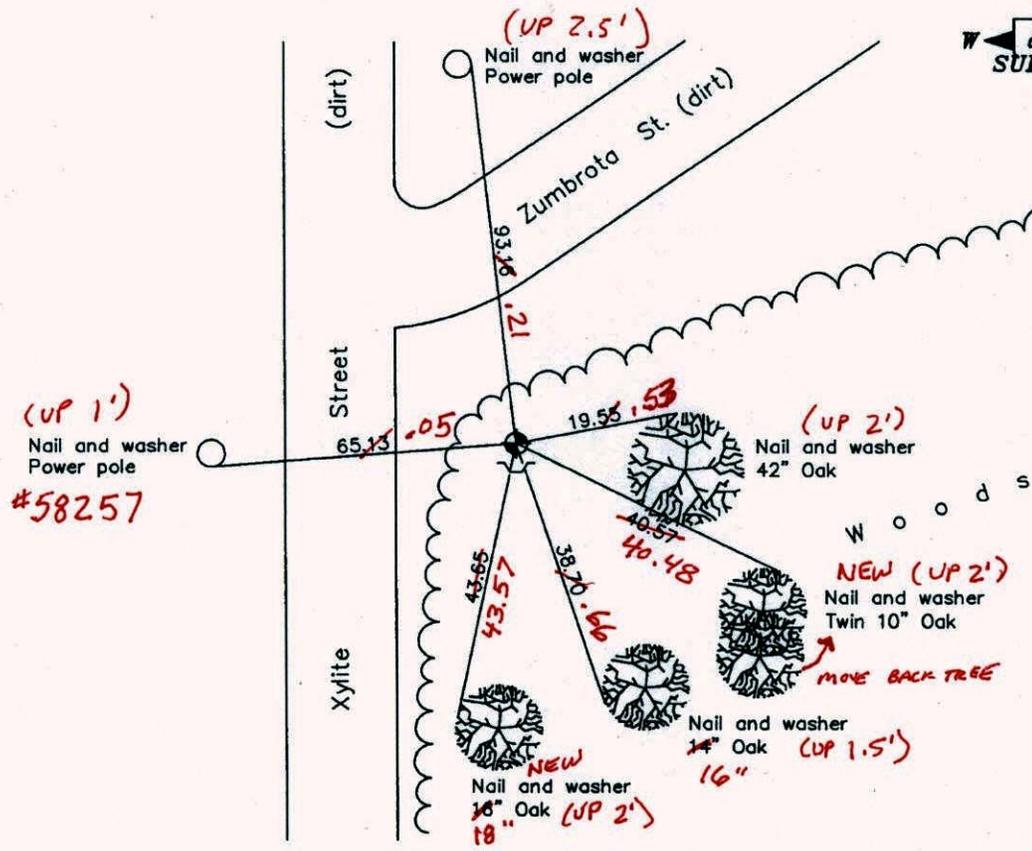

1-2-13  
BK-SS  
T/T

Revised date
8/11/97
8/03/00
4/04/02

N.A.D. 1983 Coordinates (1996 Adjustment)	
County Project Coordinates	
Northing	<u>219529.8693</u>
Easting	<u>515690.7015</u>
Date	<u>4/04/02</u>

I hereby certify that this United States public land survey monument record is correct and complete to the best of my knowledge and belief.

*Larry D. Hoium* Date: 4/04/02

\_\_\_\_\_  
Larry D. Hoium, Anoka County Surveyor

Minnesota License Number 18165

# CERTIFICATE OF LOCATION OF GOVERNMENT CORNER

County of Anoka


State of Minnesota

EAST 1/4 Corner of Sec. 9 Township 33 Range 23


I hereby certify that on the 20 day of MARCH, 1923, I found the described corner which was evidenced by AREA RESORVEY

and I further certify that to perpetuate the location of said corner, I did, at the exact location thereof, place a permanent marker consisting of CAST IRON MONUMENT WITH SIGN AND POST ON THE SOUTH SIDE

which reference or witness monuments are located in the manner following:

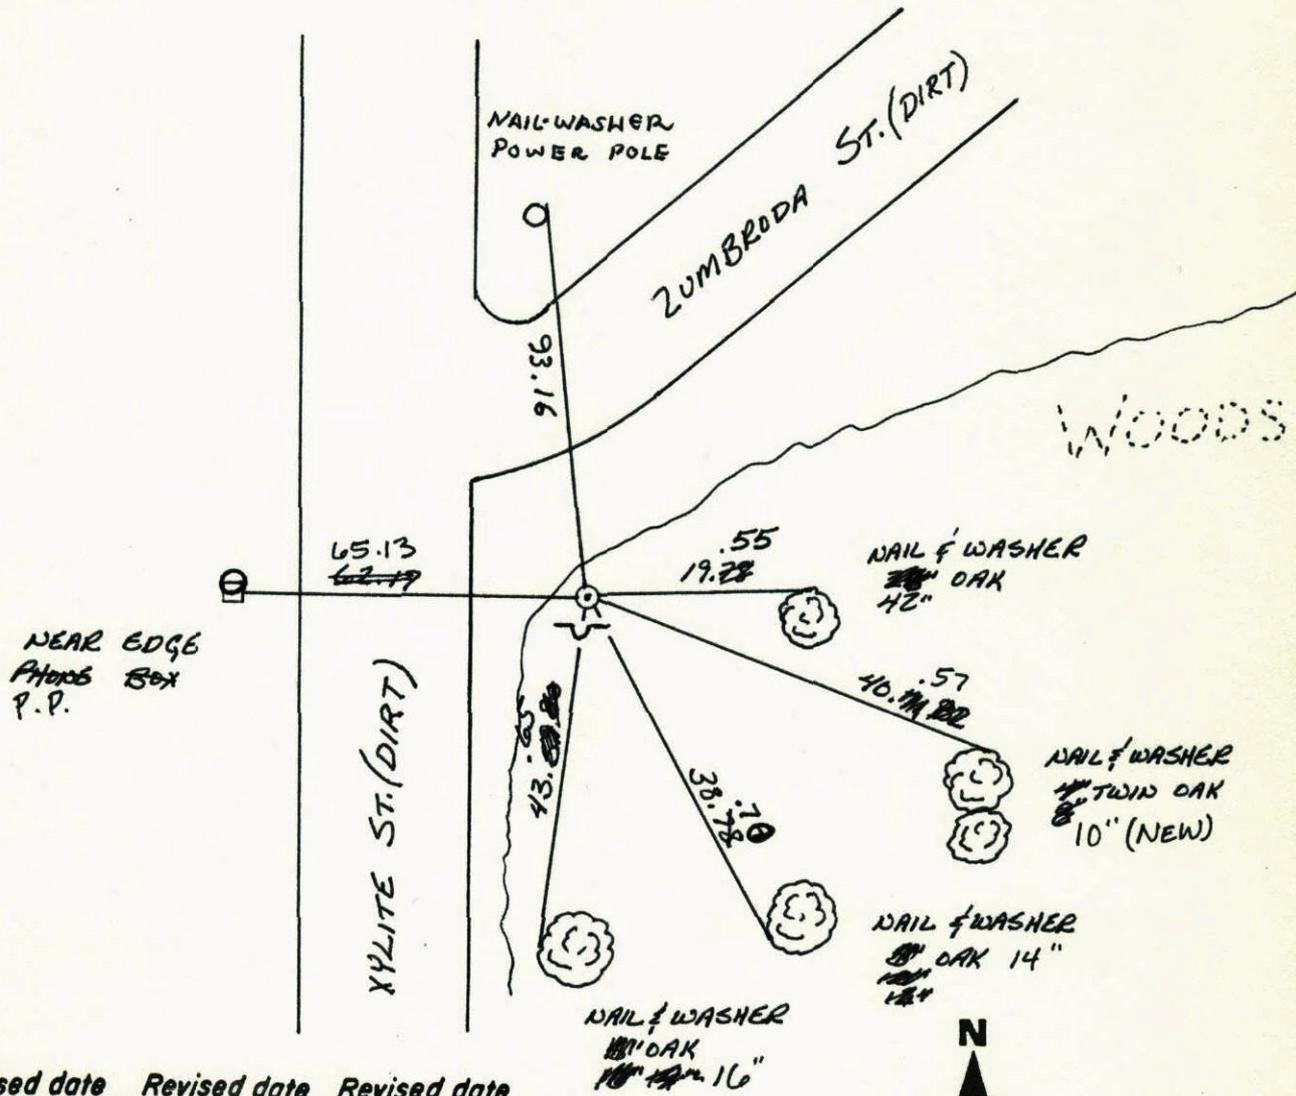


Revised date	Revised date	Revised date
8-1-74		
6-29-77		
6-10-81		
8-6-92		
8-11-97		
8-3-00		
4-4-02		

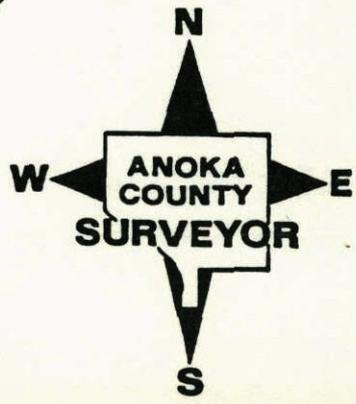

E. 1/4 Cor. Sec. 9-T33-R23

Set Cast Iron Mon. From area re-survey  
Set steel sign post with warning sign 1±5

Tie Check  
6-15-84  
D. ROSS  
C. LIPS  
R. BENNETT

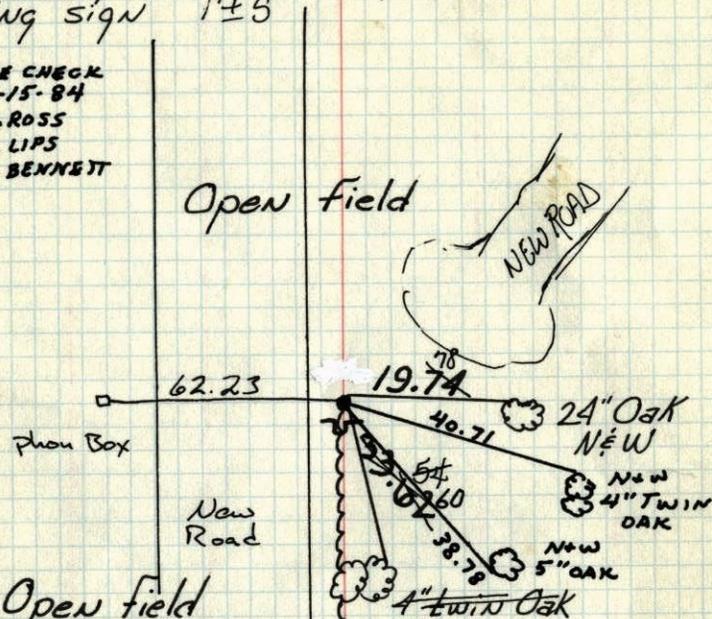

Open field

March 20, 1973  
M. D. Anderson +  
H. J. Larson +  
temp. 45°  
tape #11

Tie Check  
JUNE 29, 1977  
P. SAWYER  
S. BAIEN  
J. STEPHENS

BRUSH

Tie Check  
8-1-74  
R. FARMER  
N. DAHL  
D. DAHL

Tie Check  
6-10-81  
P. ROSS  
P. HARNEY  
G. WELFINGER


TEMPERATURE CORRECTED AND HORIZONTALLY TAPED MEASUREMENTS  
ROLAND W. ANDERSON  
COUNTY SURVEYOR  
ANOKA COUNTY, MINNESOTA

E. 1/4 Cor. Sec. 9-T33-R23

Set Cast Iron Mon. from area resurvey  
Set steel sign post with warning sign

OPEN FIELD

March 20, 1973  
M. D. Anderson +  
H. J. Larson +  
temp. 45°  
tape #11

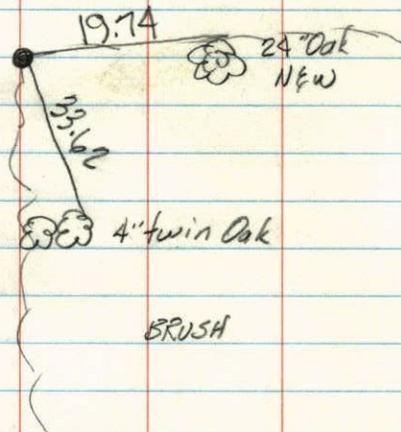

OPEN FIELD

BRUSH