

# CERTIFICATE OF LOCATION OF GOVERNMENT CORNER

County of Anoka

State of Minnesota


## Northeast Corner of Sec. 14 Township 33 Range 23

On the 8th day of November, 1963, the described corner was evidenced by a 3/4" iron pipe set from area resurvey

and to perpetuate the location of said corner, at the exact location thereof, a permanent marker was placed consisting of a cast iron monument

AND on the 20th day of April, 2012, said permanent marker was found and the ties were updated

Updated reference ties are as shown below.

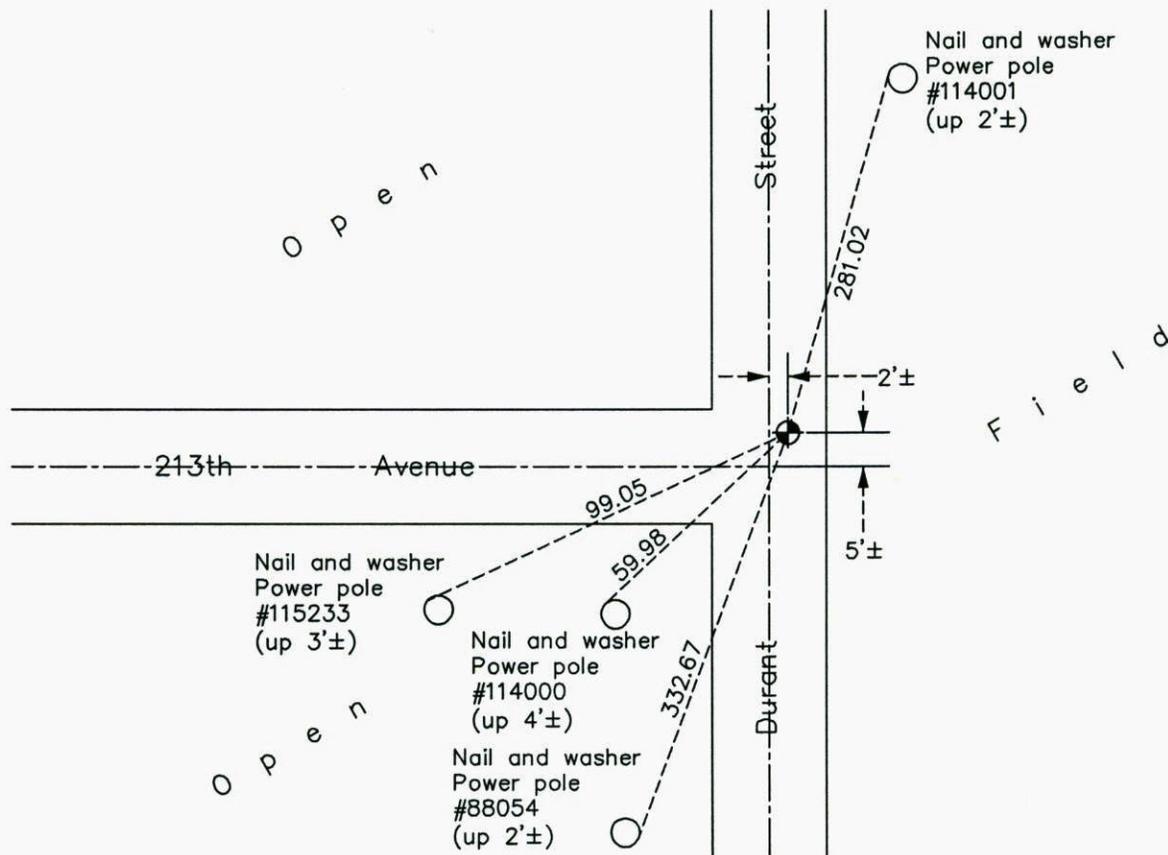

N

ANOKA COUNTY SURVEYOR

S

Revision Date

6/04/13

N.A.D. 1983 Coordinates  
(1996 Adjustment)

County Project Coordinates	
Northing	<u>216823.3139</u>
Easting	<u>526249.2417</u>
Date	<u>4/10/02</u>

I hereby certify that this United States public land survey monument record is correct and complete to the best of my knowledge and belief.

*Larry D. Hoium* Date 6/04/13

Larry D. Hoium, Anoka County Surveyor

Minnesota License Number 18165

# CERTIFICATE OF LOCATION OF GOVERNMENT CORNER

County of Anoka

State of Minnesota


Northeast Corner of Sec. 14 Township 33 Range 23

On the 8th day of November, 1963, the described corner was evidenced by a 3/4" iron pipe by area resurvey

and to perpetuate the location of said corner, at the exact location thereof, a permanent marker was placed consisting of a cast iron monument (EAST OF  $\phi$ , 3'±)

AND on the 30th day of August, 2000, said permanent marker was found and the ties were updated

Updated reference ties are as shown below.

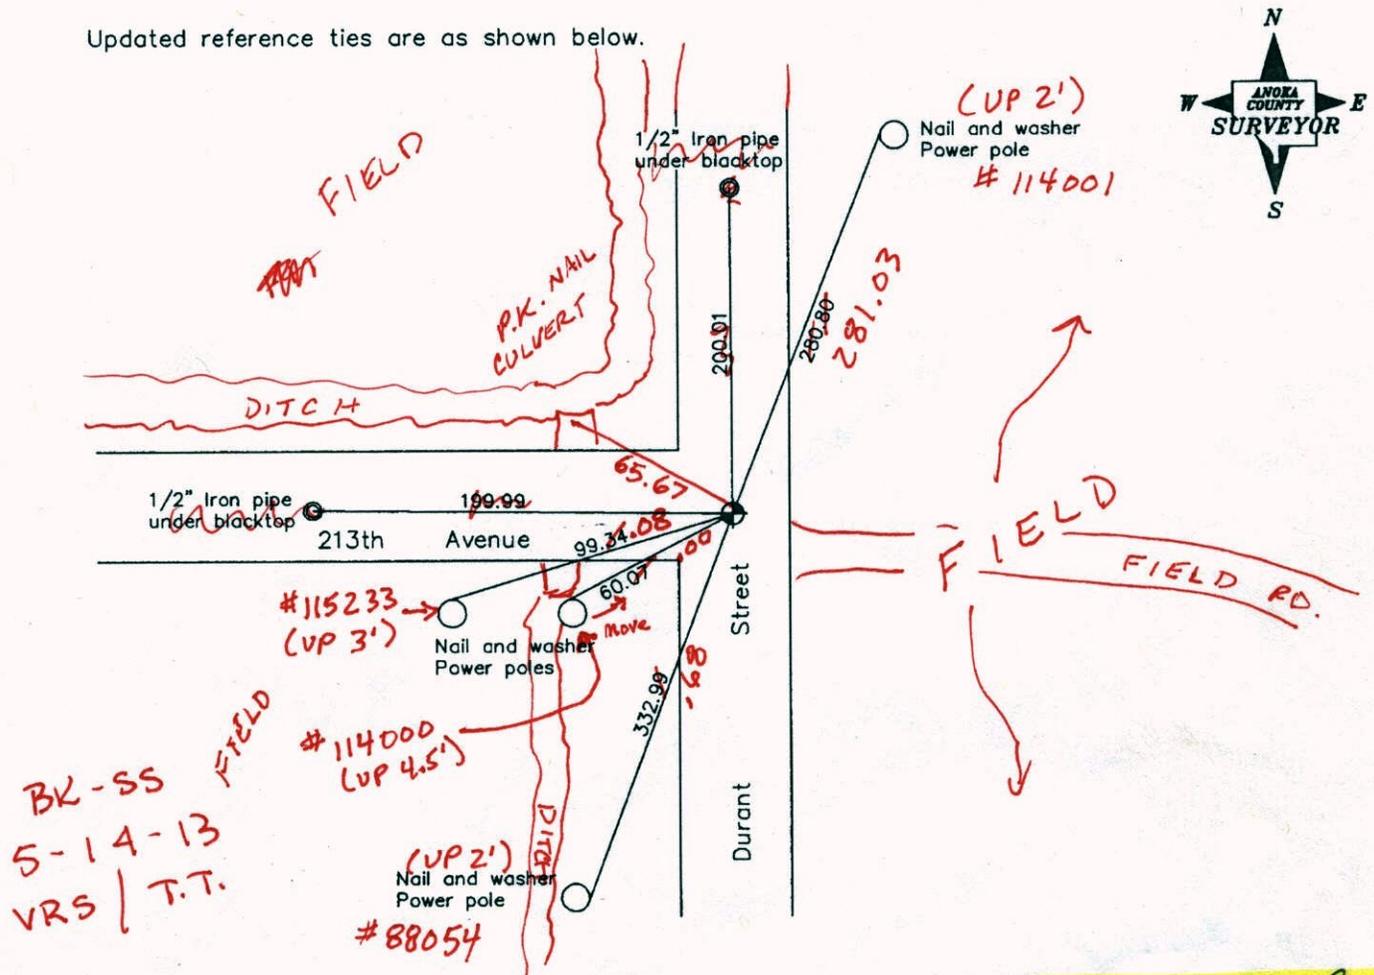

Revised date

8/04/92
8/11/97
8/30/00

N.A.D. 1983 Coordinates  
(1996 Adjustment)

County Project Coordinates	
Northing	<u>216823.3139</u>
Easting	<u>526249.2417</u>
Date	<u>4/10/02</u>

Loosen Top & Paint

I hereby certify that this United States public land survey monument record is correct and complete to the best of my knowledge and belief.

*Larry D. Hoium* Date 8/30/00

Larry D. Hoium, Anoka County Surveyor

Minnesota License Number 18165

$3D = 0.08$

$N = 216823.2519$

$E = 526249.2390$

# CERTIFICATE OF LOCATION OF GOVERNMENT CORNER

County of Anoka                      State of Minnesota


Northeast Corner of Sec. 14 Township 33 Range 23

On the 8th day of November, 1963, the described corner was evidenced by a 3/4" iron pipe by area resurvey

and to perpetuate the location of said corner, at the exact location thereof, a permanent marker was placed consisting of a cast iron monument (2' ± E. OF ♀) (5' ± N. OF ♀ 213TH)

AND on the 30th day of August, 2000, said permanent marker was found and the ties were updated

Updated reference ties are as shown below.

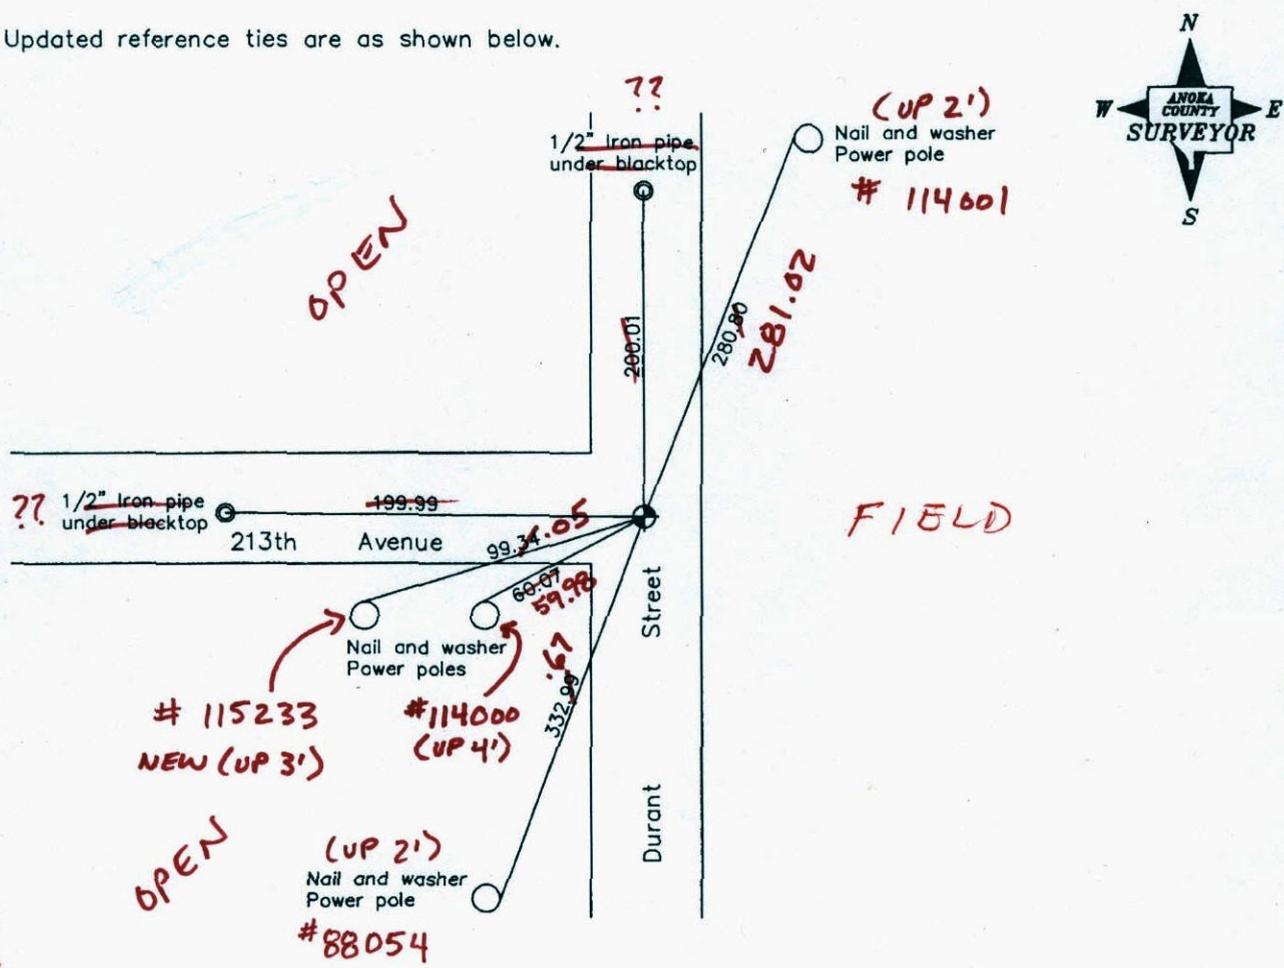

BR-SS  
4-12-20

T/T-VRS

Revised date
8/04/92
8/11/97
8/30/00

N.A.D. 1983 Coordinates (1996 Adjustment)	
County Project Coordinates	
Northing	216823.3139
Easting	526249.2417
Date	4/10/02

I hereby certify that this United States public land survey monument record is correct and complete to the best of my knowledge and belief.

*Larry D. Hoium*                      Date 8/30/00

Larry D. Hoium, Anoka County Surveyor

Minnesota License Number 18165

VRS 30=0.05

N= 216823.2590

E= 526249.2406

# CERTIFICATE OF LOCATION OF GOVERNMENT CORNER

County of Anoka


State of Minnesota

NORTHEAST Corner of Sec. 14 Township 33 Range 23


I hereby certify that on the 8<sup>TH</sup> day of NOVEMBER, 1963, I found the described corner which was evidenced by 3/4" IRON PIPE BY AREA RESURVEY

and I further certify that to perpetuate the location of said corner, I did, at the exact location thereof, place a permanent marker consisting of CAST IRON MONUMENT

which reference or witness monuments are located in the manner following:

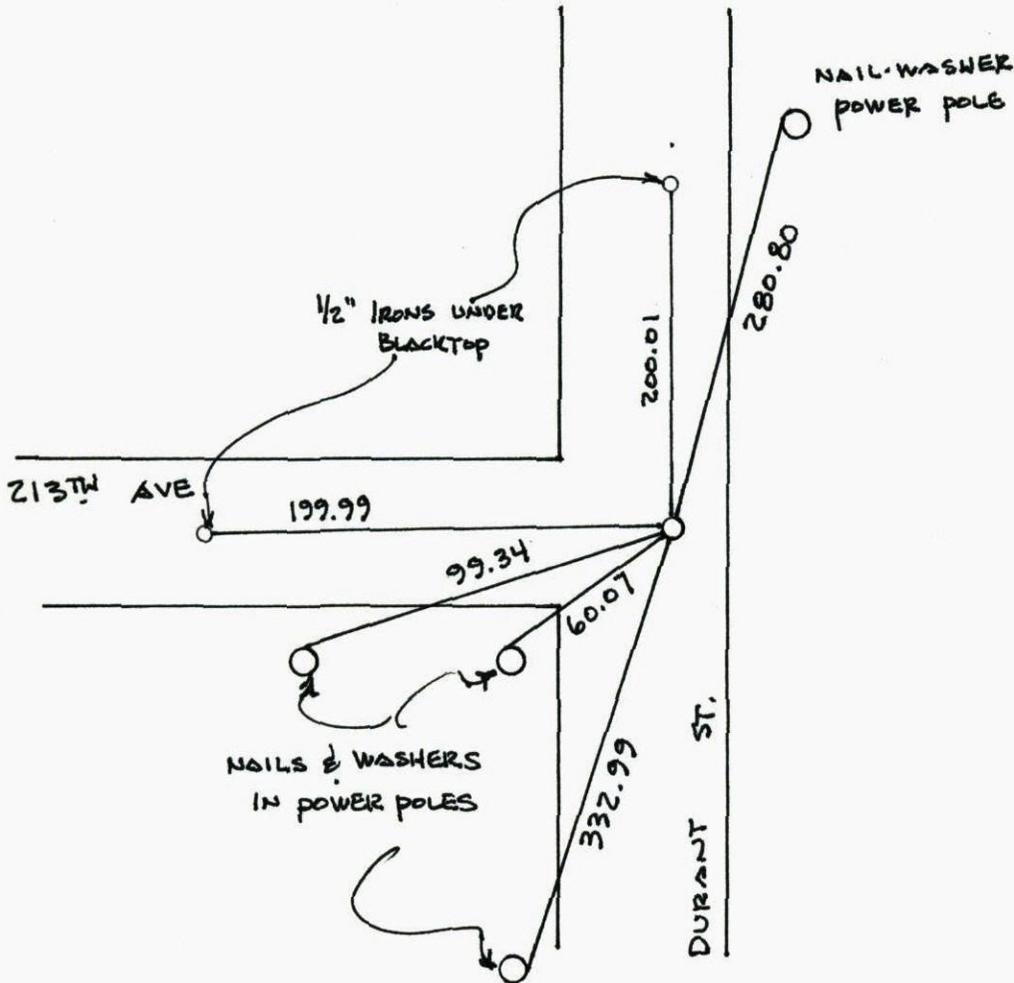


Revised date	Revised date	Revised date
10   11   85		
8   21   86		
8   4   92		
8   11   97		
8   30   00		

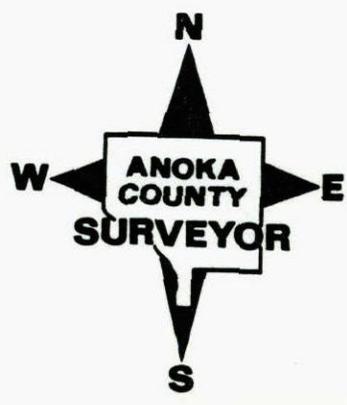

NORTHEAST COR. SEC 14 T33 R23

RESET CAST IRON MONUMENT

8-30-00  
J. SIMMER  
B. KLEMP  
T. SCHWAB

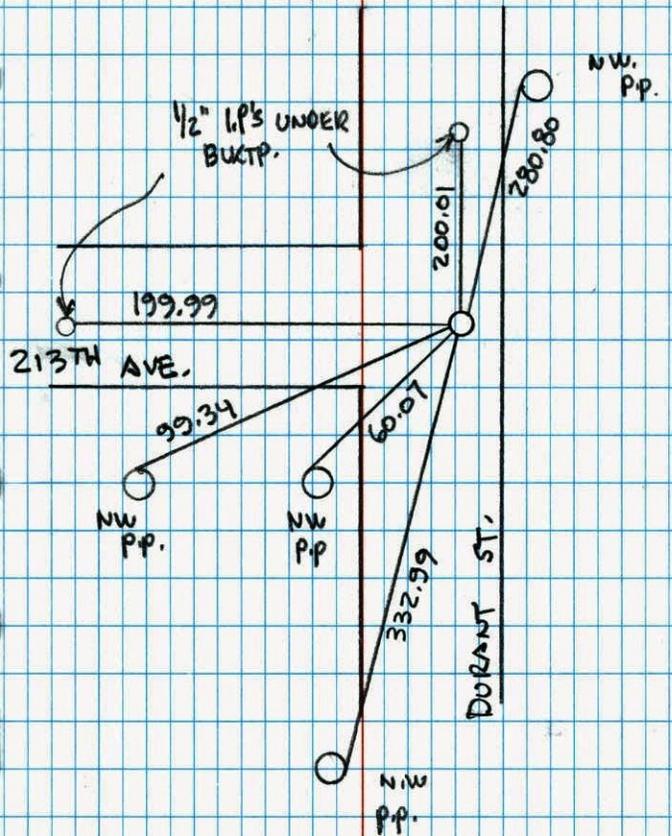

NO. 446  
NATIONAL PRINTING


NE CORNER SECTION 14 T33 R23

RESET CAST IRON MONUMENT AFTER CONSTRUCTION

SET FROM PRE-CONSTRUCTION SURVEY.

PK: 2.00 N. T E, C.I. 2' E AND 4' N OF C E

\*3 50°  
10-11-85  
H. LARSON  
B. GUETZKO  
H. GRAMS

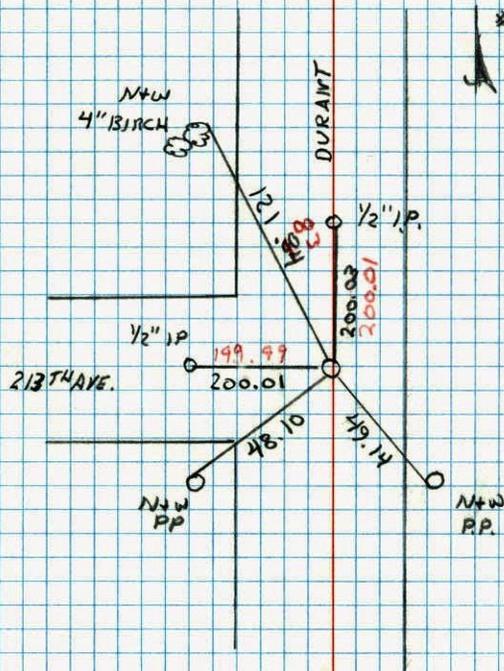


NO. 448

TELETYPE


NE 14 36  
SE Cor. Sec. #1, T33, R23

Set 3/4" Iron Pipe (down 0.3') From Resurvey.

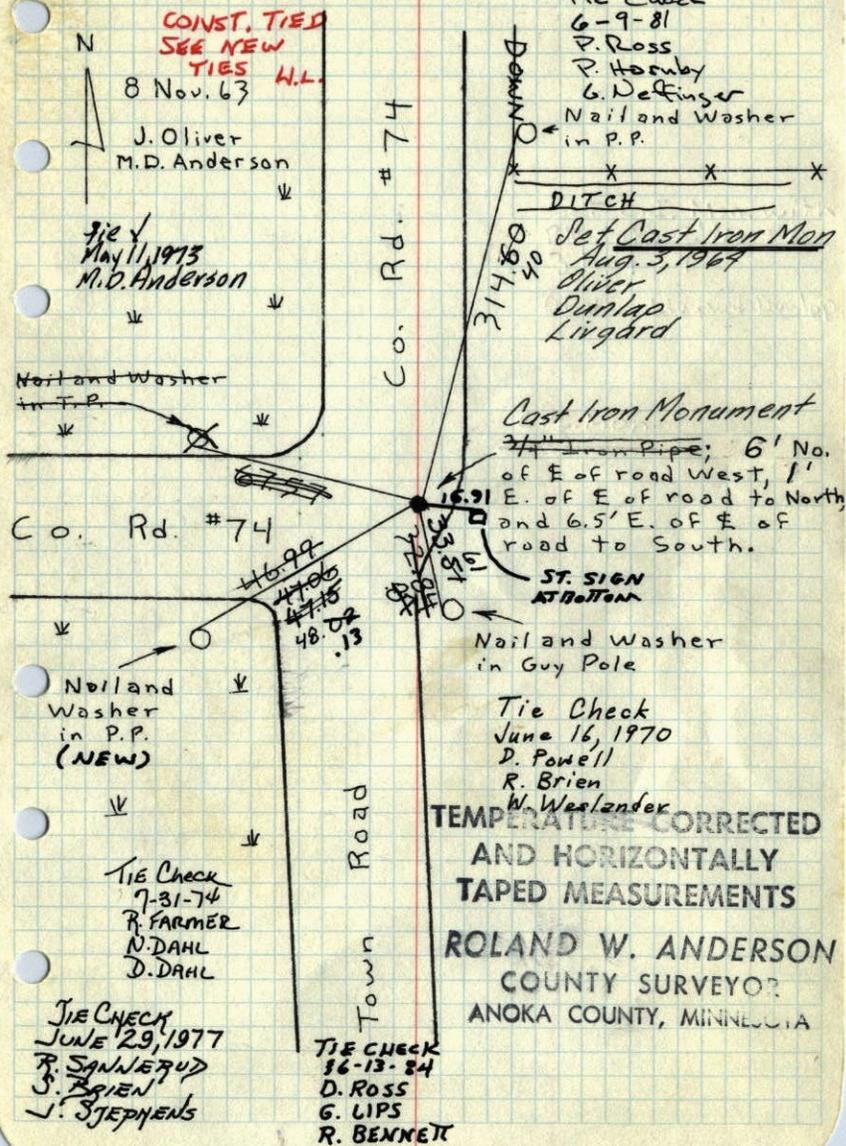

~~NE 14~~ 44  
SE Cor. Sec. #1, T33, R23

Set 3/4" Iron Pipe (down 0.3') From Resurvey.

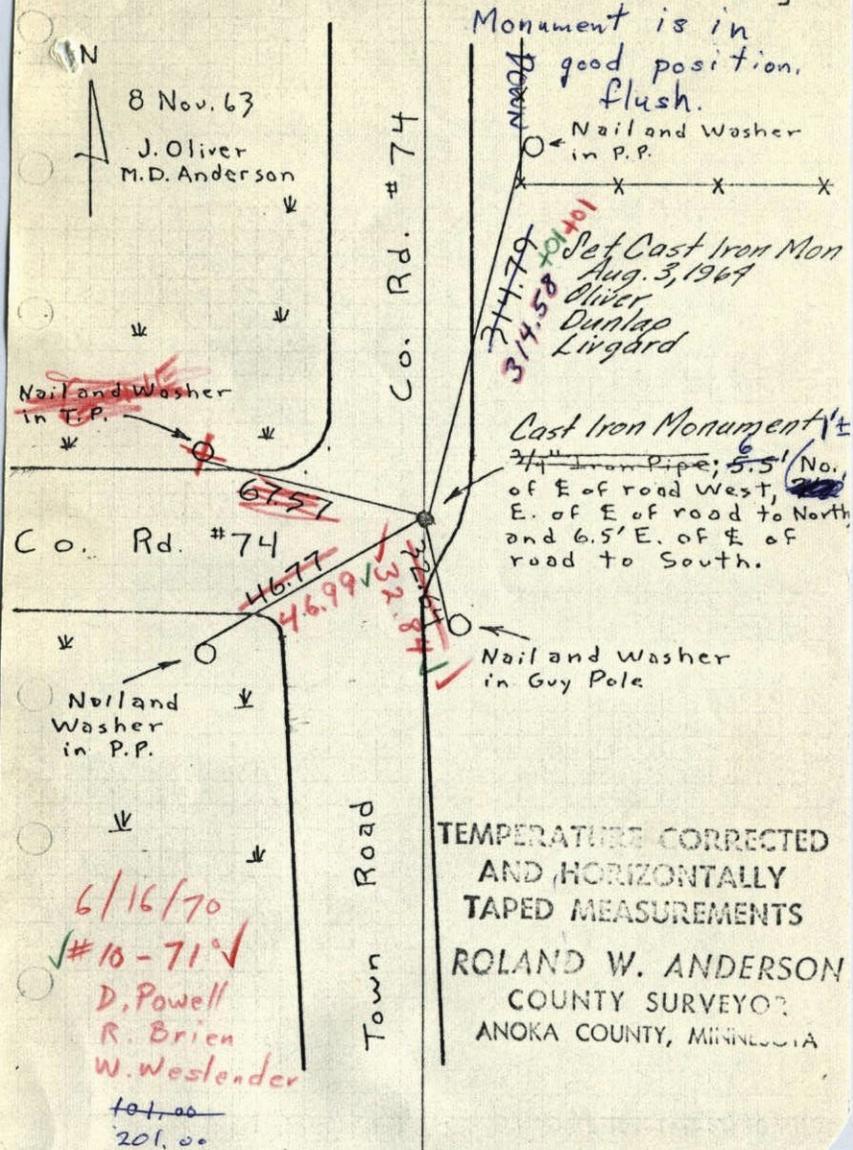

NE 14  
SE Cor. Sec. 4, T33, R23

Set 3/4" I.P. (down 0.3') from Resurvey.

Will set C.I. Mon. after Rd. is blacktopped

