CERTIFICATE OF LOCATION OF GOVERNMENT CORNER

County of Anoka State of Minnesota

North 1/4 Corner of Sec. 2 Township 33 Range 23

On the 27th day of November, 1963, the described corner was evidenced by area resurvey

and to perpetuate the location of said corner, at the exact location thereof, a permanent marker was placed consisting of a cast iron monument (1'± N. OF ℄)

AND on the 26th day of March, 2002, said permanent marker was found and the ties were updated

Updated reference ties are as shown below.

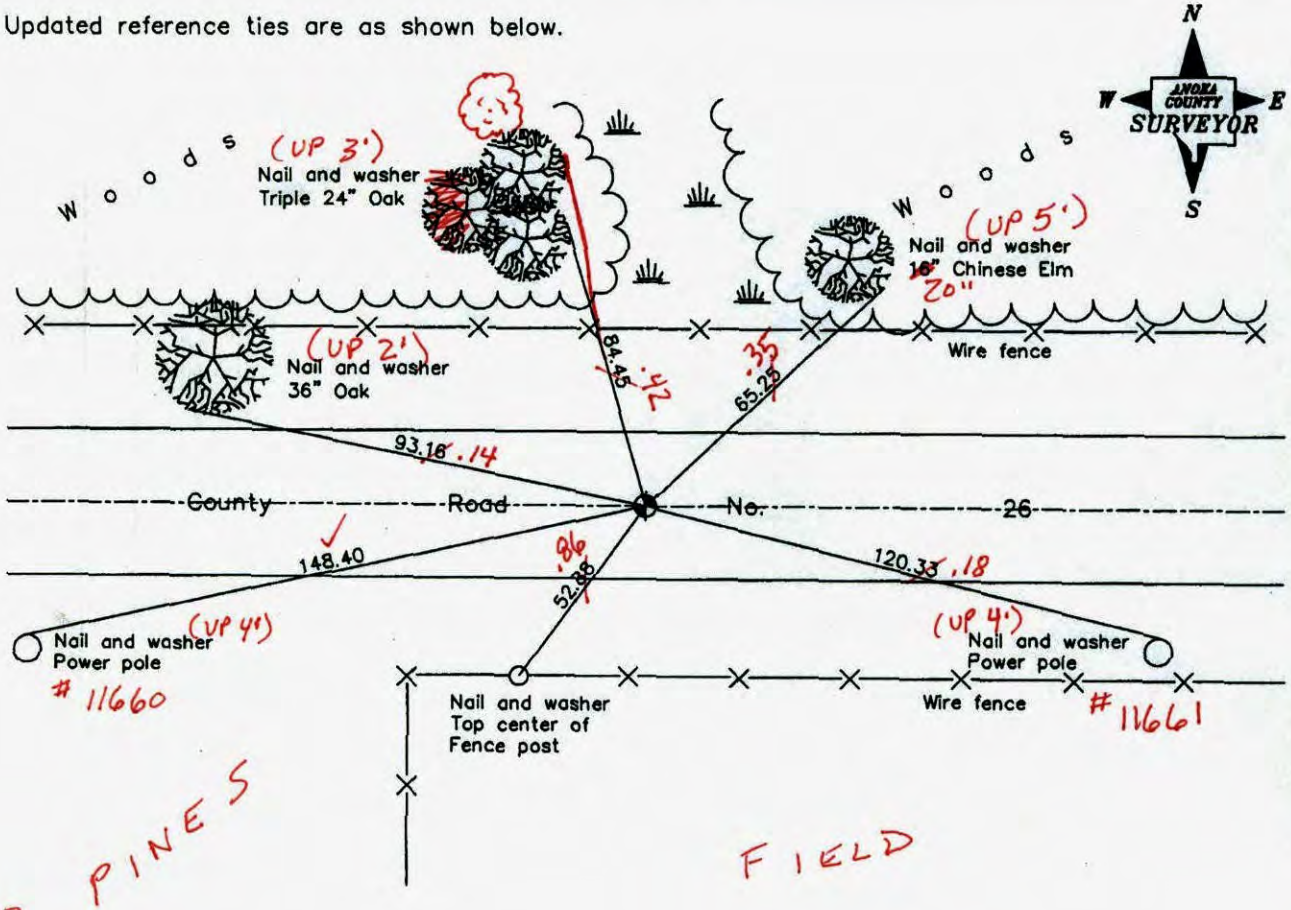

4-25-13
BK-55
T/T-VRS Revised date

Revised date
8/05/97
5/25/00
3/26/02

N.A.D. 1983 Coordinates
(1996 Adjustment)

County Project Coordinates	
Northing	227583.2023
Easting	524110.0232
Date	3/26/02

I hereby certify that this United States public land survey monument record is correct and complete to the best of my knowledge and belief.

Larry D. Hoium Date 3/26/02

Larry D. Hoium, Anoka County Surveyor

Minnesota License Number 18165

VRS 3DQ=0.06 N=227583.1599 E=524109.9626

Page No. 4

CERTIFICATE OF LOCATION OF GOVERNMENT CORNER

County of Anoka *State of Minnesota*

NORTH 1/4 Corner of Sec. 2 Township 33 Range 23

I hereby certify that on the 27th *day of* NOVEMBER, 1963, *I found the described corner which was evidenced by* AREA RESURVEY

and I further certify that to perpetuate the location of said corner, I did, at the exact location thereof, place a permanent marker consisting of CAST IRON MONUMENT

which reference or witness monuments are located in the manner following:

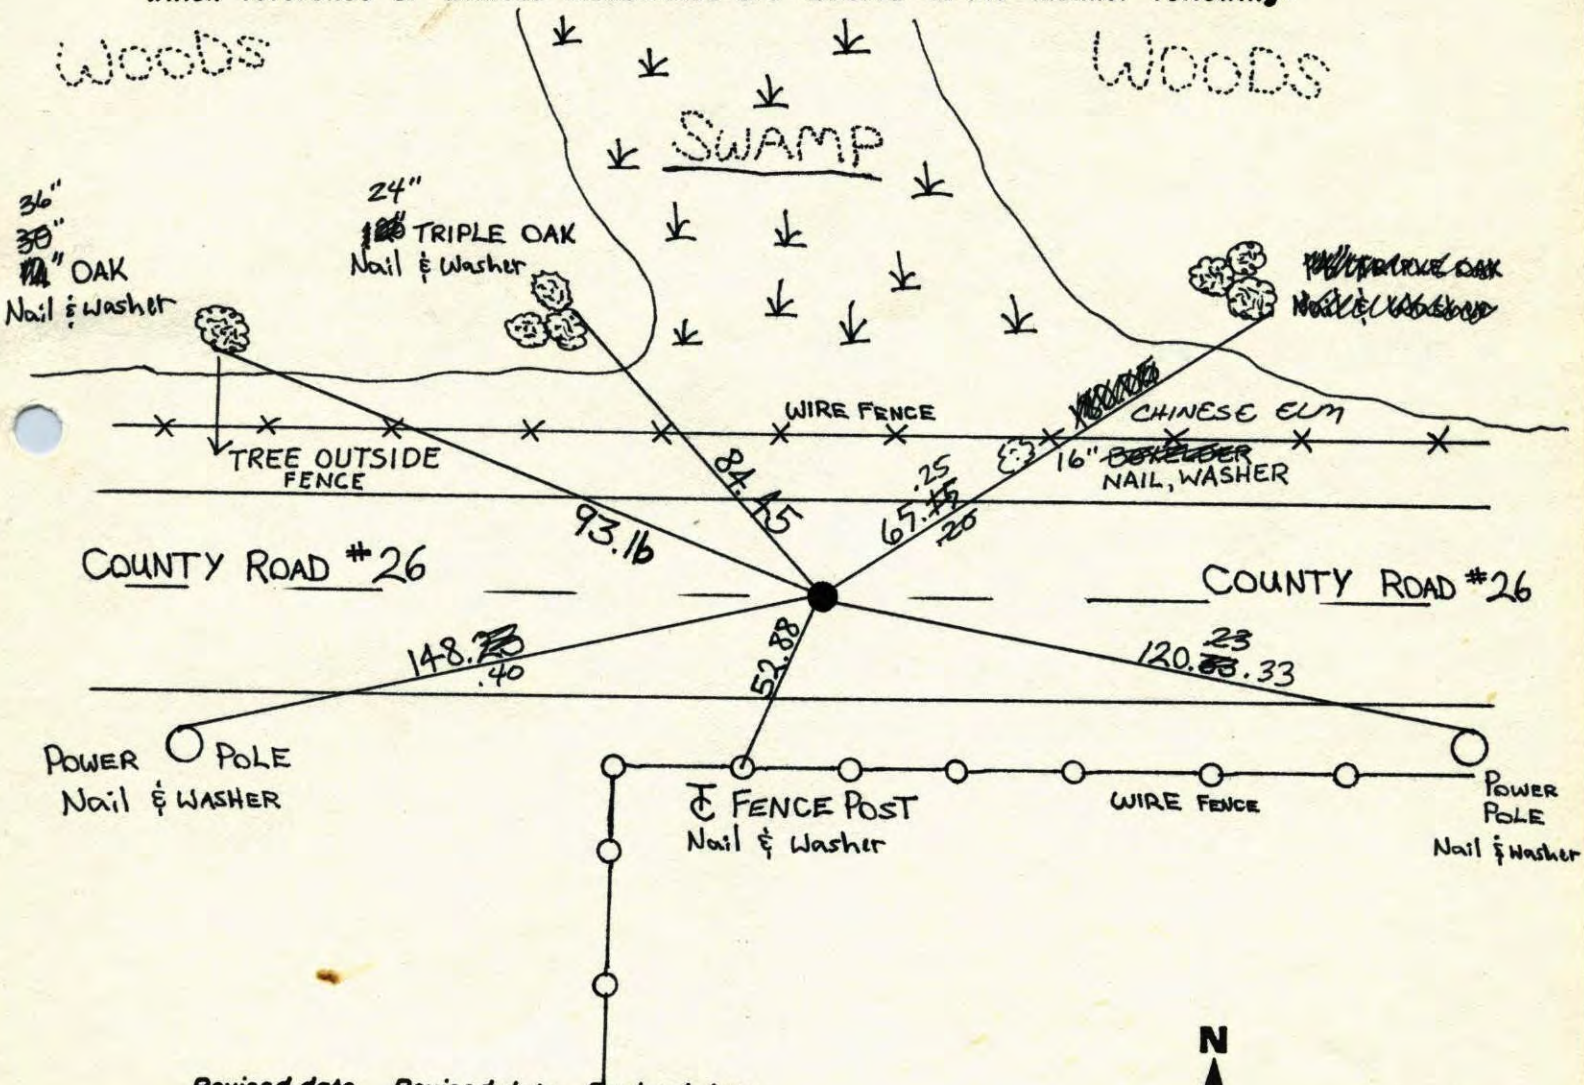

Revised date	Revised date	Revised date
8-18-86		
7-31-92		
8-5-97		
5-25-00		
3.26.02		

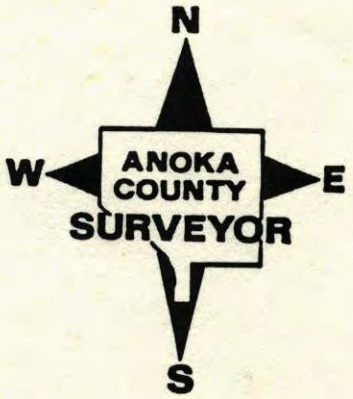

NORTH 1/4 of Sec. 2 T. 33 R 23

RETIED CAST IRON MONUMENT

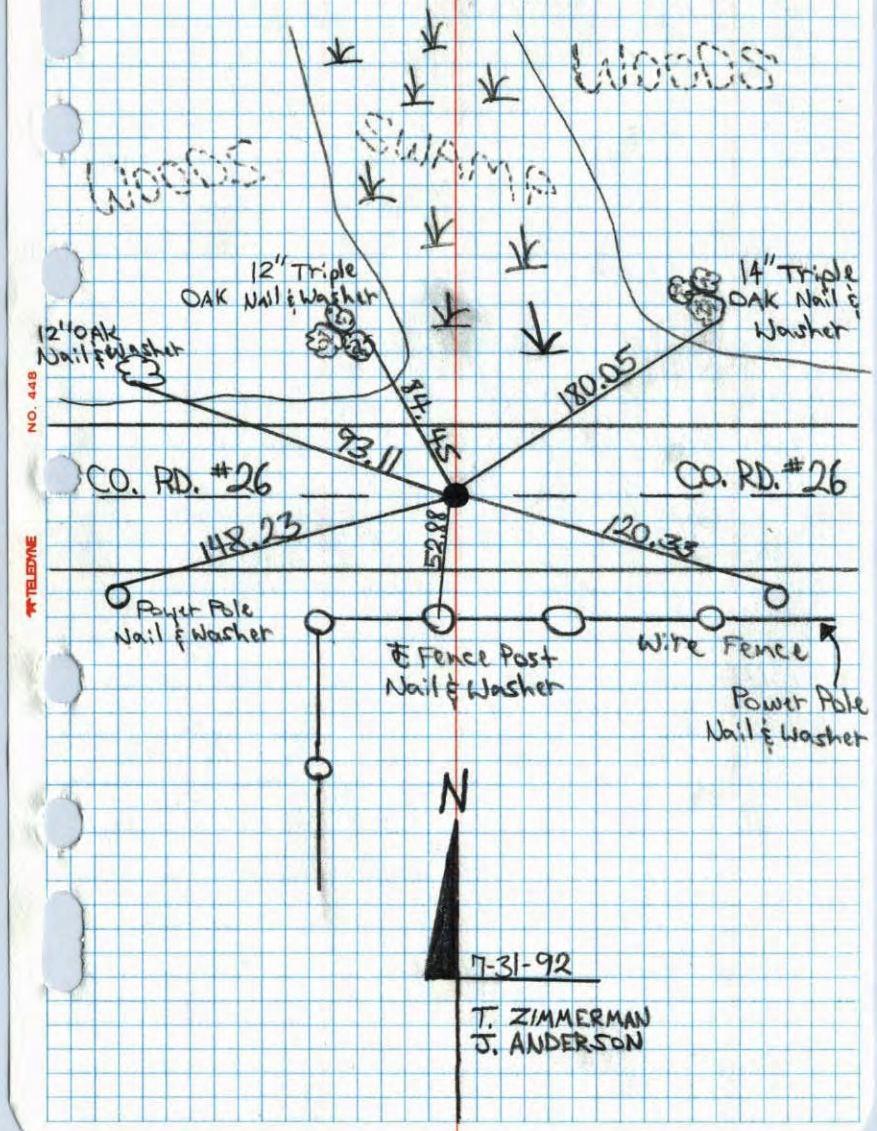

N 1/4 Cor. Sec. 2, T33, R23

Set Cast Iron Monument From Resurvey.

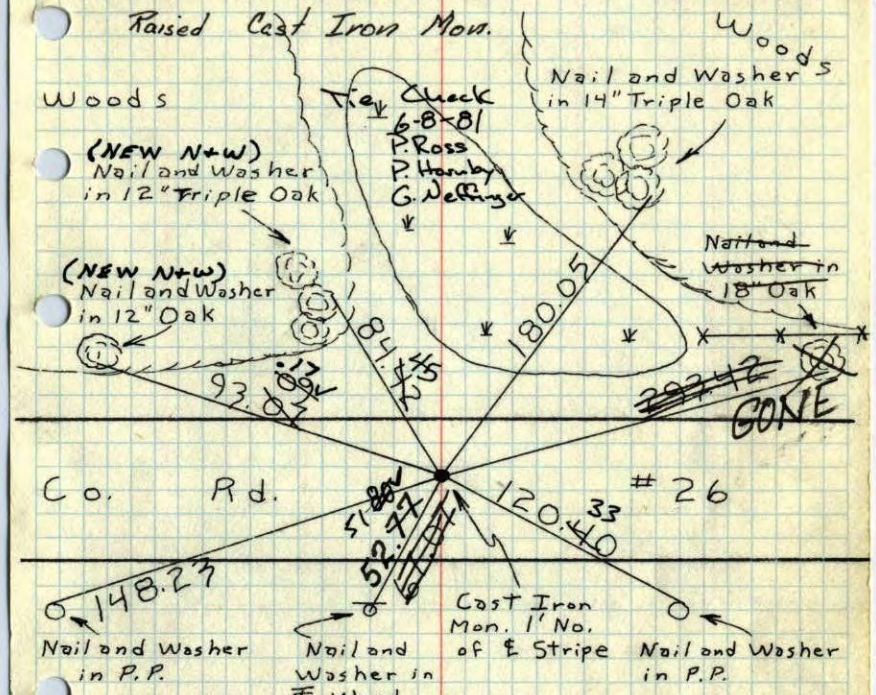

N

27 Nov. 63
J. Oliver
E. Madson

Field

Aug 12, 1971
K. Brien
J. Boettcher
B. Olson

Tie Check
July 20, 1967
D. Potter
D. Powell

Tie Check
June 16, 1970
D. Powell
R. Brien
W. Weslander

TEMPERATURE CORRECTED AND HORIZONTALLY TAPED MEASUREMENTS

TIE CHECK
JUNE 27, 1977
R. SQUIERUD J. BRIEN J. STEPHENS

TIE CHECK
D. ROSS
B. LIPS
R. BENNETT
6-11-84

ROLAND W. ANDERSON
COUNTY SURVEYOR
ANOKA COUNTY, MINNESOTA

TIE CHECK
7-22-74
N. DAHL
D. DAHL

4

N 1/4 Cor. Sec. 2, T33, R23

Set Cast Iron Monument From Resurvey.

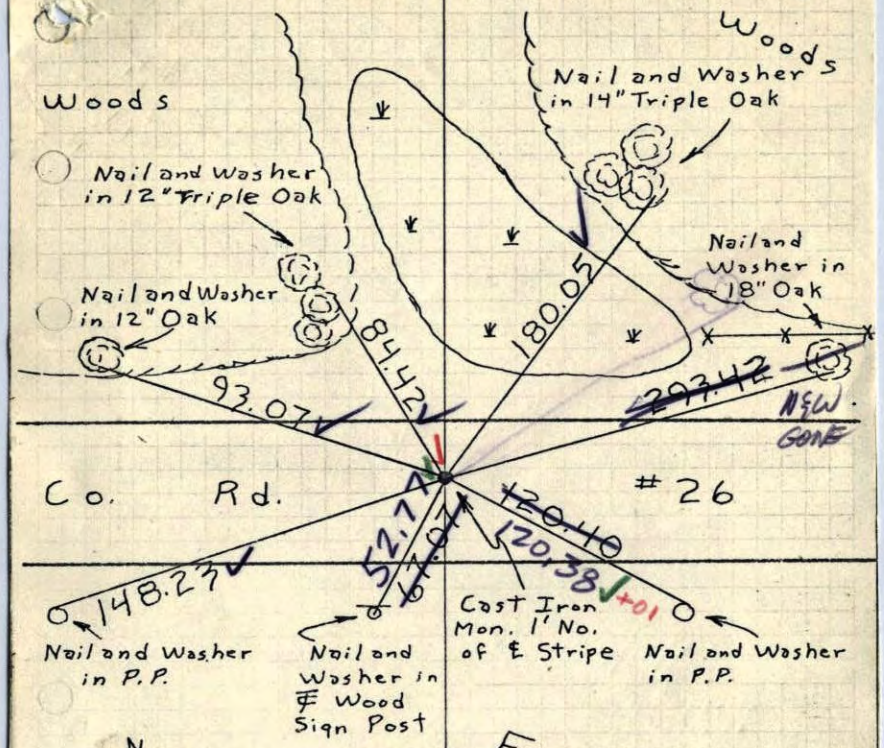

27 Nov. 63

J. Oliver
E. Madson

7/20/67
D. POTTER
D. POWELL
#7-76

TEMPERATURE CORRECTED AND HORIZONTALLY TAPED MEASUREMENTS

ROLAND W. ANDERSON
COUNTY SURVEYOR
ANOKA COUNTY, MINNESOTA

N1/4 Cor Sec. 2, T33, R23

Set Cast Iron Monument from Resurvey.

Set PK Spk's 2' North and East

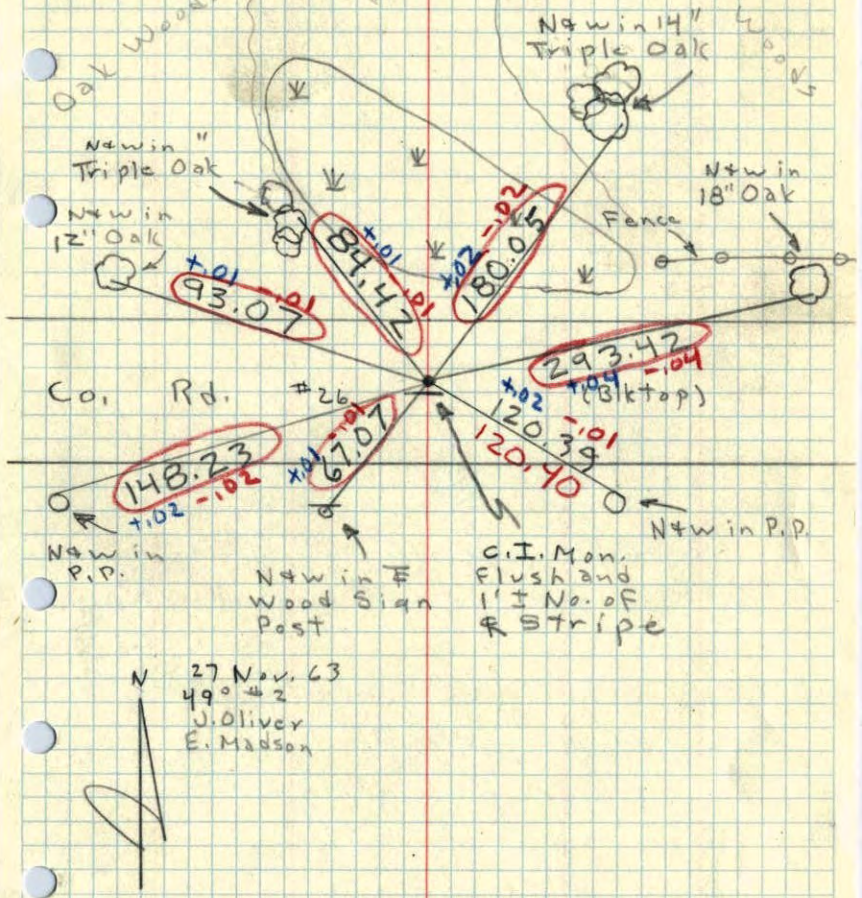

27 Nov. 63
49° #2
J. Oliver
E. Madson