

# CERTIFICATE OF LOCATION OF GOVERNMENT CORNER

County of Anoka

State of Minnesota


West 1/4 Corner of Sec. 15 Township 33 Range 23

On the 17th day of September, 1973, the described corner was evidenced by area resurvey

and to perpetuate the location of said corner, at the exact location thereof, a permanent marker was placed consisting of a cast iron monument with a sign and post on the north side

AND on the 26th day of March, 2003, said permanent marker was found and the ties were updated

Updated reference ties are as shown below.

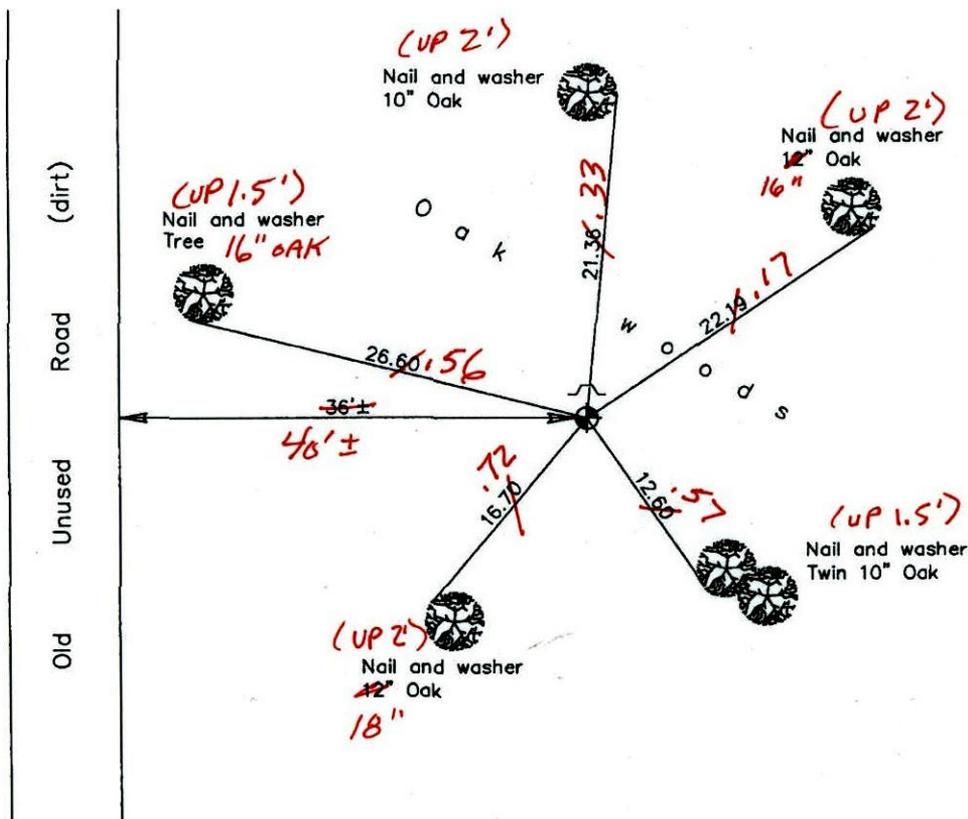

4-2-13  
BK-55  
TAPED

Revised date
6/05/87
8/20/92
3/26/03

N.A.D. 1983 Coordinates (1996 Adjustment)
County Project Coordinates
Northing <u>214295.7717</u>
Easting <u>515665.1649</u>
Date <u>3/26/03</u>

I hereby certify that this United States public land survey monument record is correct and complete to the best of my knowledge and belief.

*Larry D. Hoium* Date 3/26/03  
 \_\_\_\_\_, Anoka County Surveyor  
 Minnesota License Number 18165

# CERTIFICATE OF LOCATION OF GOVERNMENT CORNER

County of Anoka


State of Minnesota

WEST 1/4 Corner of Sec. 15 Township 33 Range 23


I hereby certify that on the 17<sup>TH</sup> day of SEPT., 19 73, I found the described corner which was evidenced by AREA RESURVEY

and I further certify that to perpetuate the location of said corner, I did, at the exact location thereof, place a permanent marker consisting of CAST IRON MONUMENT SIGN AND POST ON NORTH SIDE

which reference or witness monuments are located in the manner following:

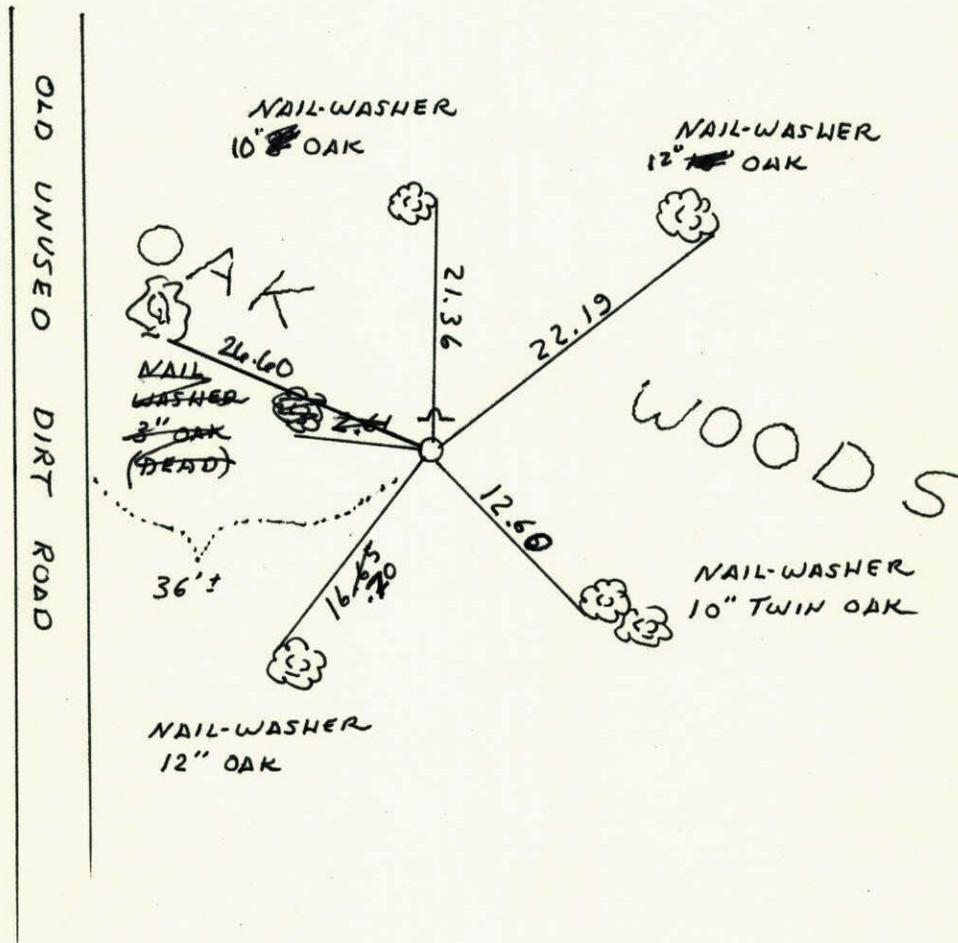


Revised date	Revised date	Revised date
6.5.87		
8-20-92		
3.26.03		

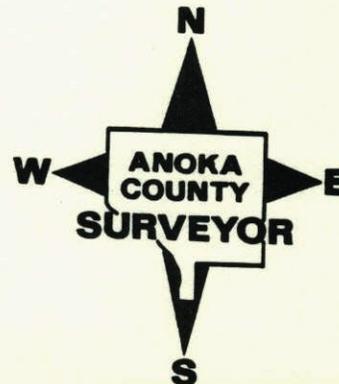

## W 1/4 COR. SEC. 15 - T33 - R23

RESET CAST IRON MONUMENT FROM AREA  
RESURVEY. CAST IRON FLUSH WITH SIGN AND  
POST ON NORTH SIDE.

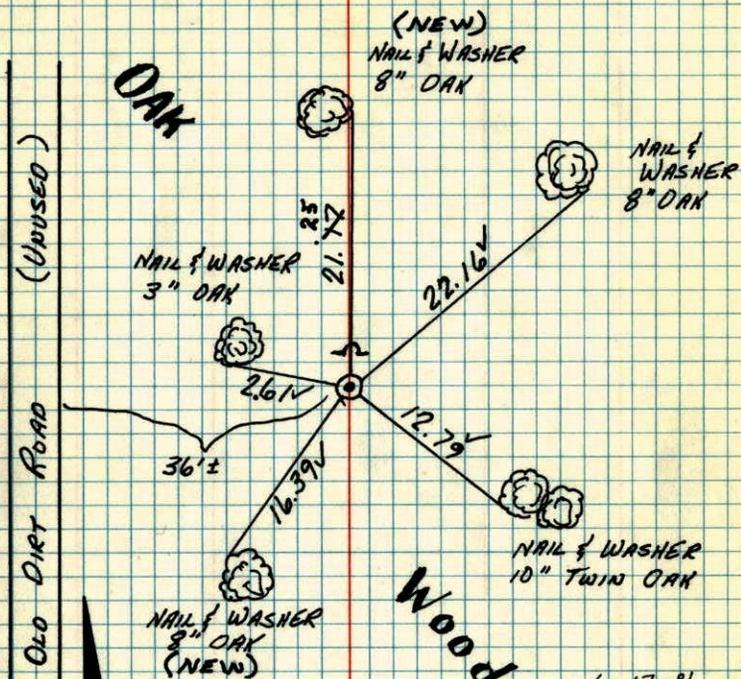

MAY 24-77

H. LARSON  
B. GUETZKO  
J. BOETTCHER

TIE CHECK  
JULY 1, 1977  
R. SAUNDER  
S. BRIEN  
J. STEPHENS


6-17-81  
TIE CHECK  
D. ROSS  
D. HOENBY  
G. NEFFINGER  
TIE CHECK  
7-5-84  
D. ROSS  
G. LIPS  
R. BENNETT

TEMPERATURE CORRECTED  
AND HORIZONTALLY  
TAPED MEASUREMENTS

ROLAND W. ANDERSON  
COUNTY SURVEYOR  
'ANOKA COUNTY, MINNESOTA'

## W 1/4 Cor. Sec. 15 T33 R23


Reset cast iron monument from  
area resurvey o.i. Flush with sign  
and post on N. side

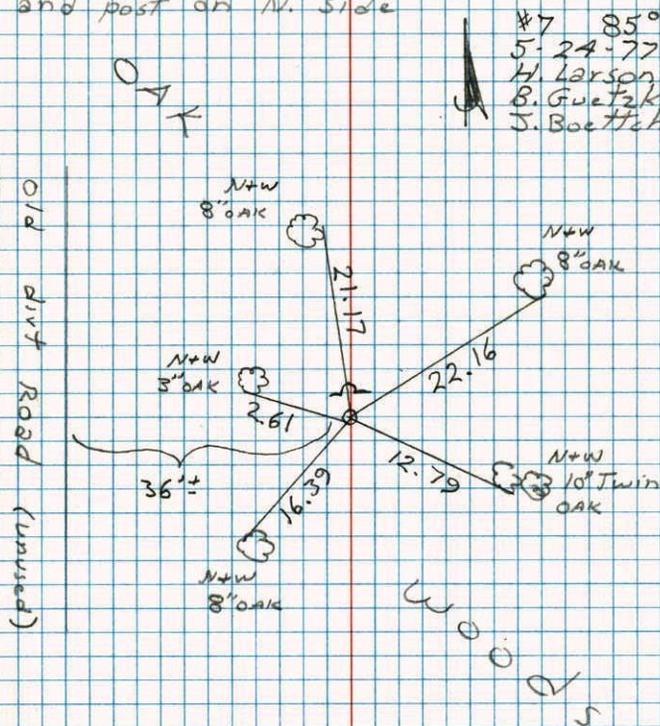

#7 85°  
5-24-77  
H. Larson  
B. Guetzko  
J. Boettcher

W<sup>1</sup>/<sub>4</sub> Cor. Sec. 15 T33 R23


Set cast iron monument from  
area resurvey. set warning sign

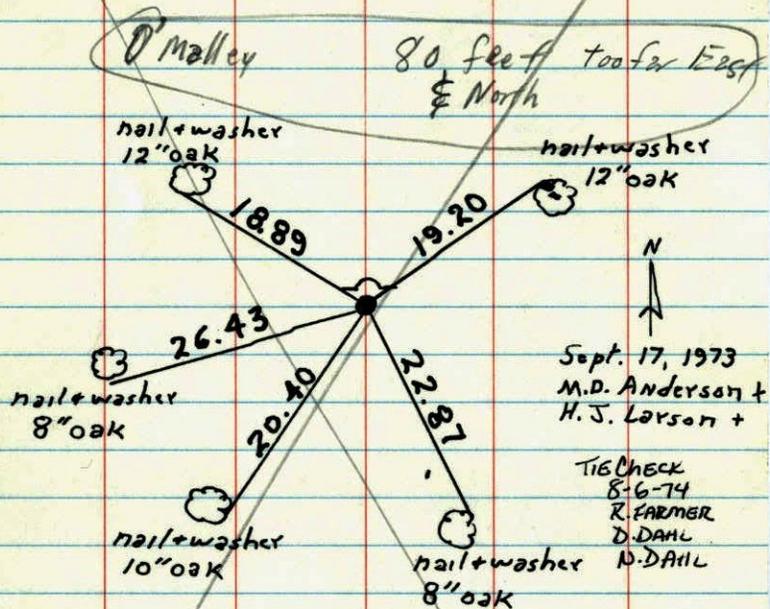

ROLAND W. ANDERSON COUNTY SURVEYOR  
ANOKA COUNTY, MINNESOTA

TEMPERATURE CORRECTED  
AND HORIZONTALLY  
TAPED MEASUREMENTS

W<sup>1</sup>/<sub>4</sub> Cor. Sec. 15-T33-R23  
set cast iron Mon. from area resurvey  
set steel sign post with warning sign

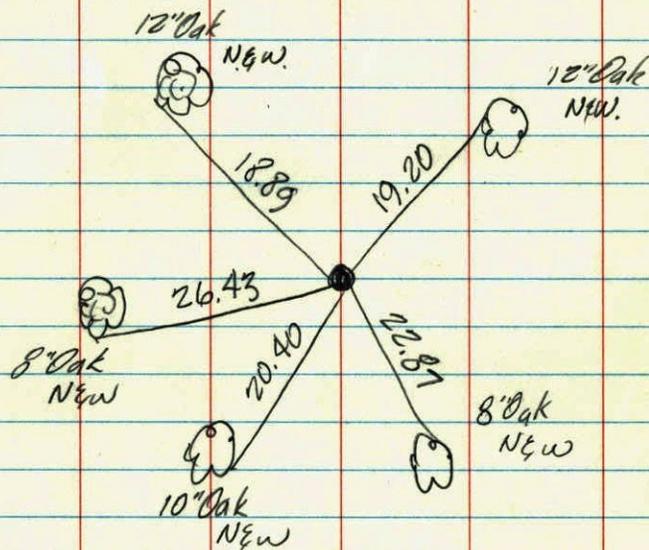

Sept. 17, 1973  
M.D. Anderson +  
H.J. Larson +