

# CERTIFICATE OF LOCATION OF GOVERNMENT CORNER

County of Anoka

State of Minnesota


East 1/4 Corner of Sec. 15 Township 33 Range 23

On the 27th day of June, 1973, the described corner was evidenced by area resurvey

and to perpetuate the location of said corner, at the exact location thereof, a permanent marker was placed consisting of a cast iron monument with a sign and post on the north side

AND on the 10th day of August, 2000, said permanent marker was found and the ties were updated

Updated reference ties are as shown below.

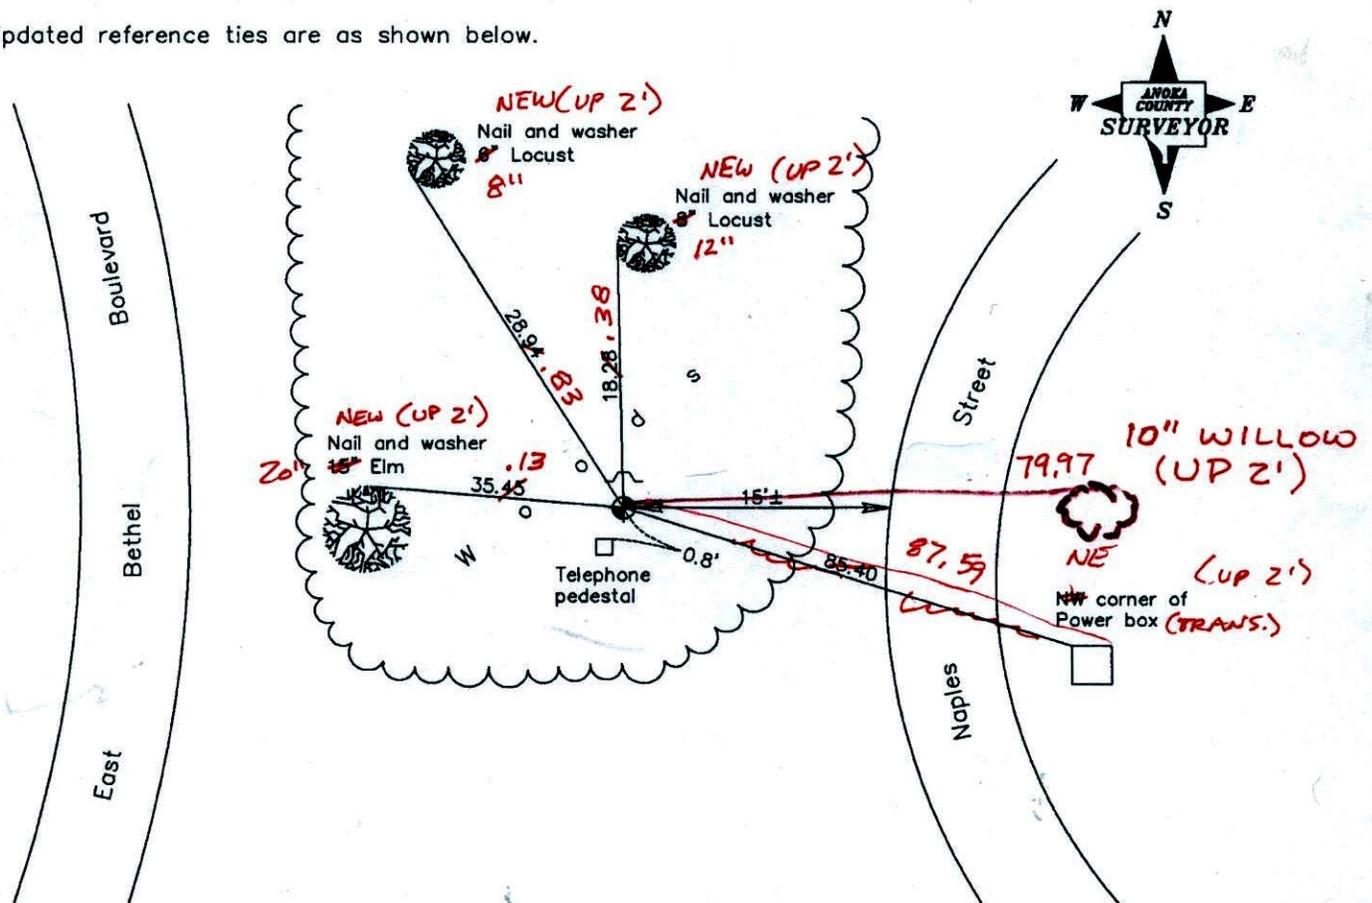

12-28-12

BK - SS

T/T

JRS

Revised date

8/04/92
8/04/97
8/10/00

N.A.D. 1983 Coordinates  
(1996 Adjustment)

County Project Coordinates	
Northing	<u>214240.6301</u>
Easting	<u>520943.0451</u>
Date	<u>4/05/02</u>

I hereby certify that this United States public land survey monument record is correct and complete to the best of my knowledge and belief.

*Larry D. Hoium* Date 8/10/00

\_\_\_\_\_  
Larry D. Hoium, Anoka County Surveyor  
Minnesota License Number 18165

VRS 3DQ = 0.08

N = 214240.4920

E = 520943.0018

# CERTIFICATE OF LOCATION OF GOVERNMENT CORNER

County of Anoka


State of Minnesota

EAST 1/4 Corner of Sec. 15 Township 33 Range 23

I hereby certify that on the 27 day of JUNE, 19 73, I found the described corner which was evidenced by AREA RESURVEY


and I further certify that to perpetuate the location of said corner, I did, at the exact location thereof, place a permanent marker consisting of CAST IRON MON. SIGN AND POST ON NORTH SIDE

which reference or witness monuments are located in the manner following:

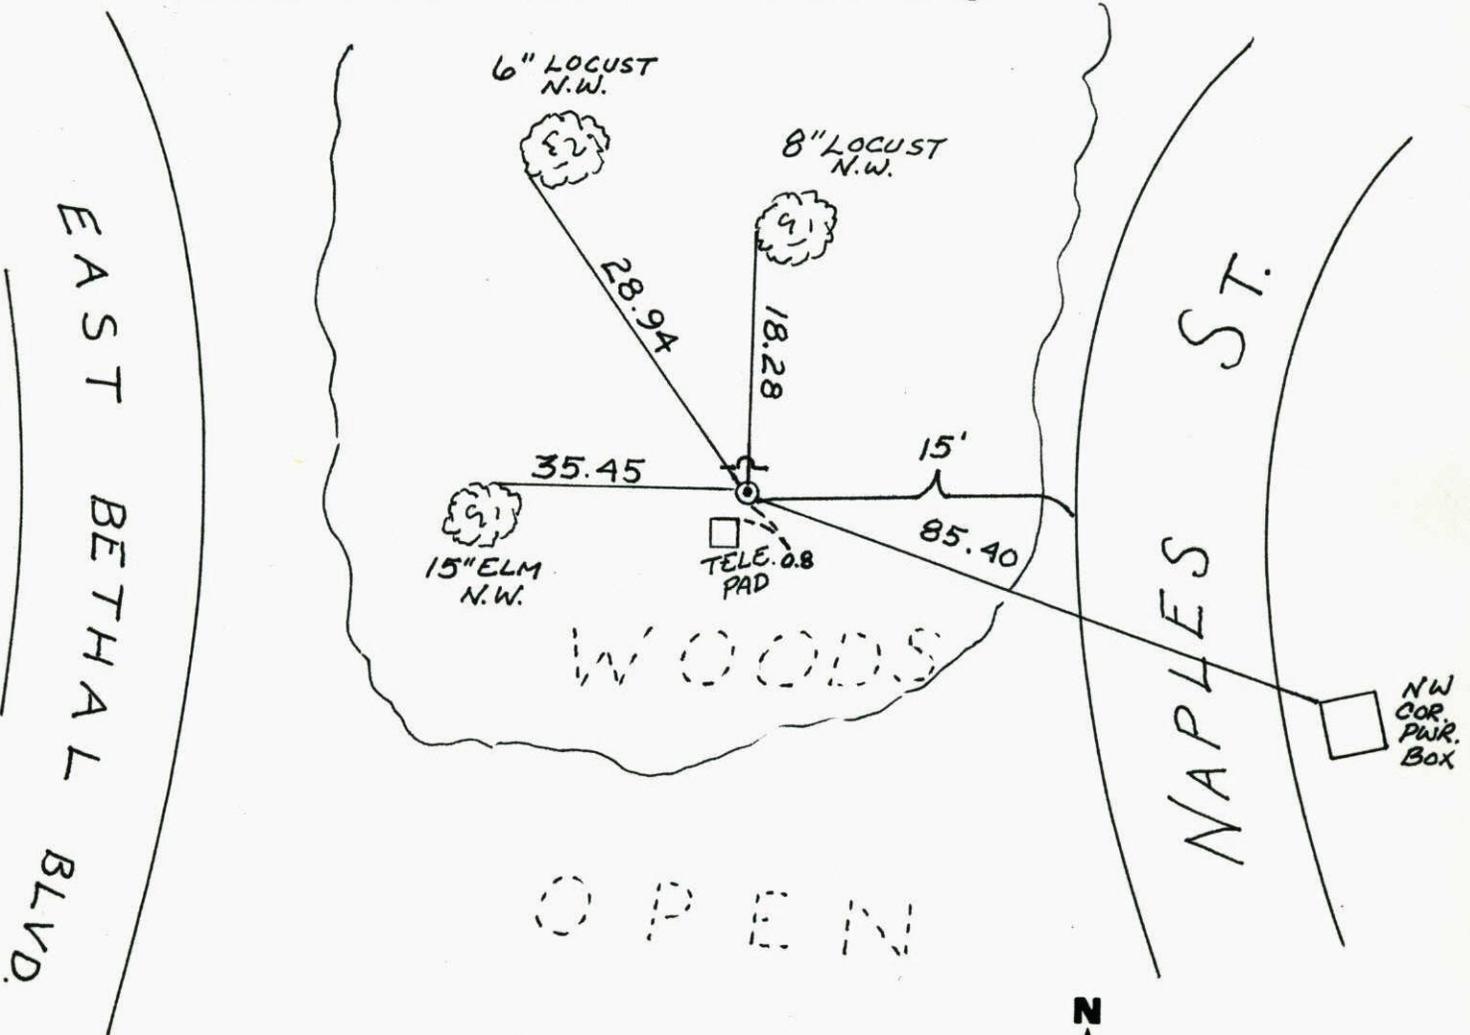


Revised date      Revised date      Revised date

8-4-92		
8-4-97		
8-10-00		

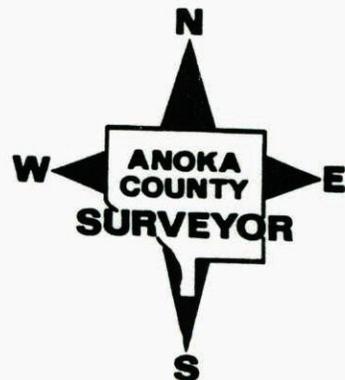

EAST 1/4 SEC. 15 T33R23

RETIED CAST IRON MON.

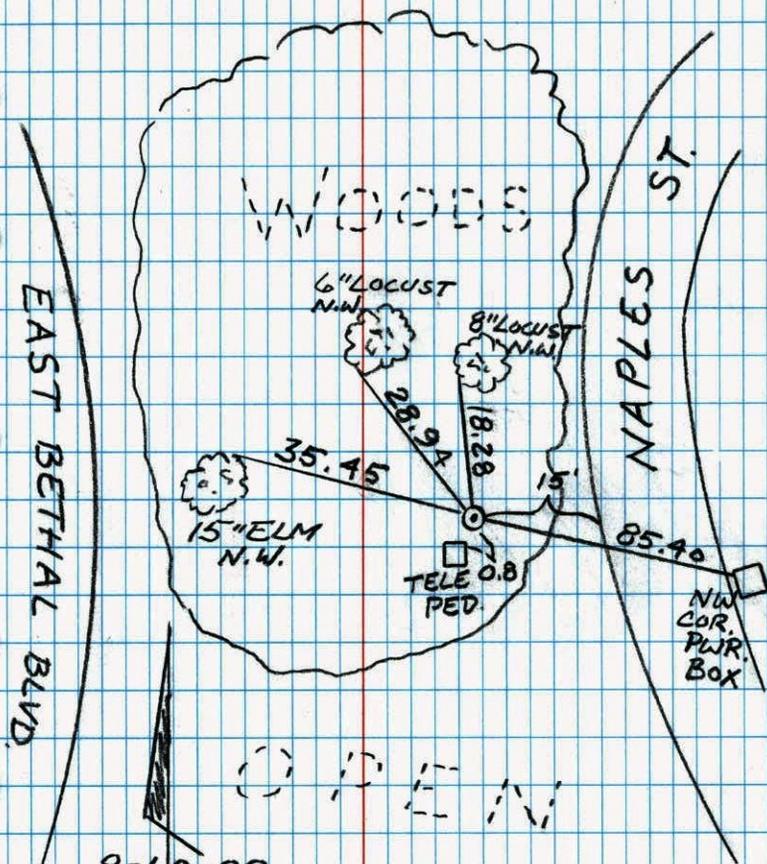

8-10-00


B. KLEMZ

T. SCHWAB

RETIE CAST IRON

EAST 1/4 S 15 T 33 R 23

W/ SIGN &amp; POST ON NORTH SIDE

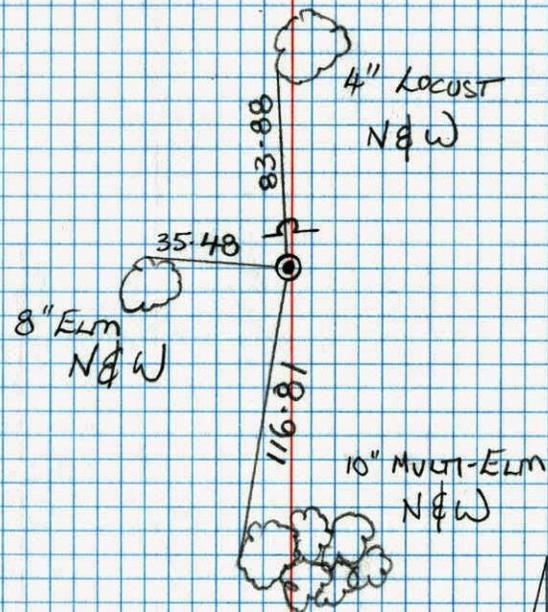


T. ZIMMERMAN

J. ANDERSON

8-4-92

East 1/4 Cor. Sec. 15 T33 R23

Found 1/2 iron pipe, used in area resurvey  
replaced with cast iron monument  
and warning sign.

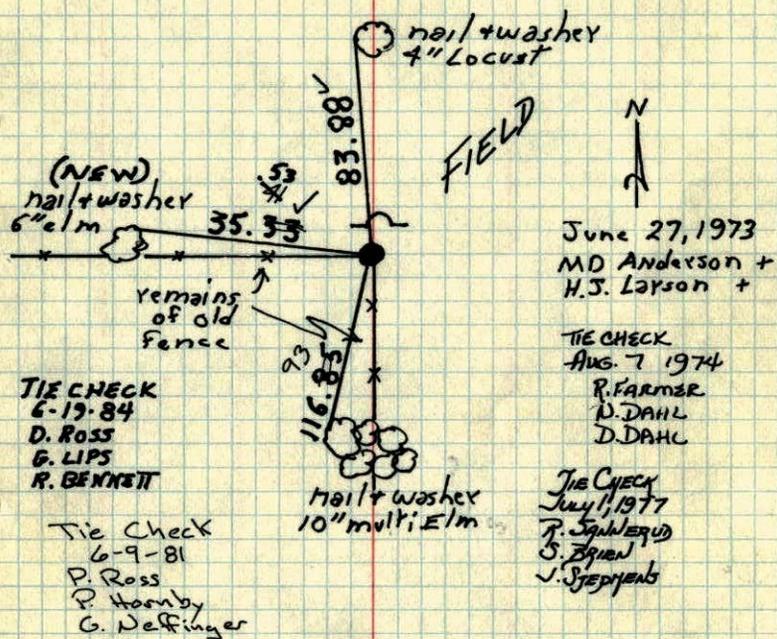

ROLAND W. ANDERSON  
COUNTY SURVEYOR  
ANOKA COUNTY, MINNESOTA

TEMPERATURE CORRECTED  
AND HORIZONTALLY  
TAPED MEASUREMENTS

E 1/4 Cor. Sec. 15-T33-R23

found 1 1/2" iron pipe, used in area resurvey  
Replaced with C.I. Mon.  
Set steel sign post with warning sign

