

CERTIFICATE OF LOCATION OF GOVERNMENT CORNER

County of Anoka

State of Minnesota


East $\frac{1}{4}$ Corner of Sec. 14 Township 33 Range 23

On the 28th day of October, 1970, the described corner was evidenced by area resurvey

and to perpetuate the location of said ✓ corner, at the exact location thereof, a permanent marker was placed consisting of a cast iron monument

AND on the 20th day of April, 2004, said permanent marker was found and the ties were updated

Updated reference ties are as shown below.

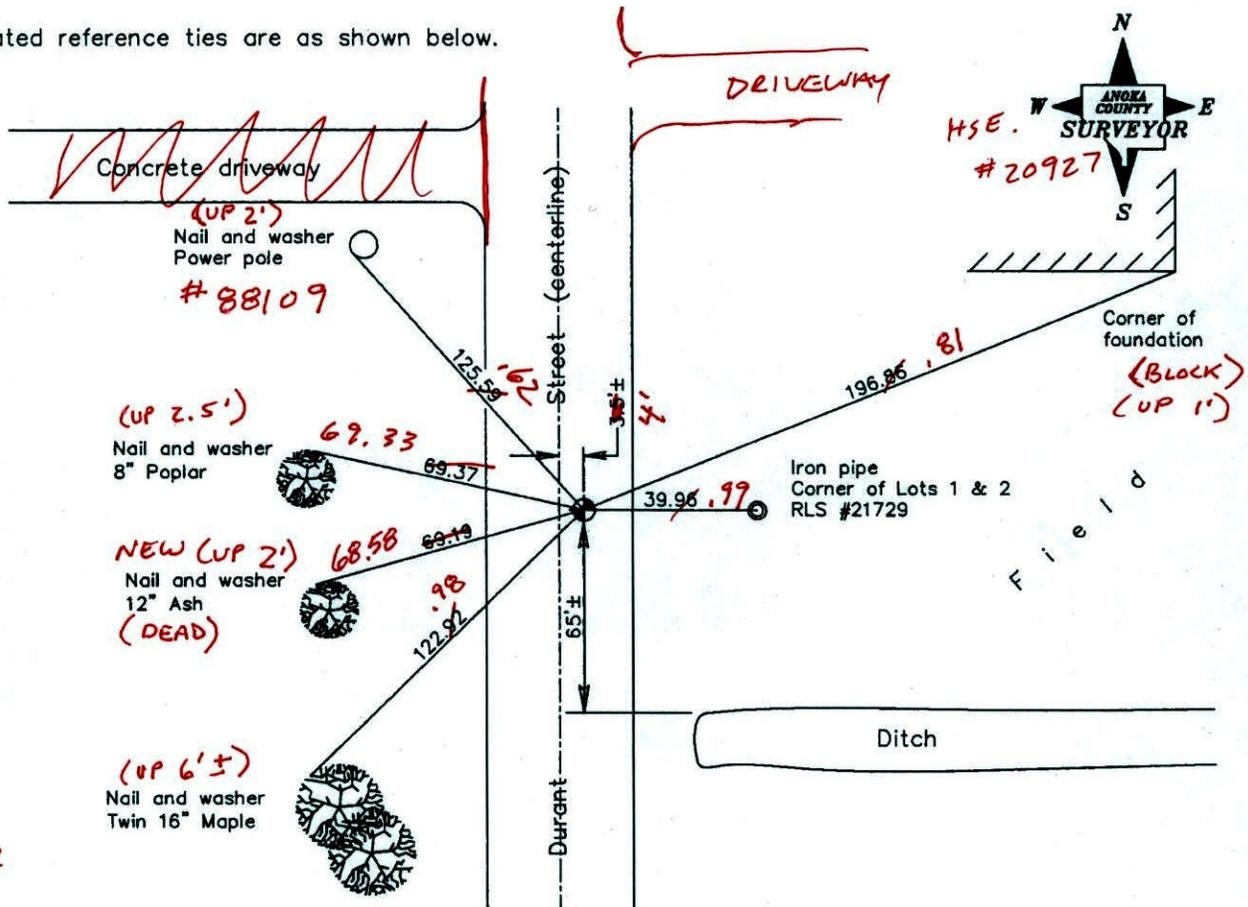

12-28-12
BK-55
T/T
VRS

Revised date
8/01/00
5/22/02
4/20/04

N.A.D. 1983 Coordinates (1996 Adjustment)	
County Project Coordinates	
Northing	214167.6755
Easting	526292.7667
Date	5/22/02

I hereby certify that this United States public land survey monument record is correct and complete to the best of my knowledge and belief.

Larry D. Hoium Date 5/22/02

Larry D. Hoium, Anoka County Surveyor
Minnesota License Number 18165

3DQ = 0.09 N = 214167.6651 E = 526292.7425

CERTIFICATE OF LOCATION OF GOVERNMENT CORNER

County of Anoka


State of Minnesota

EAST 1/4 Corner of Sec. 14 Township 33 Range 23


I hereby certify that on the 28 day of OCT., 19 70, I found the described corner which was evidenced by AREA RESURVEY

and I further certify that to perpetuate the location of said corner, I did, at the exact location thereof, place a permanent marker consisting of CAST IRON MON.

which reference or witness monuments are located in the manner following:

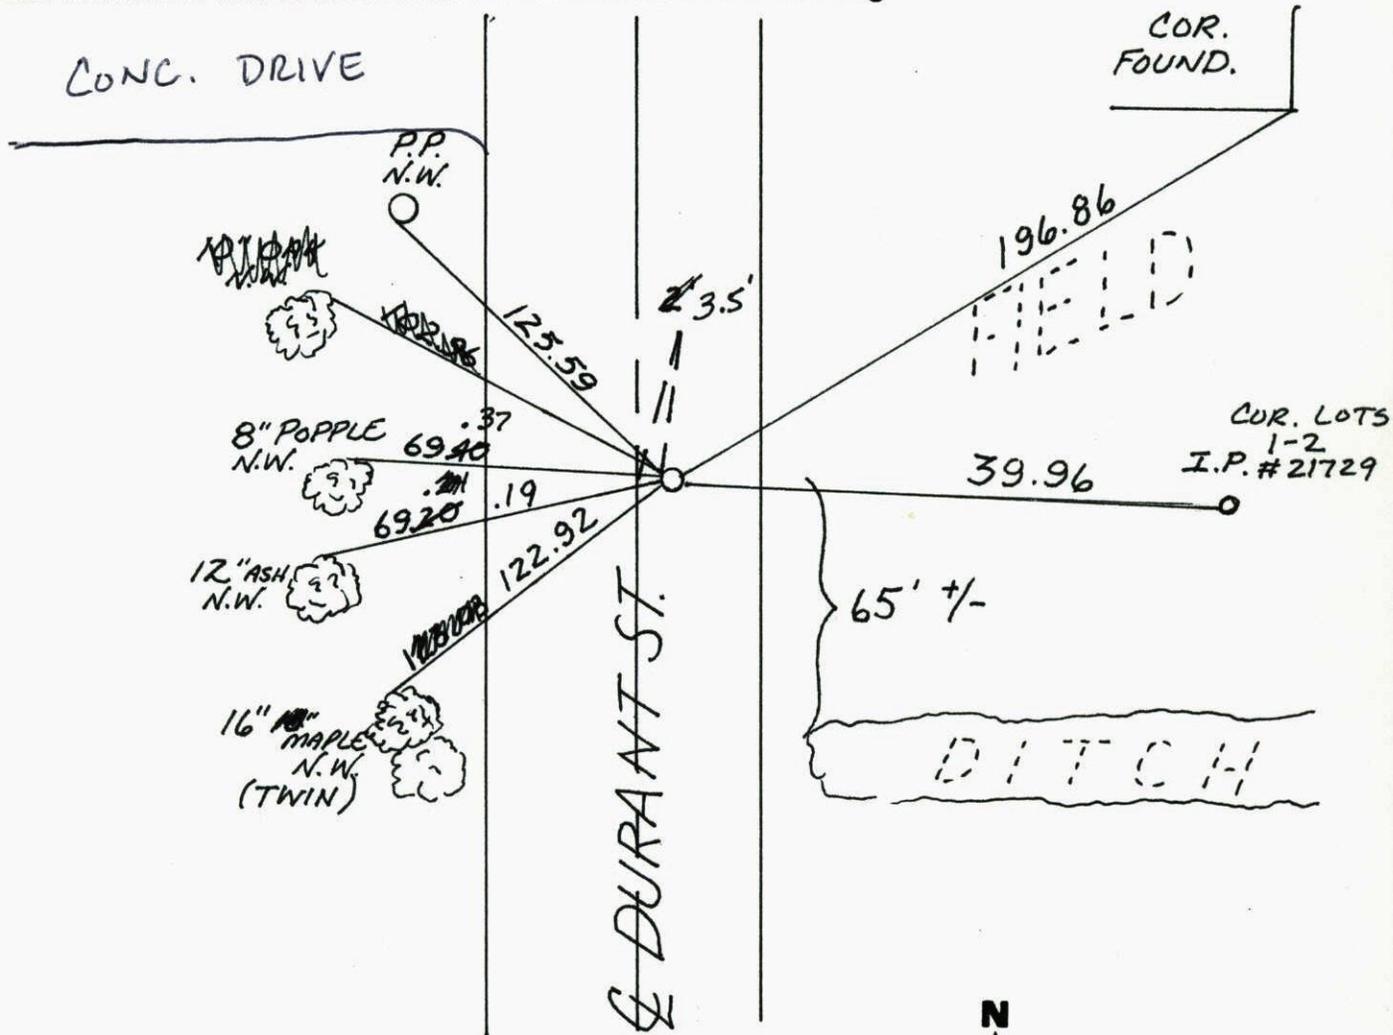


Revised date	Revised date	Revised date
8-10-92		
5-12-97		
8-1-00		
5-22-02		
4-20-04		

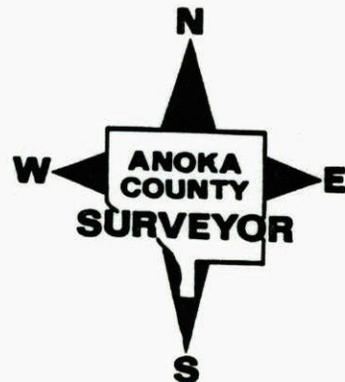

TRANSIT TIE
E 1/4 SEC 14 T 33 R 23


RETIED & PULLED CAST IRON
FOR CONSTRUCTION

4-20-04
J. SIMMER
B. KLEMMZ

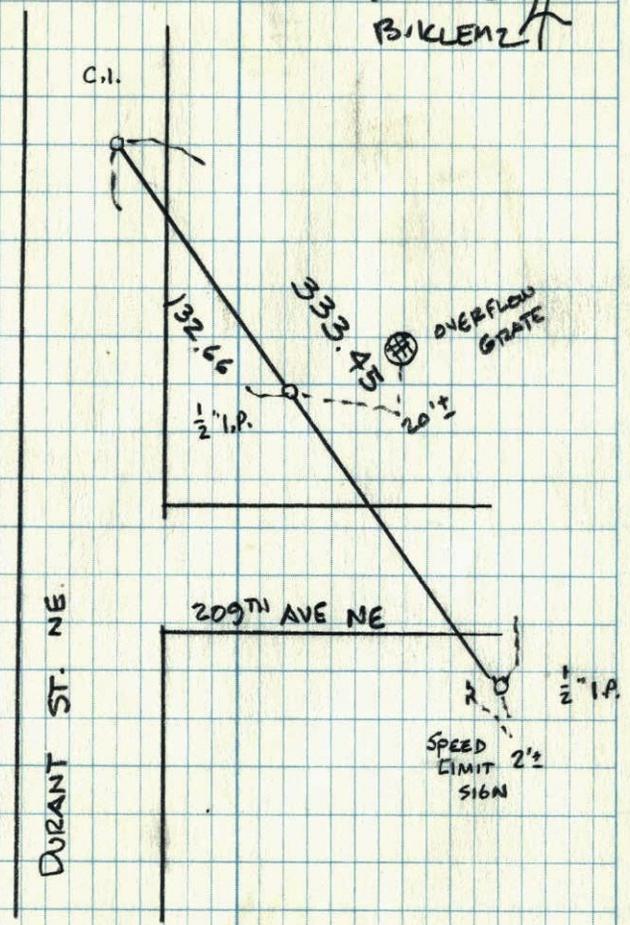

EAST 1/4 SEC. 14 T 33 R 23
RETIED CAST IRON MON.

NO. 418
TELEPHONE

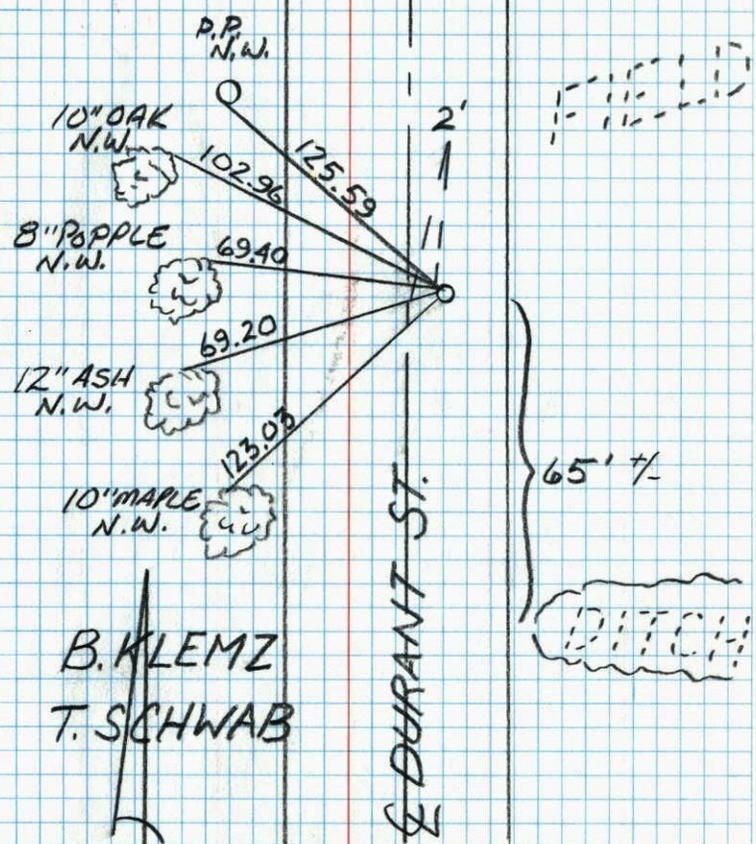

E 1/4 COR. SECTION 14 T33 R23


RESET CAST IRON MONUMENT AFTER CONSTRUCTION

SET FROM PRE-CONSTRUCTION SURVEY

PX: 2:00 N. AND E. C. 1/4 E. OF E

NO. 448

TELEPHONE

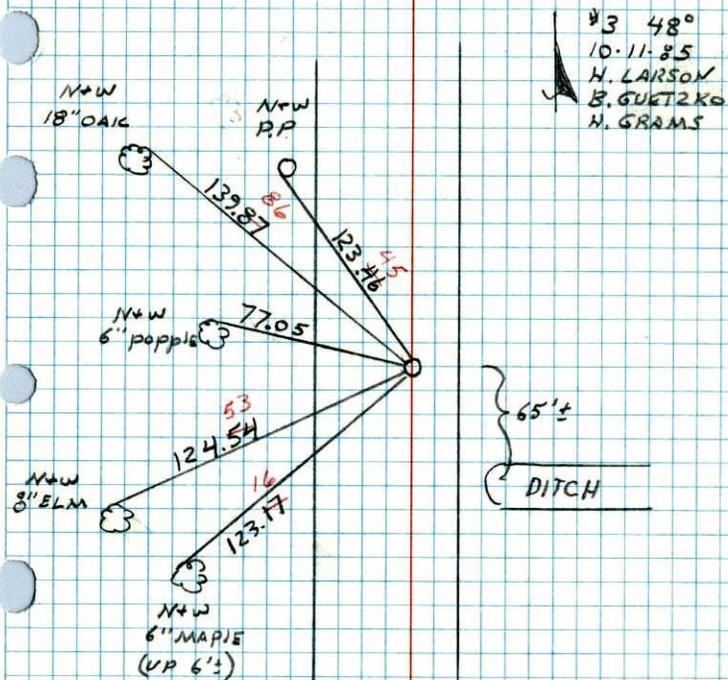

E
 W 1/4 Cor. Sec. 13-T33-R23


52

Set Cast Iron Monument down 0.5'± from
 area resurvey.

October 28, 1970
 M. D. Anderson
 H. J. Larson
 W. Westlander

Tie Check
 July 31 1974
 R. FARMER
 N. DAHL
 D. DAHL

TIE CHECK
 6-13-84
 D. ROSS
 G. LIPS
 R. BENNETT

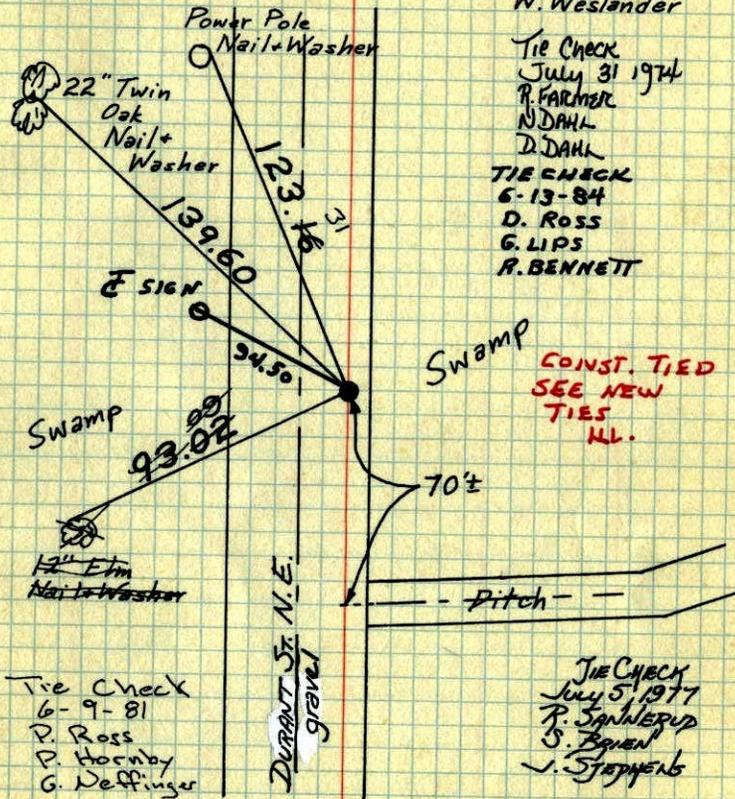


TEMPERATURE CORRECTED
 AND HORIZONTALLY
 TAPED MEASUREMENTS

ROLAND W. ANDERSON
 COUNTY SURVEYOR
 ANOKA COUNTY, MINNESOTA

E 14
W. 1/4 Cor. Sec. 15-133-R23

set Ch. Mon. down 0.5' ±

set Mon. from area recovery

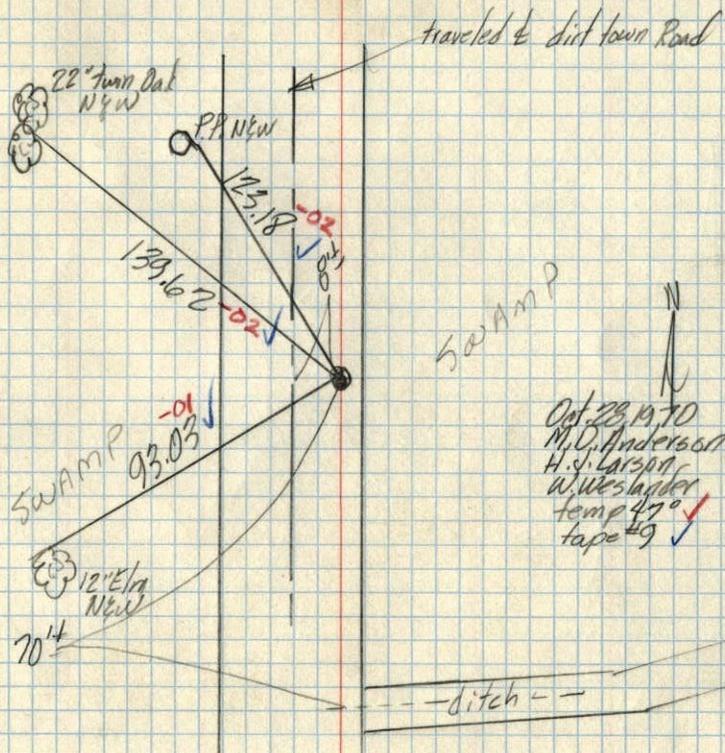

Oct. 28, 1970
M. O. Anderson
H. S. Larson
W. Weislander
temp 47°
tape #9 ✓