

CERTIFICATE OF LOCATION OF GOVERNMENT CORNER

County of Anoka State of Minnesota


North 1/4 Corner of Sec. 24 Township 33 Range 23

On the 28th day of October, 1970, the described corner was evidenced by area resurvey

and to perpetuate the location of said corner, at the exact location thereof, a permanent marker was placed consisting of a cast iron monument with a sign and post on the north side

AND on the ___ day of _____, _____, said permanent marker was _____

Updated reference ties are as shown below.

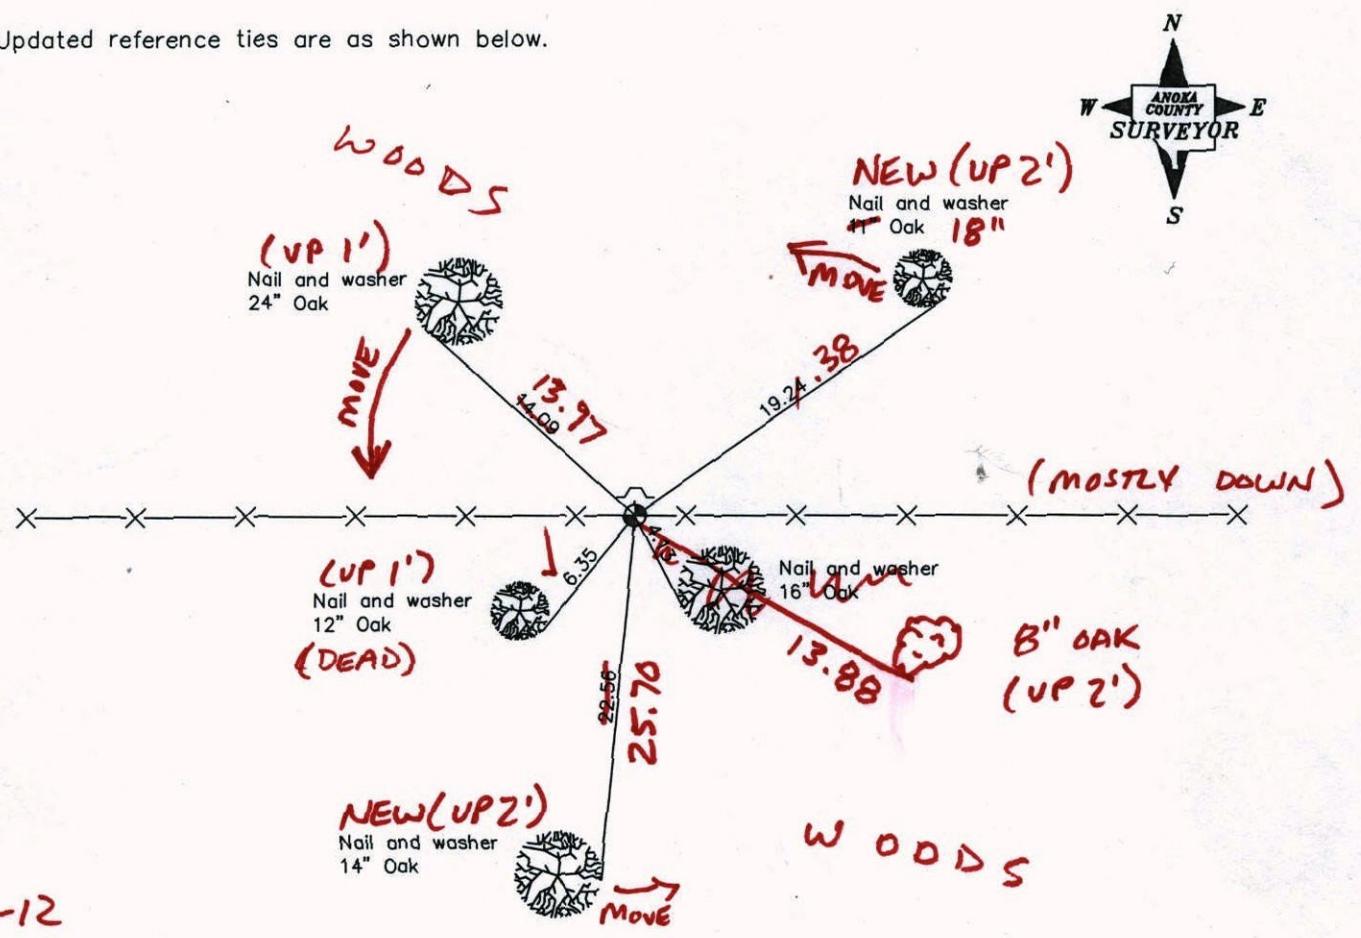

**8-2-12
BK-SS
TAPED**

Revised date
6/18/84
6/03/87
8/24/92

N.A.D. 1983 Coordinates (1996 Adjustment)	
County Project Coordinates	
Northing	211485.1086
Easting	529049.9853
Date	3/12/03

I hereby certify that this United States public land survey monument record is correct and complete to the best of my knowledge and belief.

Date _____
_____, Anoka County Surveyor
Minnesota License Number _____

CERTIFICATE OF LOCATION OF GOVERNMENT CORNER

County of Anoka


State of Minnesota

NORTH 1/4 Corner of Sec. 24 Township 33 Range 23


I hereby certify that on the 28 day of OCTOBER, 1970, I found the described corner which was evidenced by AREA RESURVEY


and I further certify that to perpetuate the location of said corner, I did, at the exact location thereof, place a permanent marker consisting of CAST IRON MONUMENT WITH SIGN AND POST ON THE NORTH SIDE

which reference or witness monuments are located in the manner following:

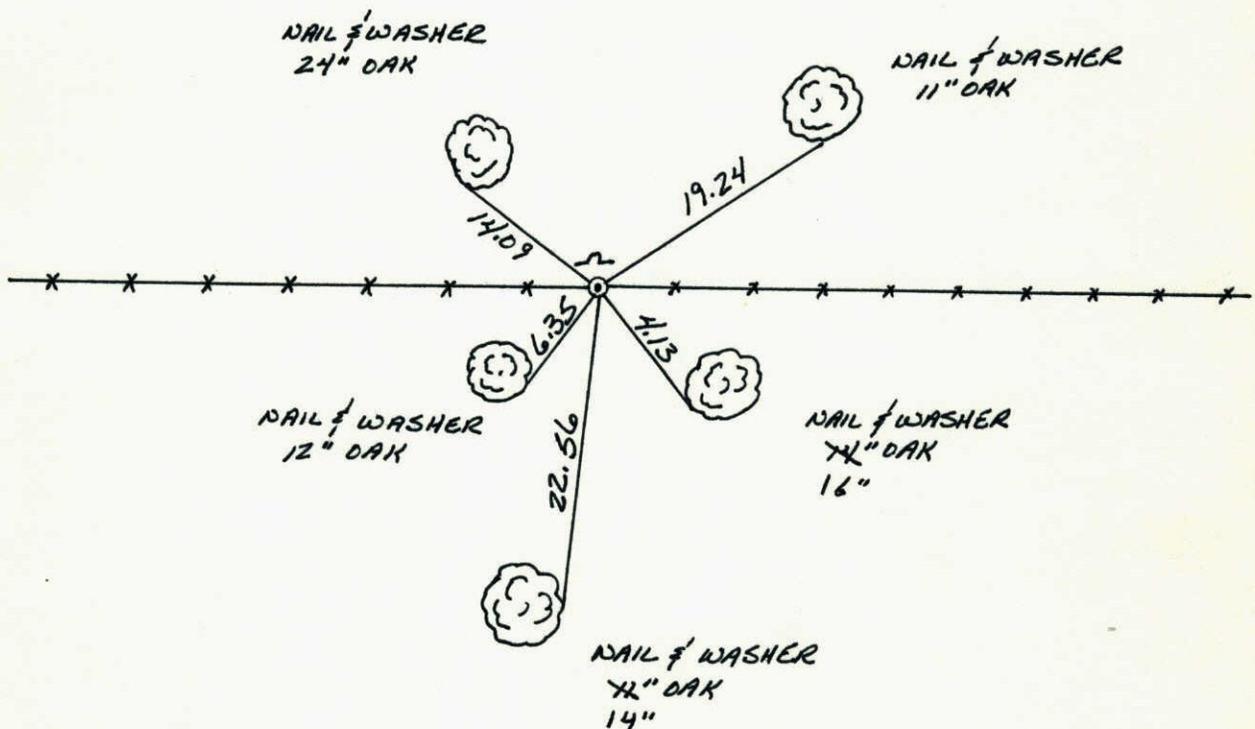


Revised date	Revised date	Revised date
7-30-74		
7-5-77		
6-22-81		
6-18-84		
6-3-87		
8-24-92		

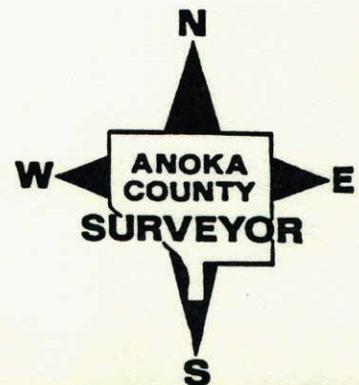

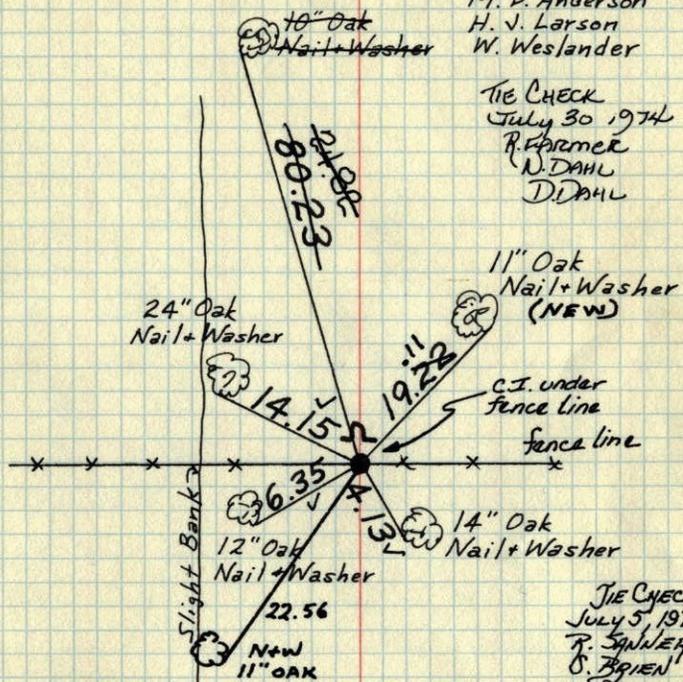N $\frac{1}{4}$ Cor. Sec. 24-T33-R23Set Cast Iron Monument flush from area resurvey.Sign Post + Warning Sign $\frac{1}{2}$ North of Monument.October 28, 1970
M. D. Anderson
H. J. Larson
W. WestlanderTIE CHECK
July 30, 1974
R. FARMER
N. DAHL
D. DAHLTie Check
6-22-81
P. Ross
P. Hornby
G. NeffingerTIE CHECK
JULY 5, 1977
P. SANJERUD
G. BRIEN
J. STEPHENS
TIE CHECK
6-18-84
D. ROSS
G. LIPS
R. BENNETTTEMPERATURE CORRECTED
AND HORIZONTALLY
TAPED MEASUREMENTSROLAND W. ANDERSON
COUNTY SURVEYOR
ANOKA COUNTY, MINNESOTAN $\frac{1}{4}$ Cor. Sec. 24-T33-R23

set C.I. Mon. flush

set Cor. from area resurvey

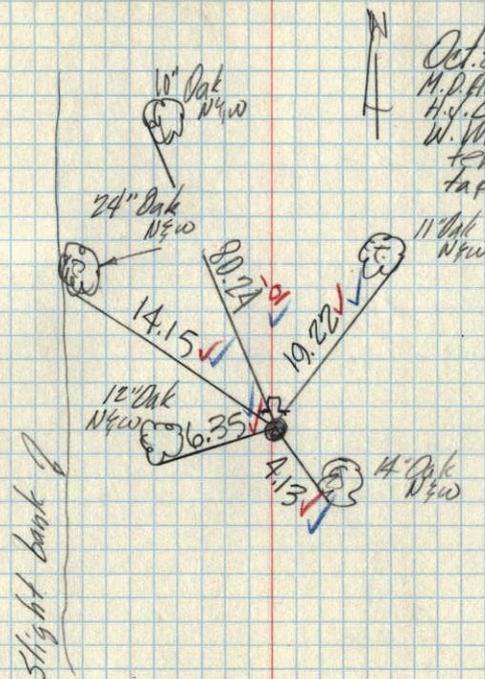sign post & warning sign $\frac{1}{2}$ N of Mon.Oct. 28, 1970
M. D. Anderson
H. J. Larson
W. Westlander
temp. 45.0
tape # 9TEMPERATURE CORRECTED
AND HORIZONTALLY
TAPED MEASUREMENTSROLAND W. ANDERSON
COUNTY SURVEYOR
ANOKA COUNTY, MINNESOTA