Page No. 56

CERTIFICATE OF LOCATION OF GOVERNMENT CORNER

County of Anoka State of Minnesota

Southeast Corner of Sec. 14 Township 33 Range 23

On the 28th day of October, 1970, the described corner was evidenced by area resurvey

and to perpetuate the location of said corner, at the exact location thereof, a permanent marker was placed consisting of a cast iron monument (4' ± E. OF ℄)

AND on the 21st day of April, 2004, said permanent marker was found and the ties were updated

Updated reference ties are as shown below.

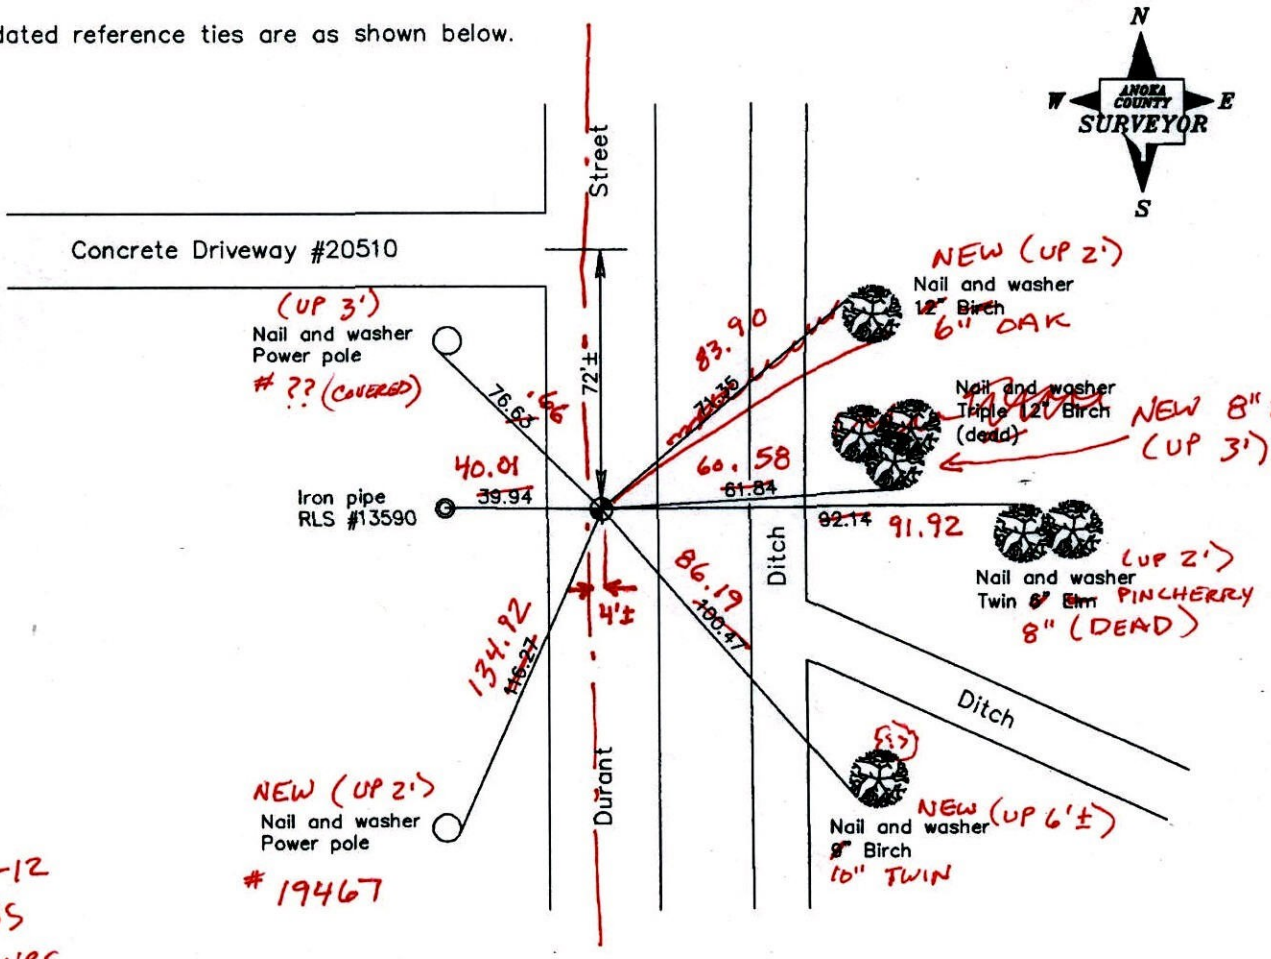

12-28-12
BK-55
T/T - URS

Revised date
5/12/97
5/22/02
4/21/04

N.A.D. 1983 Coordinates (1996 Adjustment)

County Project Coordinates	
Northing	211511.3452
Easting	526336.4926
Date	5/22/02

I hereby certify that this United States public land survey monument record is correct and complete to the best of my knowledge and belief.

Date 4/21/04

Larry D. Holum, Anoka County Surveyor

Minnesota License Number 18165

3DQ = 0.04 N = 211511.2807 E = 526336.5501

Page No. 56

CERTIFICATE OF LOCATION OF GOVERNMENT CORNER

County of Anoka *State of Minnesota*

South East Corner of Sec. 14 Township 33 Range 23

I hereby certify that on the 28 *day of* October, 1970, *I found the described corner which was evidenced by* area resurvey

and I further certify that to perpetuate the location of said corner, I did, at the exact location thereof, place a permanent marker consisting of cast iron

which reference or witness monuments are located in the manner following:

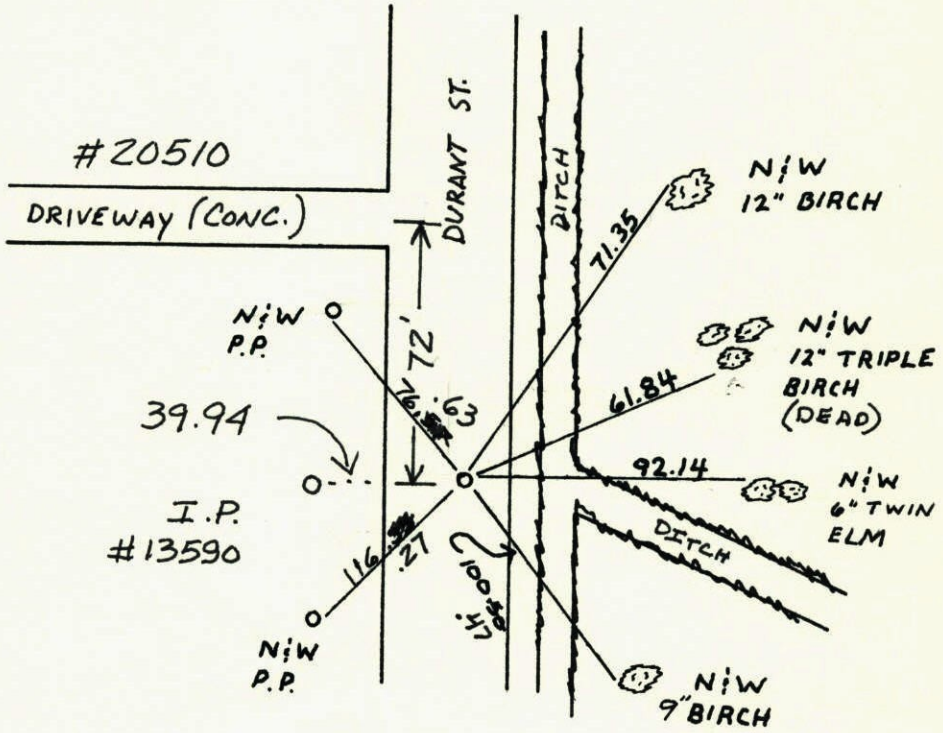

Revised date	By
10-10-85	H. Larson
8-18-86	D. Ross
8-10-92	
5-12-97	HL · Bk · JS
5-22-02	
4-21-04	

RAISED

Minnesota State Plane Coordinates
South Zone

Y _____ X _____

_____ , _____

County Surveyor *Date*

Registered Land Surveyor No. _____

1/83

TRANSIT TIE 56

S. E. COR SEC 14 T 33 R 23

RETIED + PULLED CAST IRON FOR CONSTRUCTION.

4-20-04
J. SIMMER
R. KLEIN

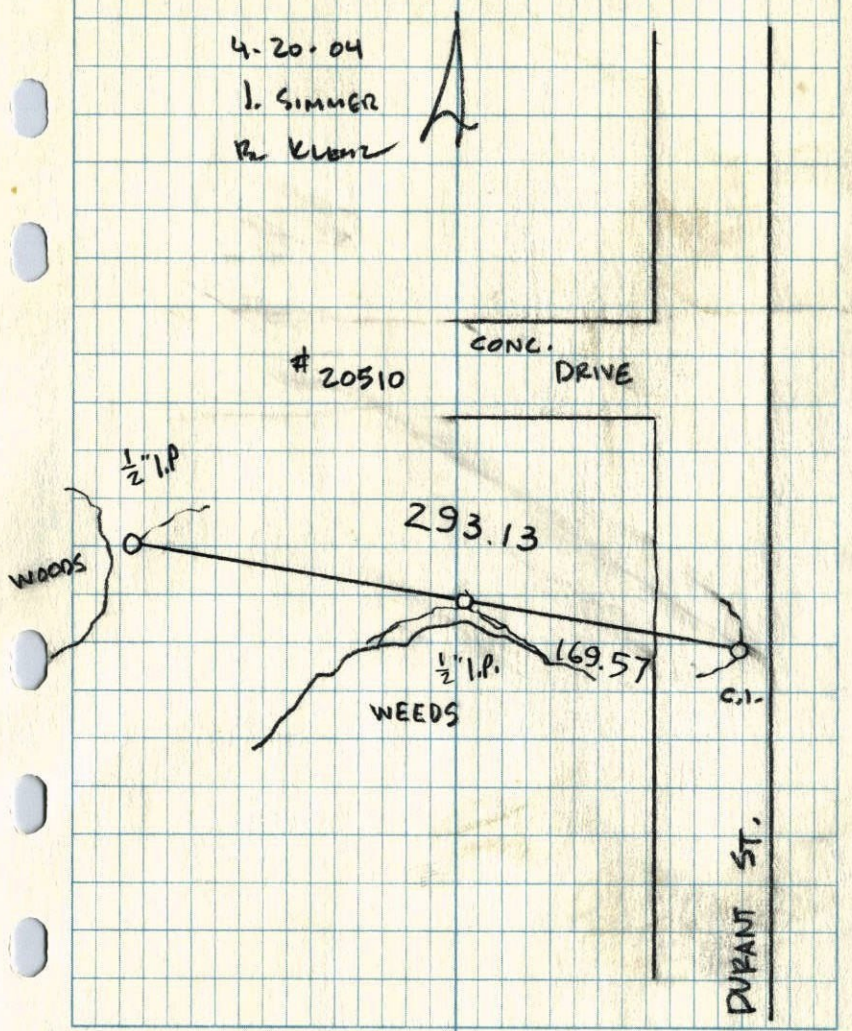

SE. COR. SECTION 14 T33 R23

RESET CAST IRON MONUMENT AFTER CONSTRUCTION SET FROM PRE-CONSTRUCTION SURVEY PKs 2.00' N. & 2.00' E.

C.I. 3.5' E. OF ℄

#3 45°
10-10-85
W. LARSON
B. GUETZKO
W. GRAMS

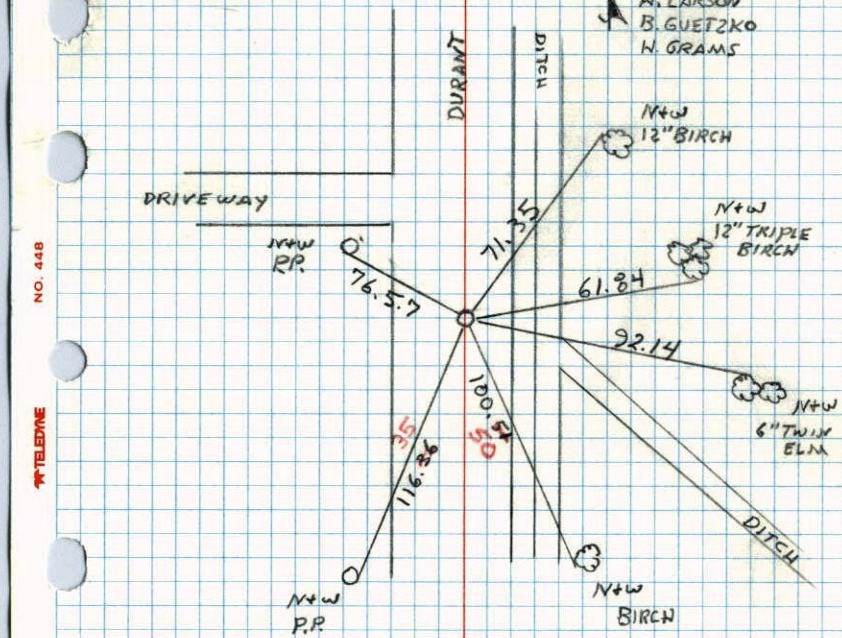

NO. 448 TELEDYNE

56

SE 14

~~NW~~ Cor. Sec. ~~24~~ - T33 - R23

Set Cast Iron Monument down 0.5'± in ℄ of Road.

Set from area resurvey.

October 28, 1970
M. D. Anderson
H. V. Larson
W. Weslander

CONST. TIED
SEE NEW TIES
N. L.

P.P. N&W

TIE CHECK
7-30-74
R. FARMER
D. DAHL
N. DAHL

TIE CHECK
JULY 5, 1977
R. SJNNERUD
J. BRIEN
J. STEPHENS

Tie Check
6-11-81
P. Ross
P. Hornby
G. Neffinger

TIE CHECK
6-13-84
D. ROSS
G. LIPS
R. BENNETT

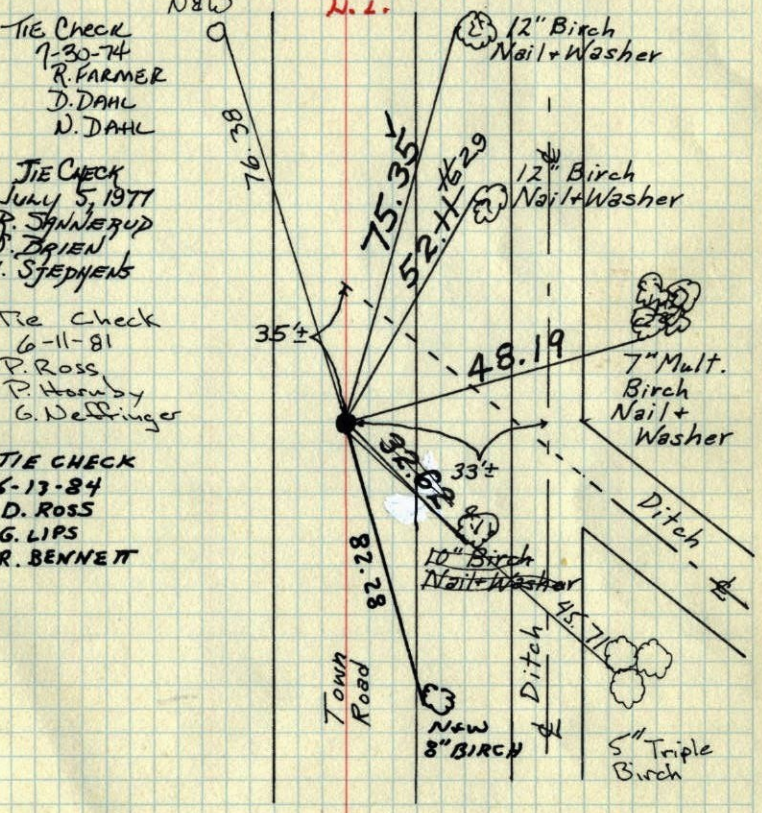

TEMPERATURE CORRECTED AND HORIZONTALLY TAPED MEASUREMENTS

ROLAND W. ANDERSON
COUNTY SURVEYOR
ANOKA COUNTY, MINNESOTA

14

SE

~~NW~~ Cor. Sec. ~~24~~ T33 - R23

Set Cast Iron Mon. down 0.5'± in ℄ Rd.

Set from area resurvey

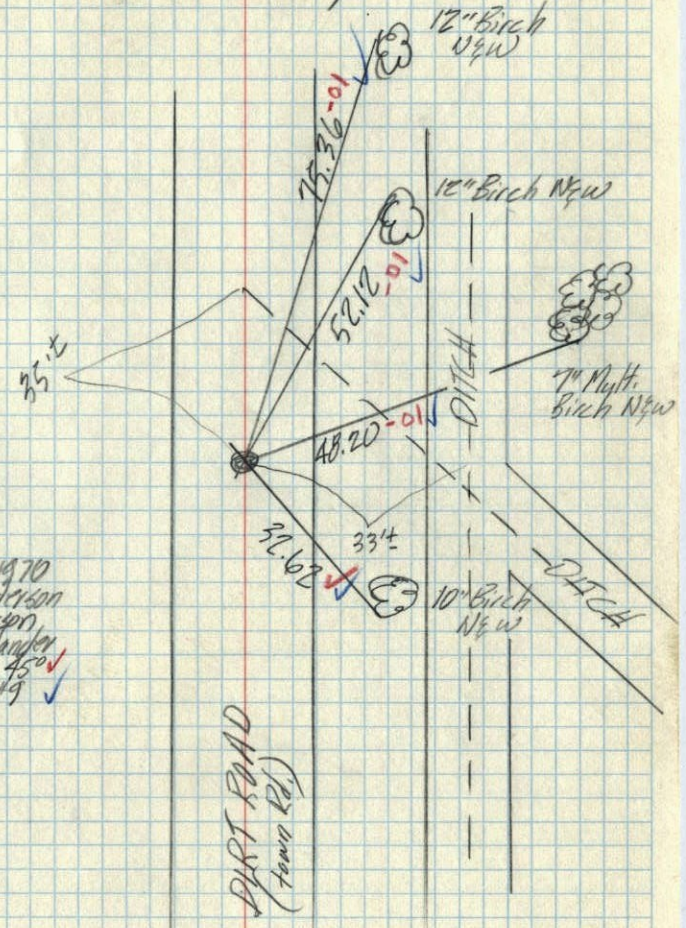

Oct 28 1970
M. D. Anderson
H. V. Larson
W. Weslander
temp. 45° ✓
taping ✓