

CERTIFICATE OF LOCATION OF GOVERNMENT CORNER

County of Anoka


State of Minnesota

W.C. ON SOUTH LINE Corner of Sec. 14 Township 33 Range 23


I hereby certify that on the 10 day of APRIL, 1989, I found the described corner which was evidenced by AREA RESURVEY

and I further certify that to perpetuate the location of said corner, I did, at the exact location thereof, place a permanent marker consisting of CAST IRON MONUMENT SIGN AND POST ON NORTH SIDE

which reference or witness monuments are located in the manner following:

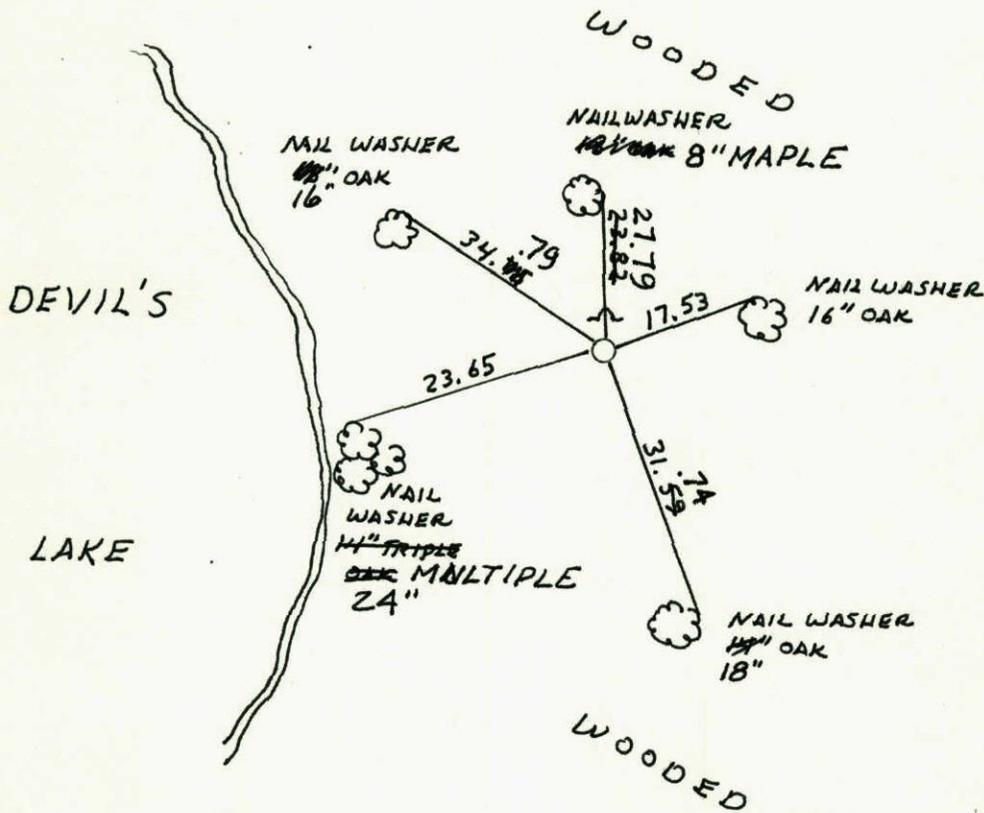

Revised date	Revised date	Revised date
4-10-89 HL		
8-10-00		

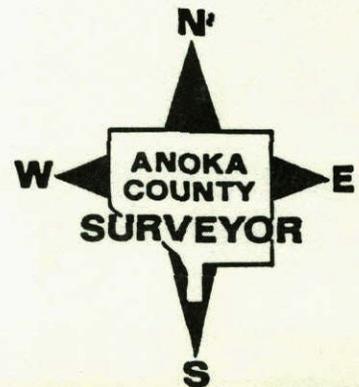

W.C. ON SOUTH LINE SECTION 14 T33 R23

SET CAST IRON MON. FROM AREA RESURVEY
SIGN AND POST ON NORTH SIDE

4-10-89

H.L.

NO. 448

TELEPHONE

