

CERTIFICATE OF LOCATION OF GOVERNMENT CORNER

County of Anoka

State of Minnesota


South 1/4 Corner of Sec. 16 Township 33 Range 23

On the 16th day of November, 1970, the described corner was evidenced by a scrap iron pipe with an eye on top

and to perpetuate the location of said corner, at the exact location thereof, a permanent marker was placed consisting of a cast iron monument down 2'± (MON. ON W. SIDE OF FENCE 0.5'±)

AND on the 26th day of March, 2003, said permanent marker was found and the ties were updated

Updated reference ties are as shown below.

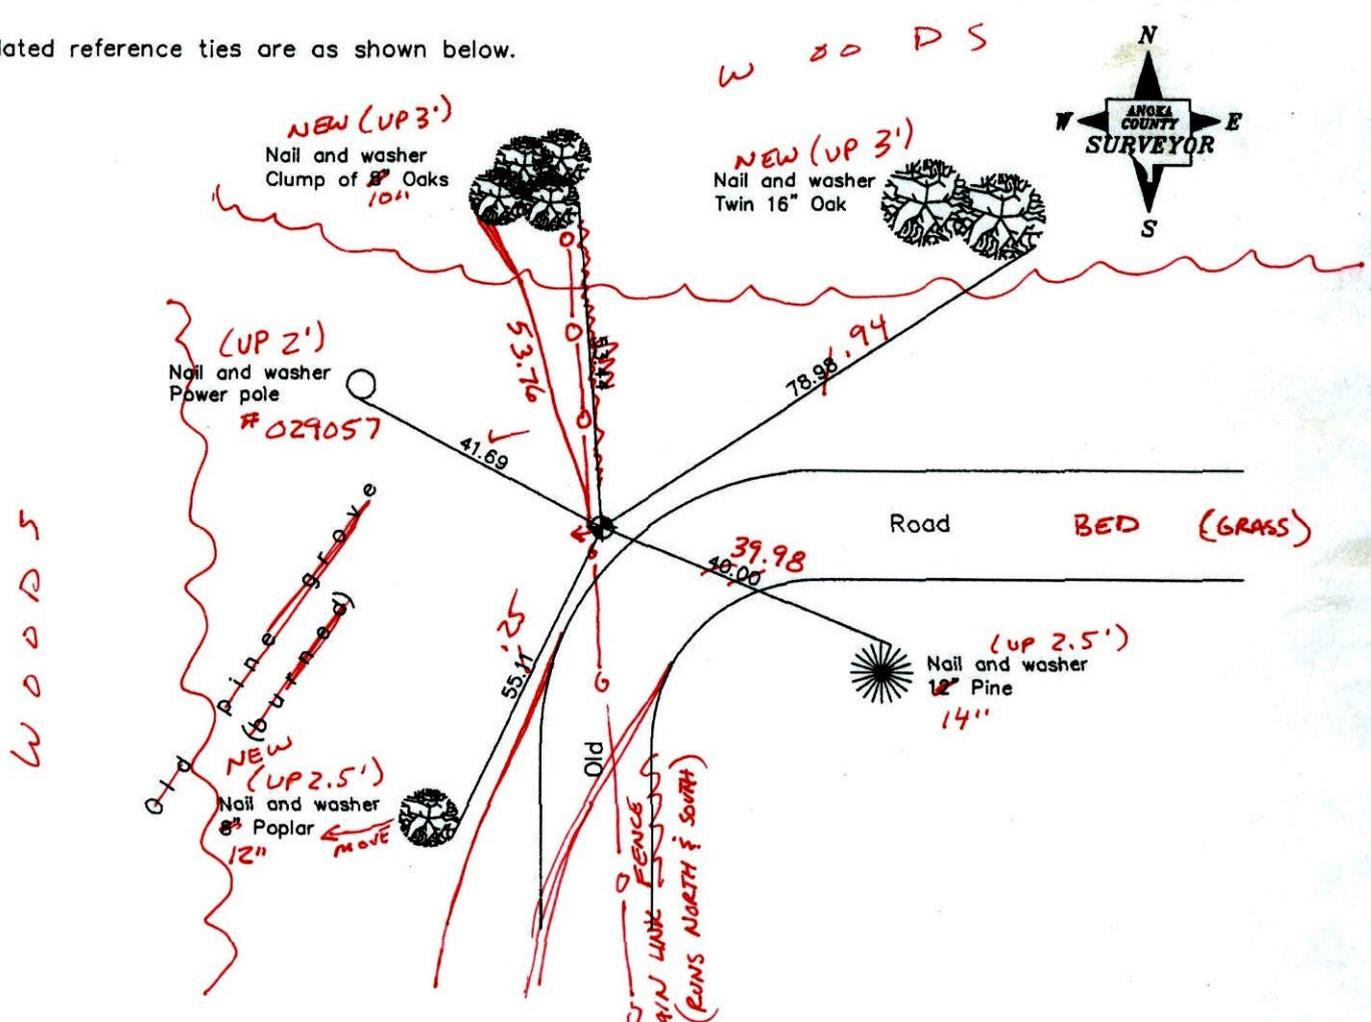

4-24-13
BK-SS
TAPED

Revised date
6/05/87
3/09/92
3/26/03

N.A.D. 1983 Coordinates (1996 Adjustment)	
County Project Coordinates	
Northing	211611.0094
Easting	513019.3688
Date	3/26/03

I hereby certify that this United States public land survey monument record is correct and complete to the best of my knowledge and belief.

Larry D. Hoium Date 3/26/03

Larry D. Hoium, Anoka County Surveyor

Minnesota License Number 18165

CERTIFICATE OF LOCATION OF GOVERNMENT CORNER

County of Anoka


State of Minnesota

SOUTH 1/4 Corner of Sec. 16 Township 33 Range 23


I hereby certify that on the 16 day of NOV., 1970, I found the described corner which was evidenced by SCRAP I.P. WITH EYE ON TOP

and I further certify that to perpetuate the location of said corner, I did, at the exact location thereof, place a permanent marker consisting of CAST IRON MONUMENT DOWN ~~2~~ 2

which reference or witness monuments are located in the manner following:

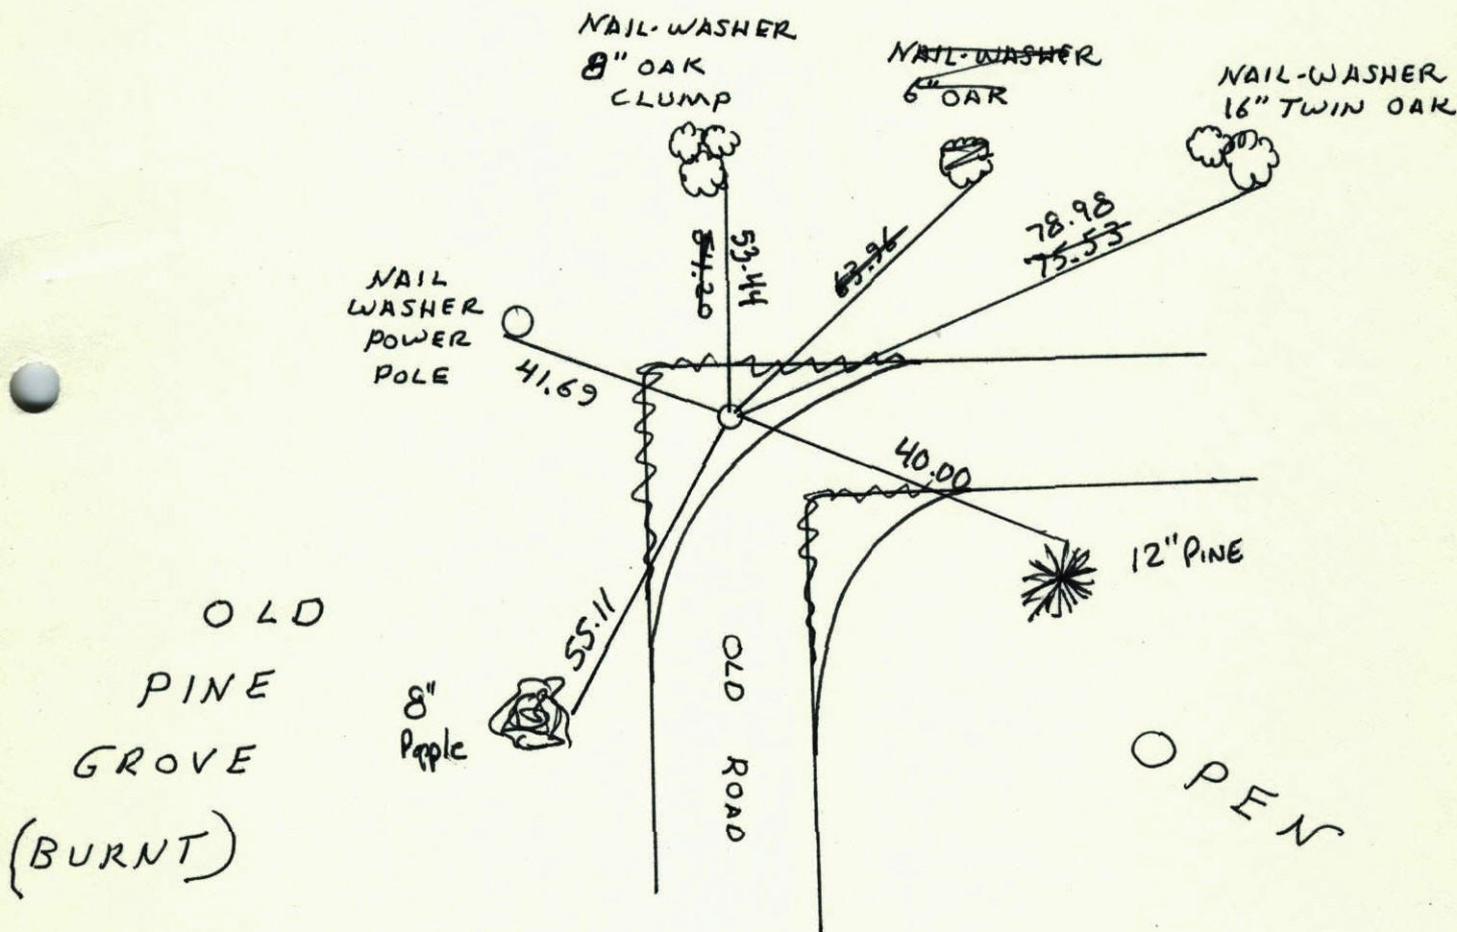

Revised date	Revised date	Revised date
6-5-87		
3-9-92		
3-26-03		

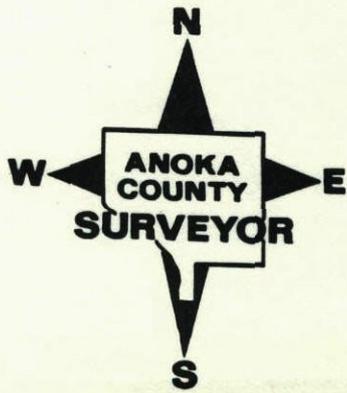

S¹/₄ Cor. Sec. 16-T33-R23

Found piece of scrap iron with eye in top down 0.5'±


Used Cor. in area resurvey

Nov. 16, 1970

M. D. Anderson
W. Weslander

Get Cast Iron in Place
Aug. 6 1974 Down 1.5'±

R. FARMER
N. DAHL
D. DAHL

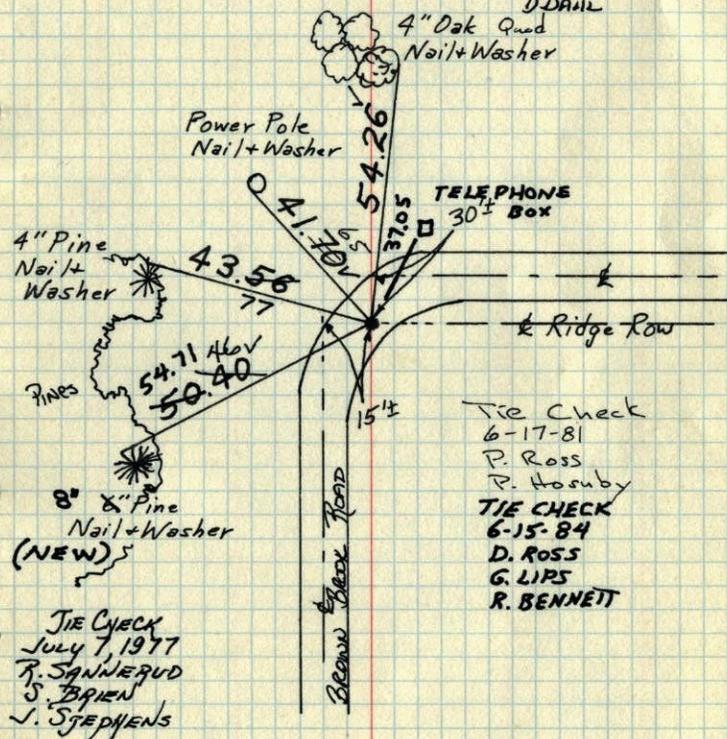


TEMPERATURE CORRECTED
AND HORIZONTALLY
TAPED MEASUREMENTS

ROLAND W. ANDERSON
COUNTY SURVEYOR
ANOKA COUNTY, MINNESOTA

S¹/₄ Cor. Sec. 16-T. 33-R. 23

Found piece of scrap iron with eye in top
down 0.5'±

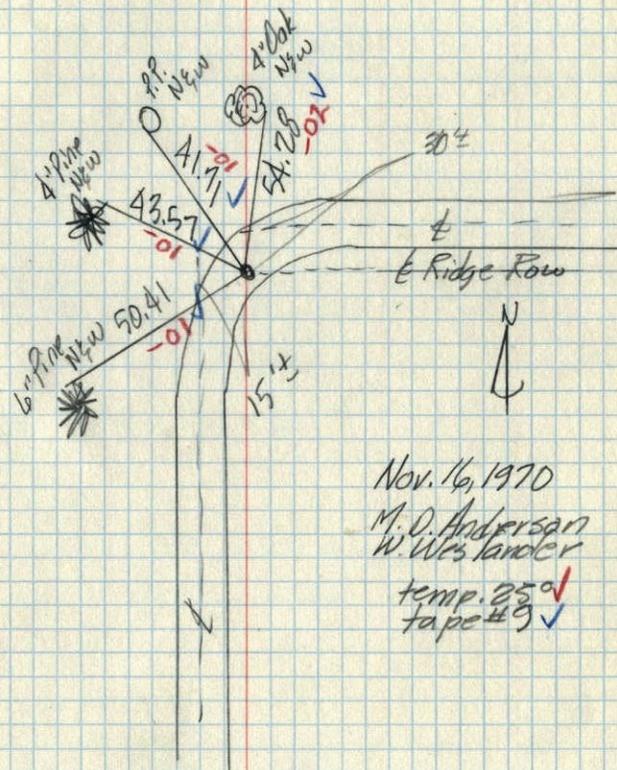

Nov. 16, 1970
M. D. Anderson
W. Weslander