

# CERTIFICATE OF LOCATION OF GOVERNMENT CORNER

County of Anoka                      State of Minnesota


West 1/4 Corner of Sec. 22 Township 33 Range 23

On the 2nd day of June, 1960, the described corner was evidenced by an old gun barrel

and to perpetuate the location of said corner, at the exact location thereof, a permanent marker was placed consisting of a cast iron monument (down 2'±)

AND on the 26th day of June, 2000, said permanent marker was found and the ties were updated

Updated reference ties are as shown below.

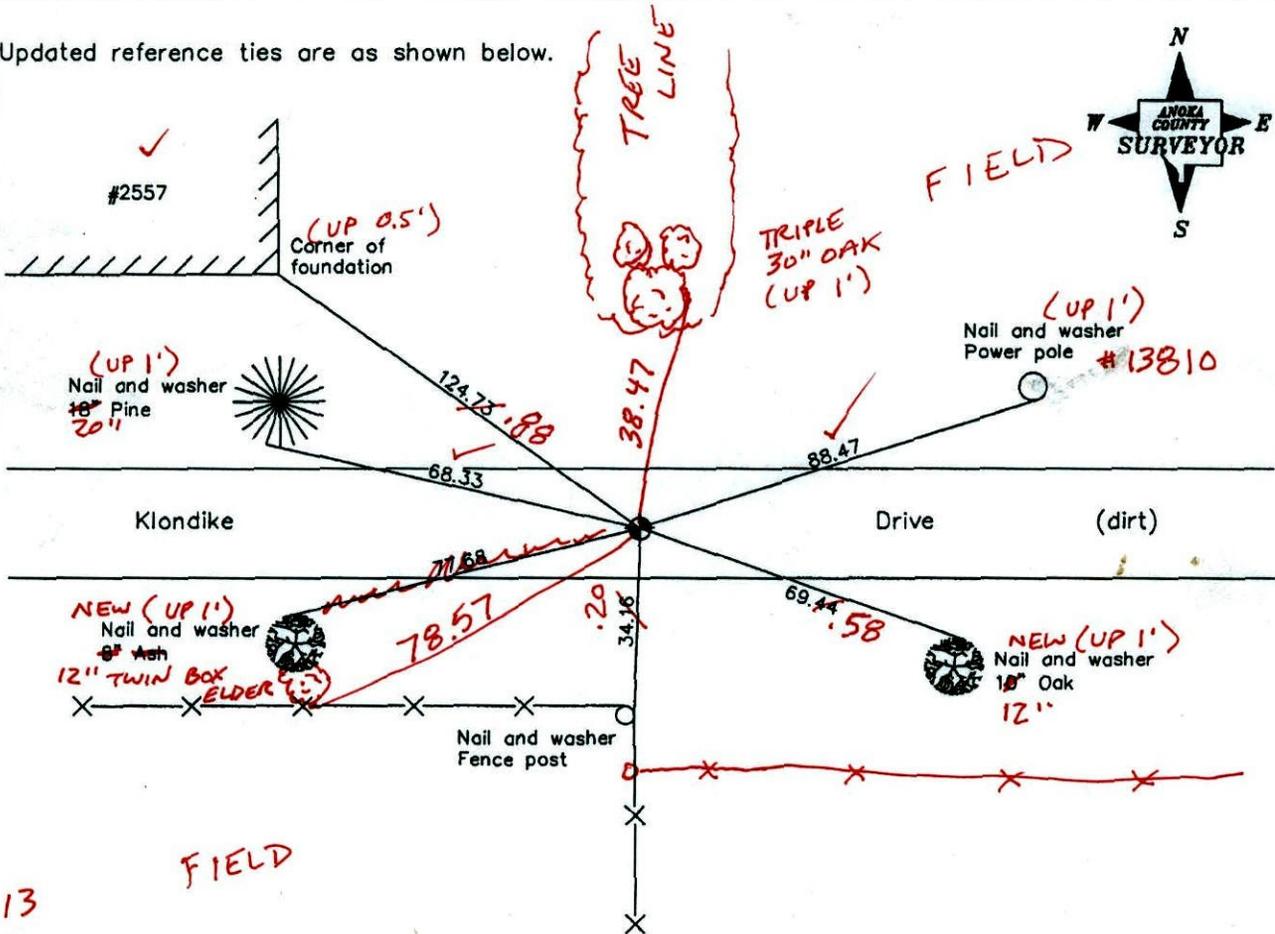

4-24-13  
BK-SS  
T/T

Revised date
8/04/92
7/30/97
6/26/00

N.A.D. 1983 Coordinates (1996 Adjustment)	
County Project Coordinates	
Northing	<u>208965.9365</u>
Easting	<u>515674.6568</u>
Date	<u>7/08/02</u>

I hereby certify that this United States public land survey monument record is correct and complete to the best of my knowledge and belief.

*Larry D. Hoium* Date 6/26/00

LARRY D. HOIUM, Anoka County Surveyor

Minnesota License Number 18165

# CERTIFICATE OF LOCATION OF GOVERNMENT CORNER

County of Anoka


State of Minnesota

WEST QTR. Corner of Sec. 22 Township 33 Range 23


I hereby certify that on the 2<sup>ND</sup> day of JUNE, 19 60, I found the described corner which was evidenced by OLD GUN BARREL

and I further certify that to perpetuate the location of said corner, I did, at the exact location thereof, place a permanent marker consisting of CAST IRON MONUMENT (DOWN 1.5'±)

which reference or witness monuments are located in the manner following:

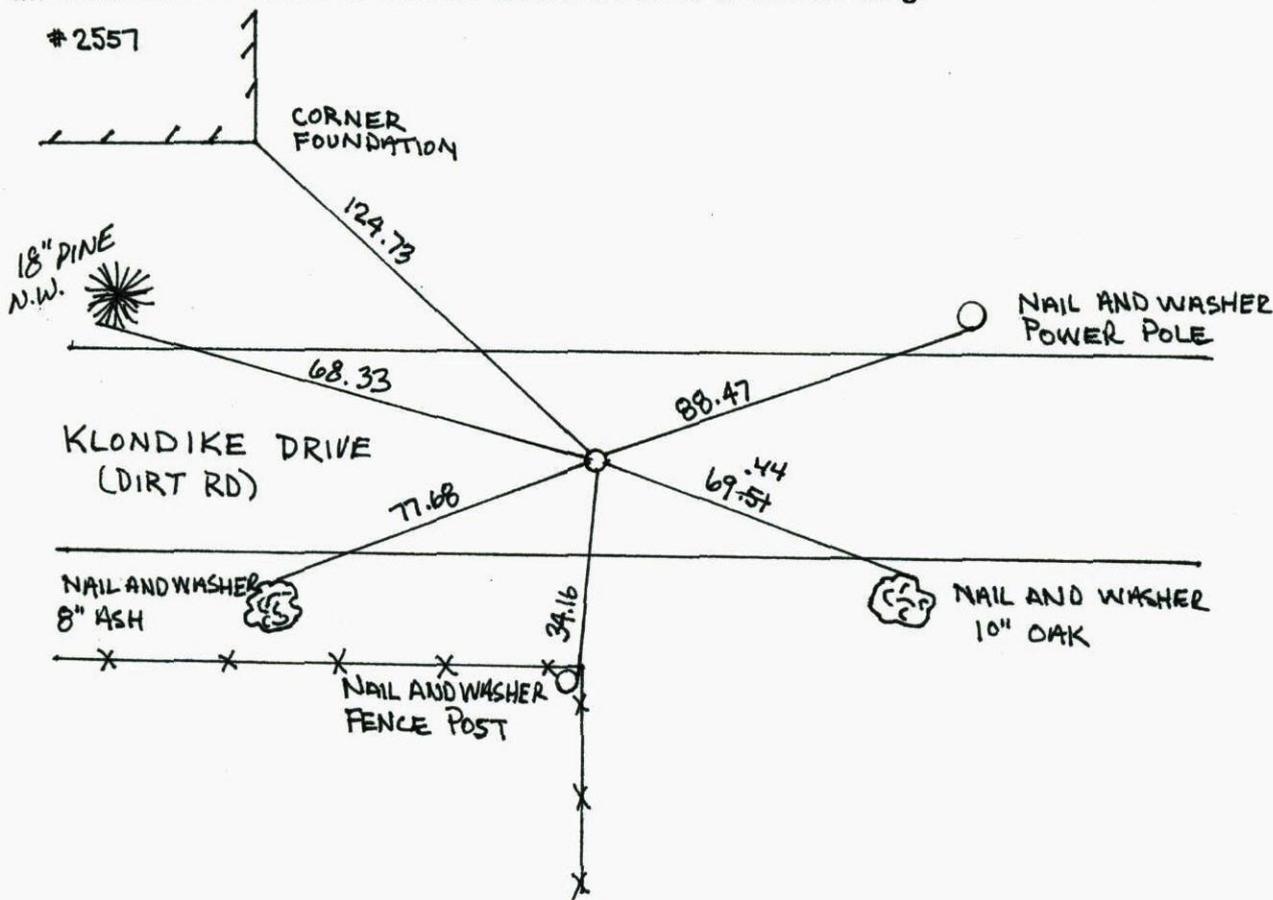


Revised date	Revised date	Revised date
7-3-70	7-30-97	
8-7-74	6-26-00	
7-12-77		
6-11-81		
6-18-84		
6-5-87		
8-4-92		

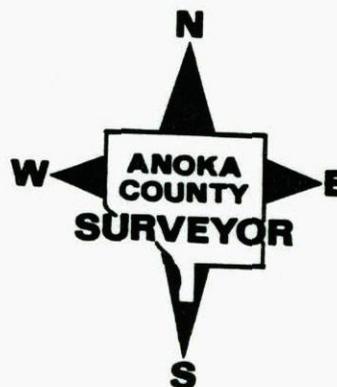

WEST 1/4 COR. SEC. 22 T.33 R.23

RETIED C.I.M. (MON. DOWN 1.5'±)

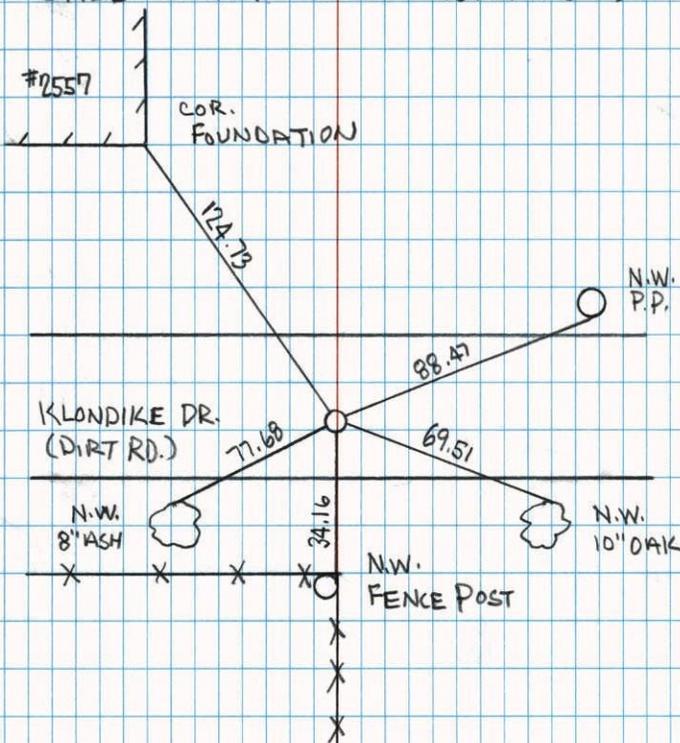


6-26-00  
B. KLEMZ  
T. SCHWAB

NO. 446  
NATIONAL PRINTFAST

W 1/4 Corner Section 22, T33, R23

Found Old Gun Barrell which  
Warren Lawson, owner of the  
NE 1/4 of SW 1/4, said had been  
there for 40 years and had  
been placed from old B.T.  
Placed Cast Iron Monument  
down 0.3'±. 5'± North of E.

\* FOUND BROKEN C.I. REPLACED WITH C.I.  
DOWN 0.54 8-7-74 R. FARMER  
N. DAHL  
D. DAHL

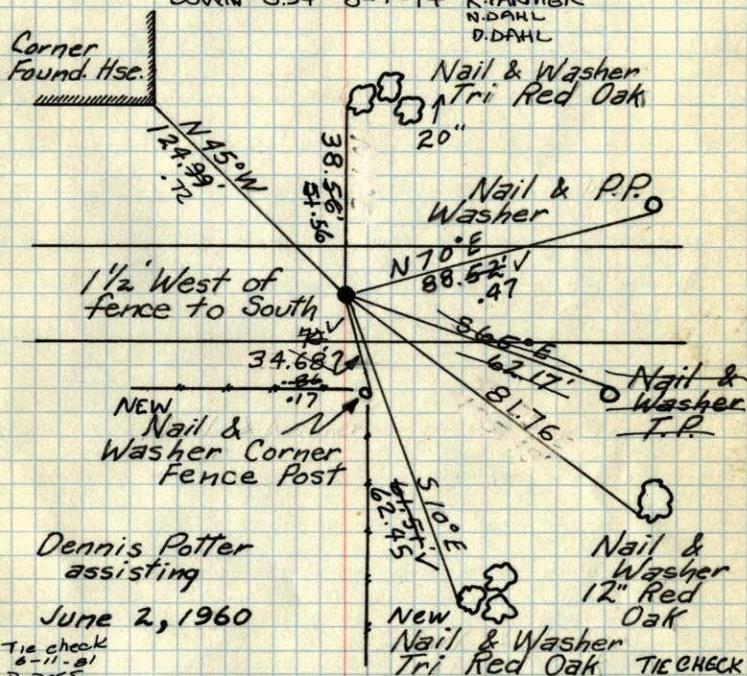

Dennis Potter  
assisting

June 2, 1960

Tie check  
6-11-01  
P. ROSS  
D. HORNBY  
G. NEFFINGER


ROLAND W. ANDERSON  
COUNTY SURVEYOR  
ANOKA COUNTY, MINNESOTA

TIE CHECK  
6-18-89  
D. ROSS  
G. LIPS  
D. POWELL  
R. BENNETT  
R. BRIEN

TIE CHECK  
JULY 12, 1977  
R. SANDERUD  
S. BRIEN  
J. STEPHENS

62  
 X W 1/4 Corner Section 22, T33, R23

Found Old Gun Barrell which Warren Lawson, owner of the NE 1/4 of SW 1/4, said had been there for 40 years and had been placed from old B.T. Placed Cast Iron Monument

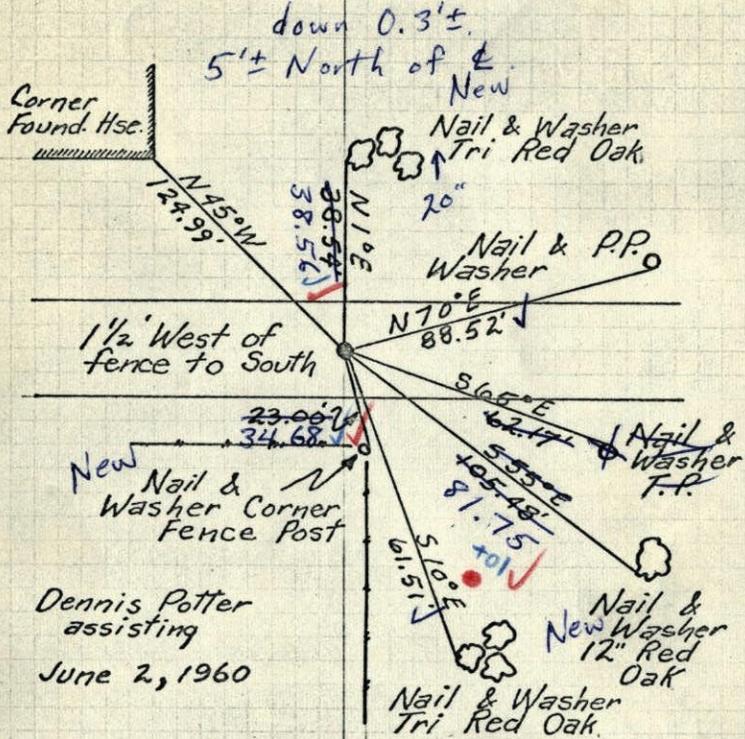

Dennis Potter assisting  
 June 2, 1960

ROLAND W. ANDERSON  
 COUNTY SURVEYOR  
 ANOKA COUNTY, MINNESOTA

7/3/70  
 #10-70°  
 D. Powell  
 R. Brien

W 1/4 Corn Sec. 22, T33, R23

Found Old Gun Barrell which Warren Lawson, owner of the NE 1/4 of the SW 1/4, said had been there for 40 yrs and had been placed from Old B.T. Placed Cast Iron Mon

