

CERTIFICATE OF LOCATION OF GOVERNMENT CORNER

County of Anoka

State of Minnesota


Witness Corner of Sec. 21 Township 33 Range 23
 (On east line of NE 1/4)

On the 1st day of November, 1985, the described corner was evidenced by area resurvey

and to perpetuate the location of said corner, at the exact location thereof, a permanent marker was placed consisting of a cast iron monument with sign and post on the north side

AND on the ___ day of _____, _____, said permanent marker was _____

Updated reference ties are as shown below.

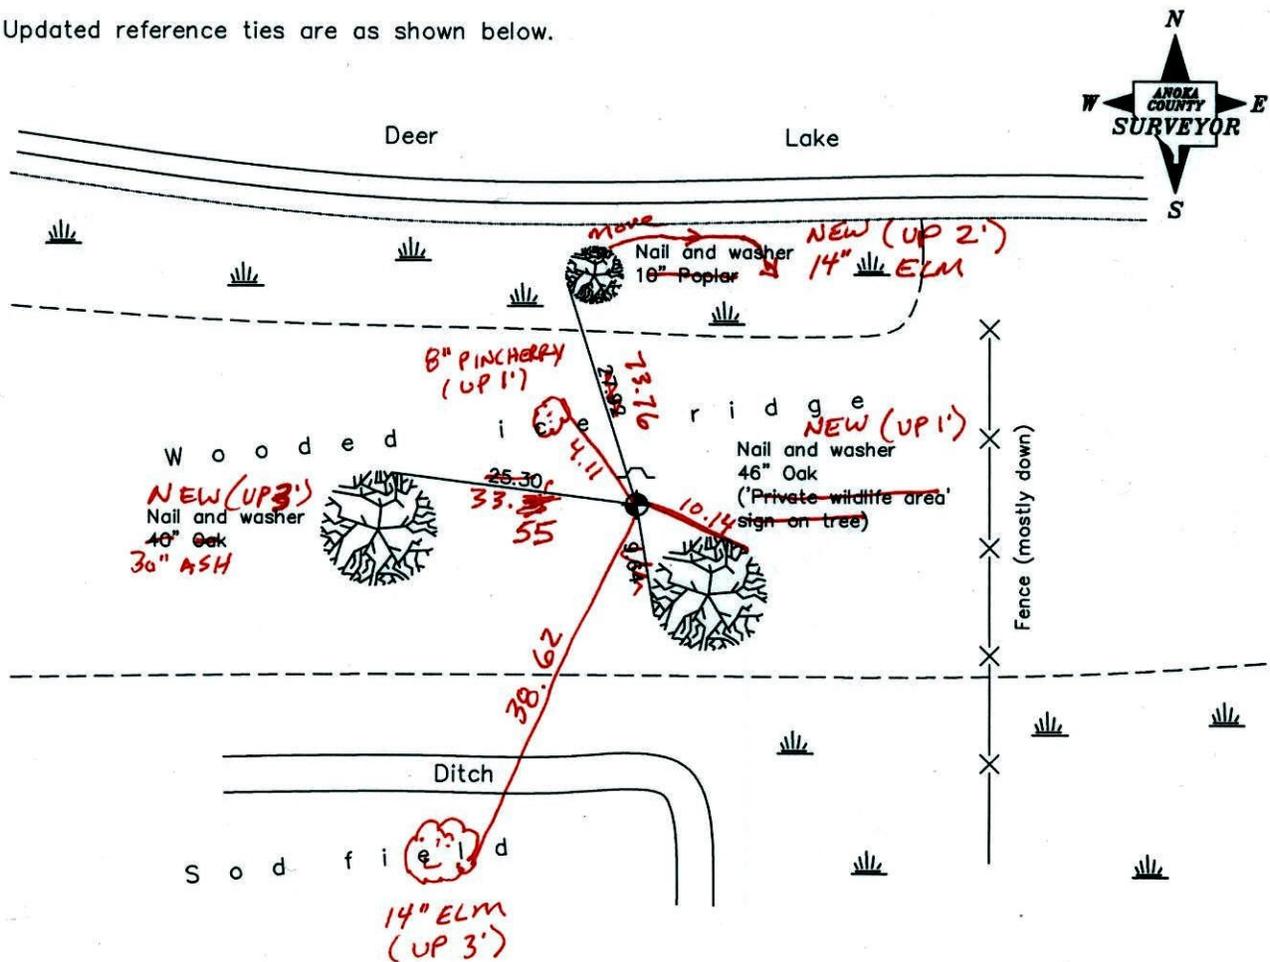

4-2-13
BK-55
TAPED

Revised date
8/21/92

N.A.D. 1983 Coordinates (1996 Adjustment)
County Project Coordinates
Northing <u>210490.3283</u>
Easting <u>515653.7700</u>
Date <u>3/18/03</u>

I hereby certify that this United States public land survey monument record is correct and complete to the best of my knowledge and belief.


_____ Date _____

_____, Anoka County Surveyor

Minnesota License Number _____

East NE 21
WC ON WEST LINE OF NW 1/4 SEC. 22 T33 R23

RETIRED CAST IRON MONUMENT
SIGN + POST ON NORTH SIDE

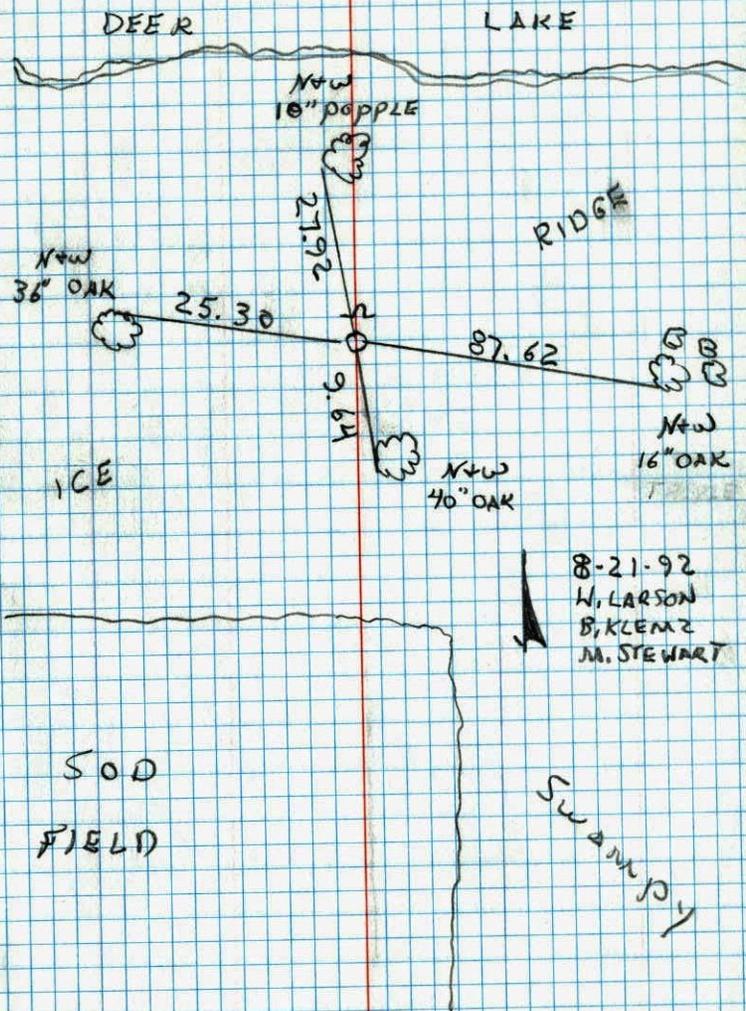


NO. 448

TELEPHONE

East NE 21
WC ON WEST LINE OF NW 1/4 SEC. 22 T33 R23

SET CAST IRON MON. FROM AREA
RESURVEY EAST IRON FLUSH WITH
SIGN AND POST ON NORTHWEST SIDE.

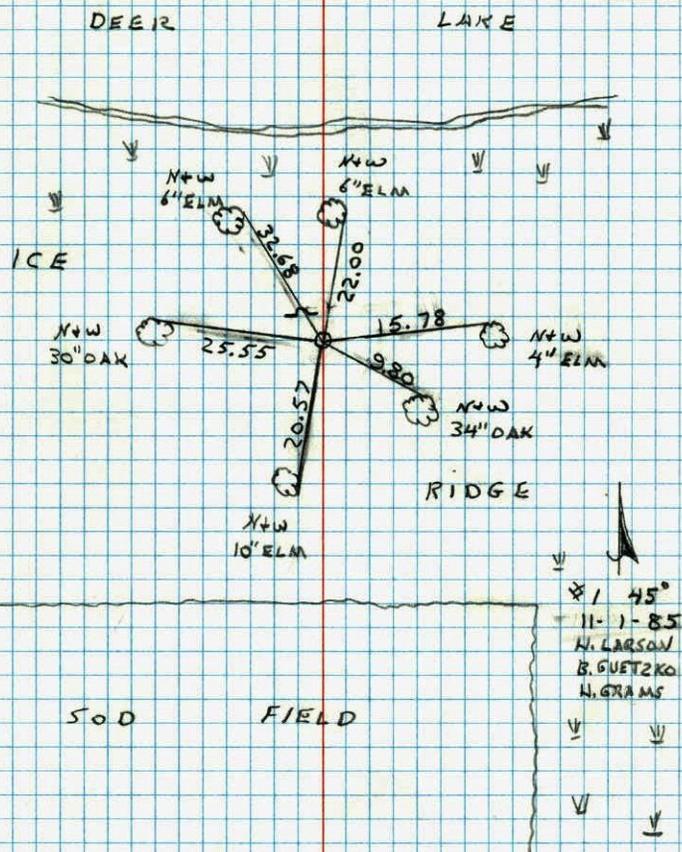

NO. 448

TELEPHONE