

CERTIFICATE OF LOCATION OF GOVERNMENT CORNER

County of Anoka

State of Minnesota

West 1/4 Corner of Sec. 24 Township 33 Range 23


On the 28th day of October, 1970, the described corner was evidenced by area resurvey

and to perpetuate the location of said corner, at the exact location thereof, a permanent marker was placed consisting of a cast iron monument with a sign and post on the north side

(MON DOWN 0.2'±)

AND on the ___ day of _____, _____, said permanent marker was _____

Updated reference ties are as shown below.

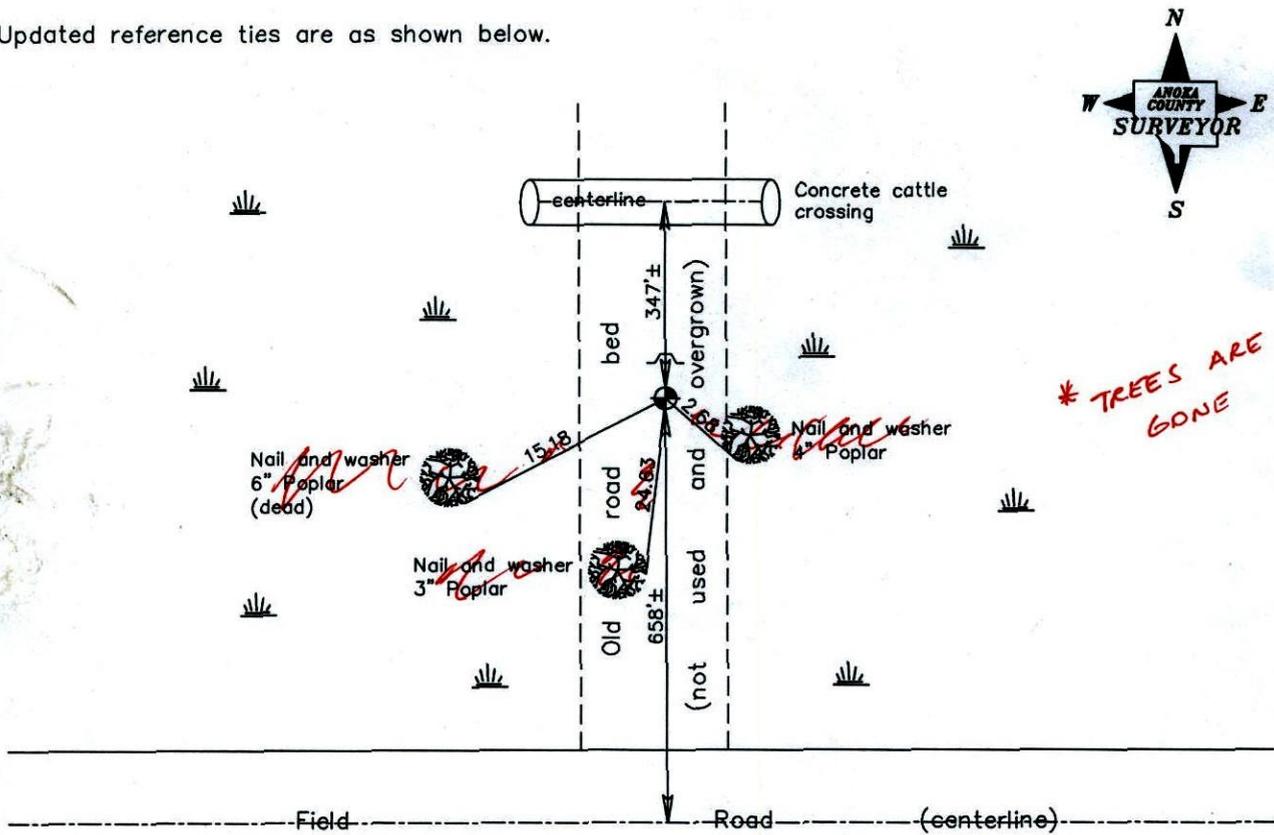

1-29-13
BK - 55
YRS

Revised date
6/18/84
6/03/87
8/11/92

N.A.D. 1983 Coordinates (1996 Adjustment)	
County Project Coordinates	
Northing	208863.3110
Easting	526401.6593
Date	3/12/03

I hereby certify that this United States public land survey monument record is correct and complete to the best of my knowledge and belief.

_____, Anoka County Surveyor

Minnesota License Number _____

YRS 3D Q = 0.06 N = 208863.2860 E = 526401.6579

CERTIFICATE OF LOCATION OF GOVERNMENT CORNER

County of Anoka


State of Minnesota

WEST 1/4 Corner of Sec. 24 Township 33 Range 23

I hereby certify that on the 28 day of OCTOBER, 1970, I found the described corner which was evidenced by AREA RESURVEY

and I further certify that to perpetuate the location of said corner, I did, at the exact location thereof, place a permanent marker consisting of CAST IRON MONUMENT SIGN + POST ON NORTH SIDE

which reference or witness monuments are located in the manner following:

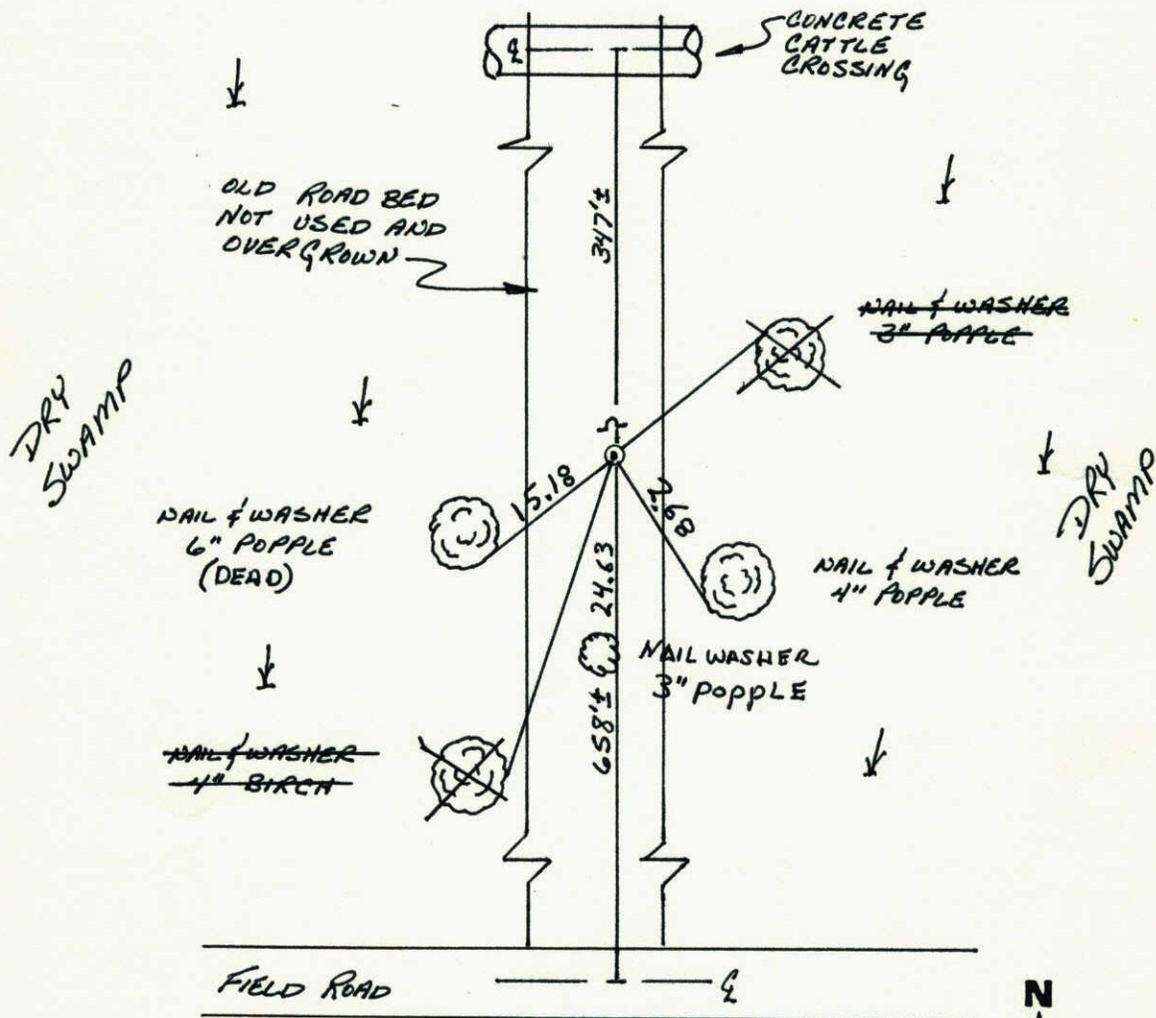

Revised date	Revised date	Revised date
7-30-74		
7-12-77		
6-12-81		
6-18-84		
6-3-87		
8-11-92		

