Page No. 7A

CERTIFICATE OF LOCATION OF GOVERNMENT CORNER

County of Anoka State of Minnesota

North 1/4 Corner of Sec. 4 Township 33 Range 23

On the 3rd day of July, 1962, the described corner was evidenced by a concrete monument

and to perpetuate the location of said corner, at the exact location thereof, a permanent marker was placed consisting of a cast iron monument ✓ ℄/℄

AND on the 26th day of March, 2002, said permanent marker was found and the ties were updated

Updated reference ties are as shown below.

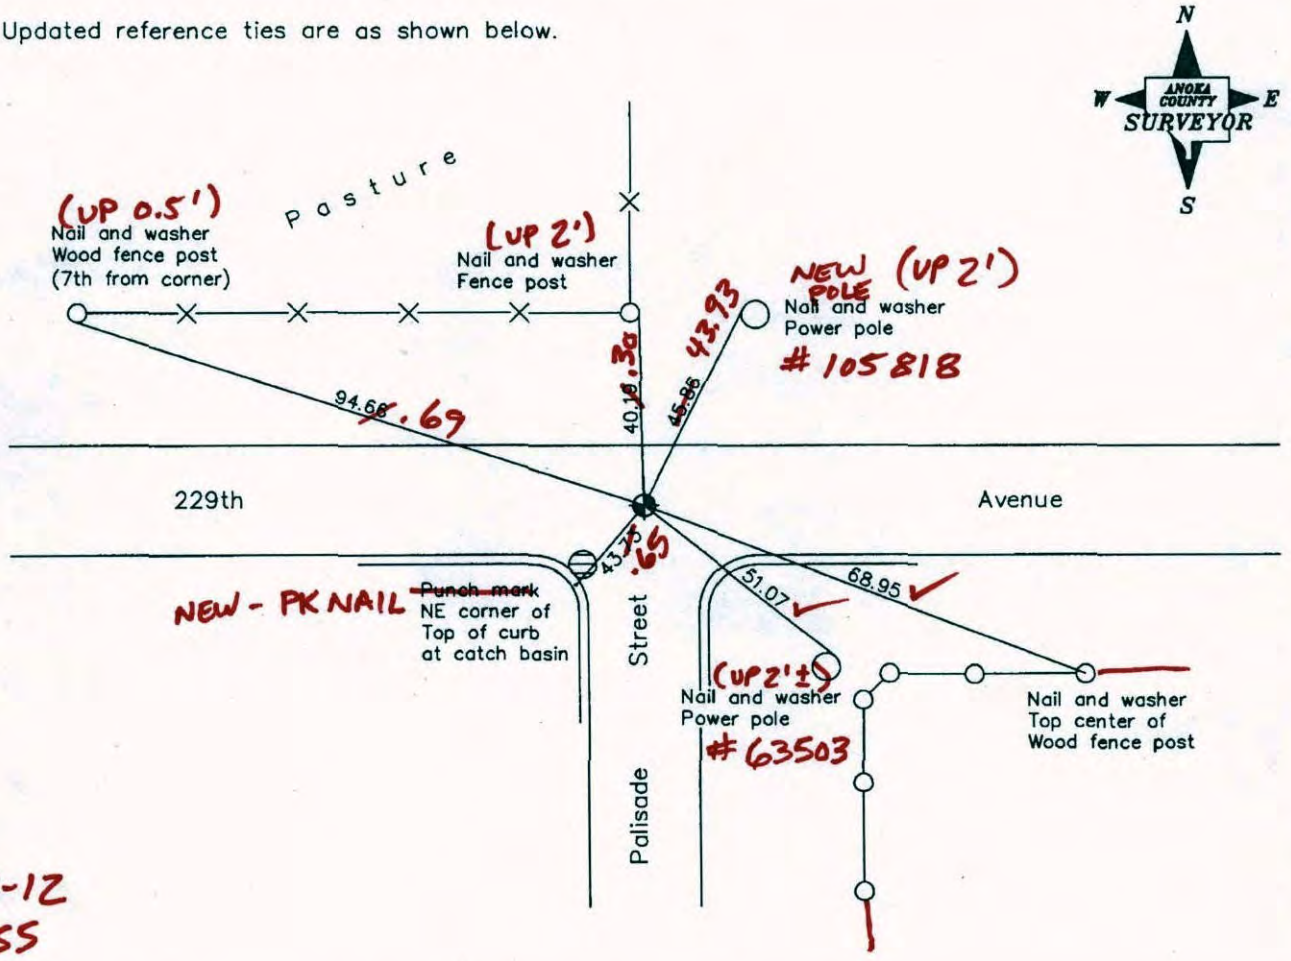

7-24-12
BK-SS
T/T - VRS

Revised date
8/04/97
5/25/00
3/26/02

N.A.D. 1983 Coordinates
(1996 Adjustment)

County Project Coordinates	
Northing	227523.2115
Easting	513564.3420
Date	3/26/02

I hereby certify that this United States public land survey monument record is correct and complete to the best of my knowledge and belief.

Larry D. Hoium Date 3/26/02

Larry D. Hoium, Anoka County Surveyor

Minnesota License Number 18165

VRS 30 = 0.05 N = 227523.1924 E = 513564.2915

CERTIFICATE OF LOCATION OF GOVERNMENT CORNER

County of Anoka State of Minnesota

NORTH 1/4 Corner of Sec. 4 Township 33 Range 23

I hereby certify that on the 3RD day of JULY, 19 62, I found the described corner which was evidenced by CONCRETE MONUMENT

and I further certify that to perpetuate the location of said corner, I did, at the exact location thereof, place a permanent marker consisting of CAST IRON MONUMENT

which reference or witness monuments are located in the manner following:

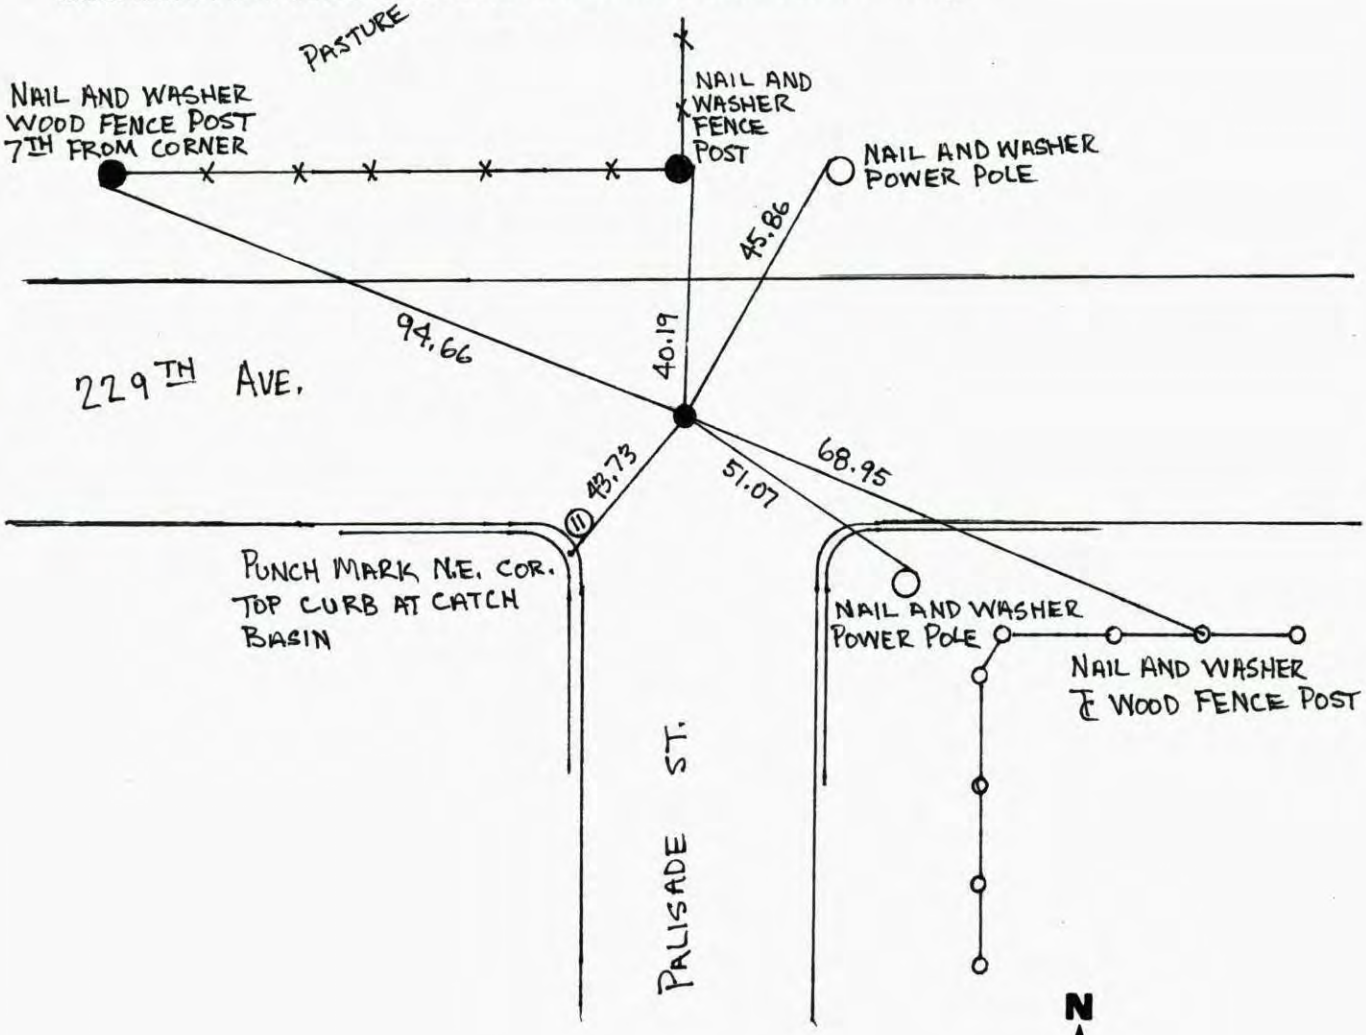

Revised date	Revised date	Revised date
12-28-92		
8-4-97		
5-25-00		
3.26.02		

N
W ANOKA COUNTY SURVEYOR E
S

NORTH 1/4 COR. SEC. 4, T. 33, R. 23

RETIED C.I.M.

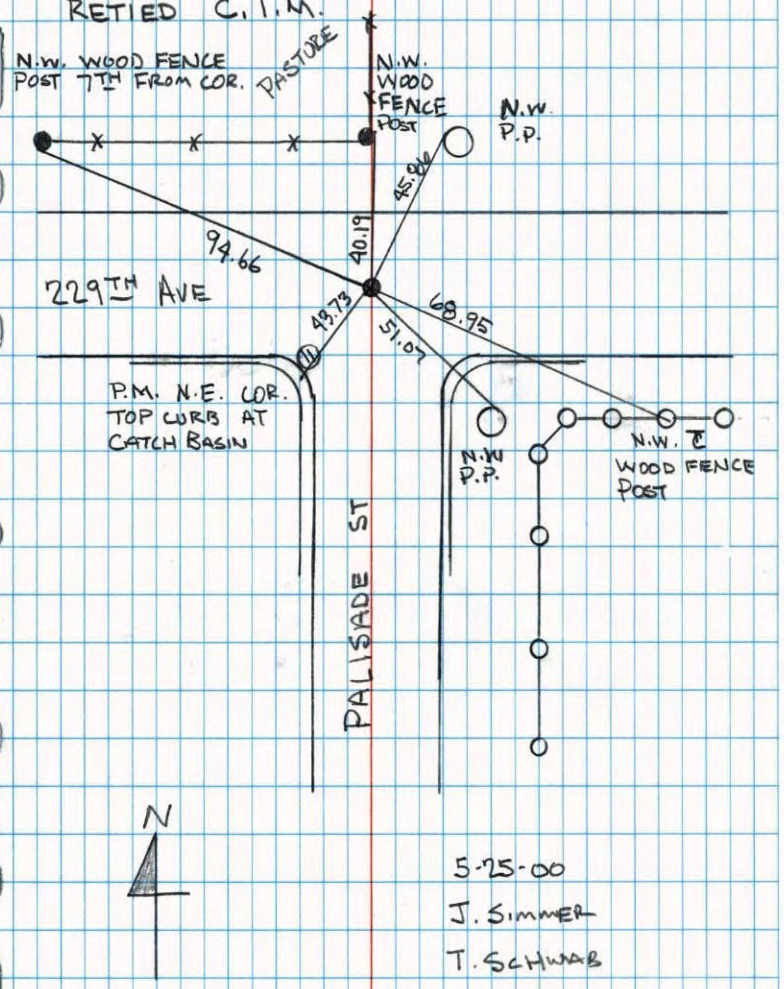

5-25-00

J. SIMMER

T. SCHWAB

B. KLEMZ

RETIE C.I. MON.

NORTH 1/4 S4 33, 23

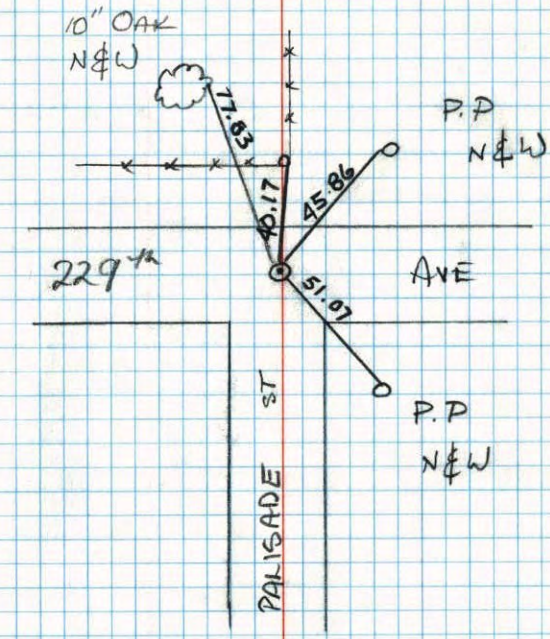

B. KLEMZ

M. STEWART

12-28-92

CONSTRUCTION TIES Linwood

N 1/4 COR. SEC. 4 T33 R23

RETIED AND REMOVED C.I. FOR ROAD CONSTRUCTION

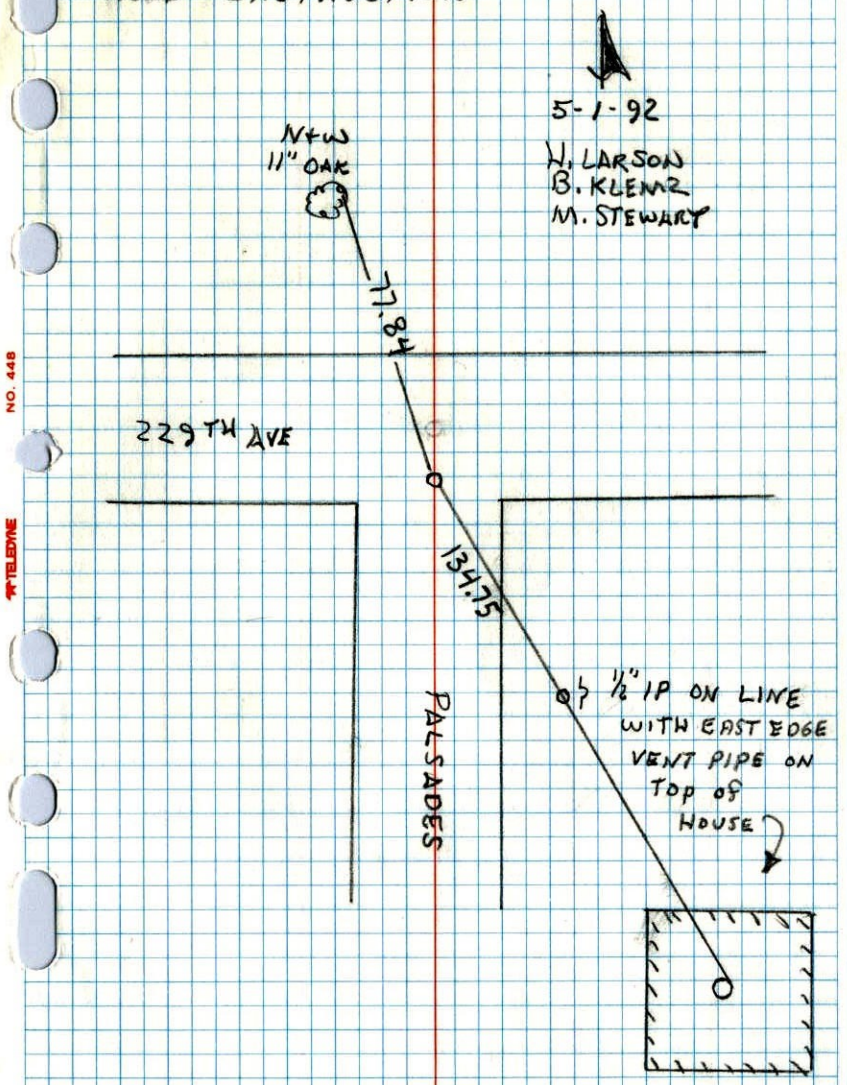

NO. 448 TELEDYNE

N ¼ COR. SEC. 4 T33 R23

REPLACED & RETIED CAST IRON

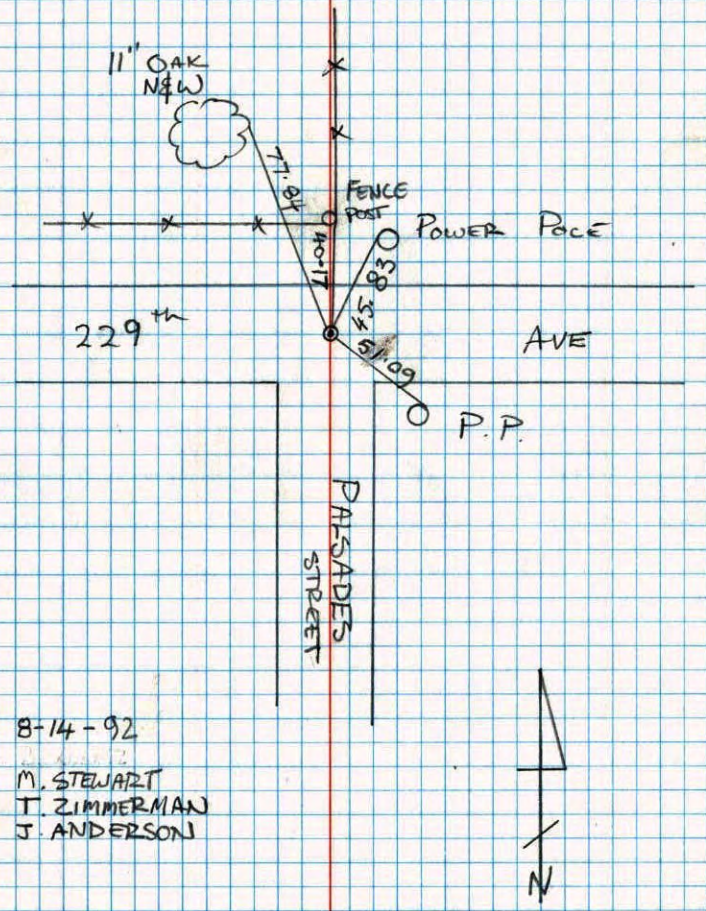

8-14-92

M. STEWART
T. ZIMMERMAN
J. ANDERSON

TELEDYNE NO. 448

N ¼ Cor. Sec. 4, T33, R23

Found 4" Sq. Flat Top Conc. Mon with Iron on No. Side down 0.2'

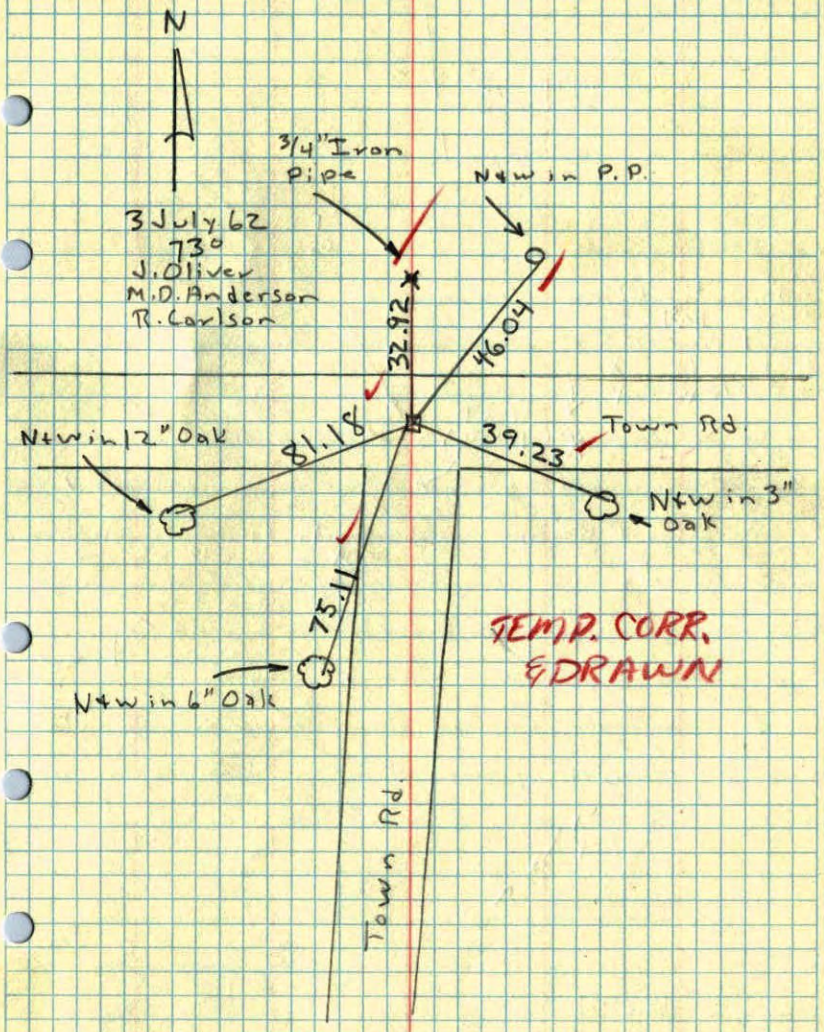

TEMP. CORR. & DRAWN

July 10, 1961 BA
From George Kuberra
of Arleigh Smith

N
S 1/4 Corner Sec 4, 33, T-34, R-23
East Bethel

Found 4" Concrete Monument
down 0.2. Center of intersection
East, West, and South roads.
Placed ½" iron on North side.
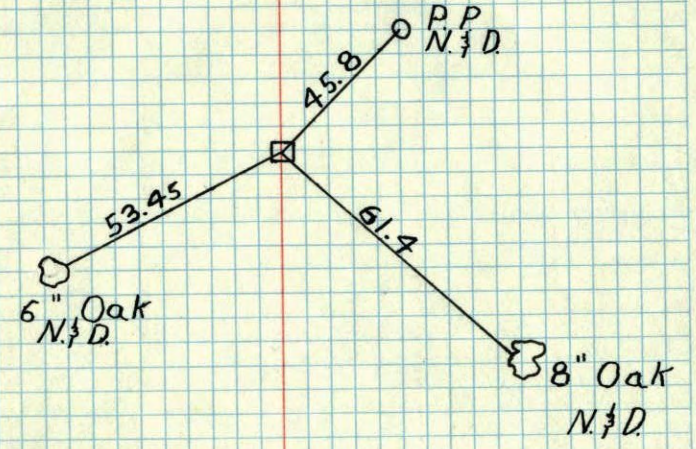
New Ties
New Tie Book