

CERTIFICATE OF LOCATION OF GOVERNMENT CORNER

County of Anoka State of Minnesota



Southwest Corner of Sec. 22 Township 33 Range 23

On the 15th day of March, 1967, the described corner was evidenced by a 2" iron pipe

and to perpetuate the location of said corner, at the exact location thereof, a permanent marker was placed consisting of a cast iron monument with a sign and post on the north side

AND on the 11th day of June, 2002, said permanent marker was found and the ties were updated

Updated reference ties are as shown below.

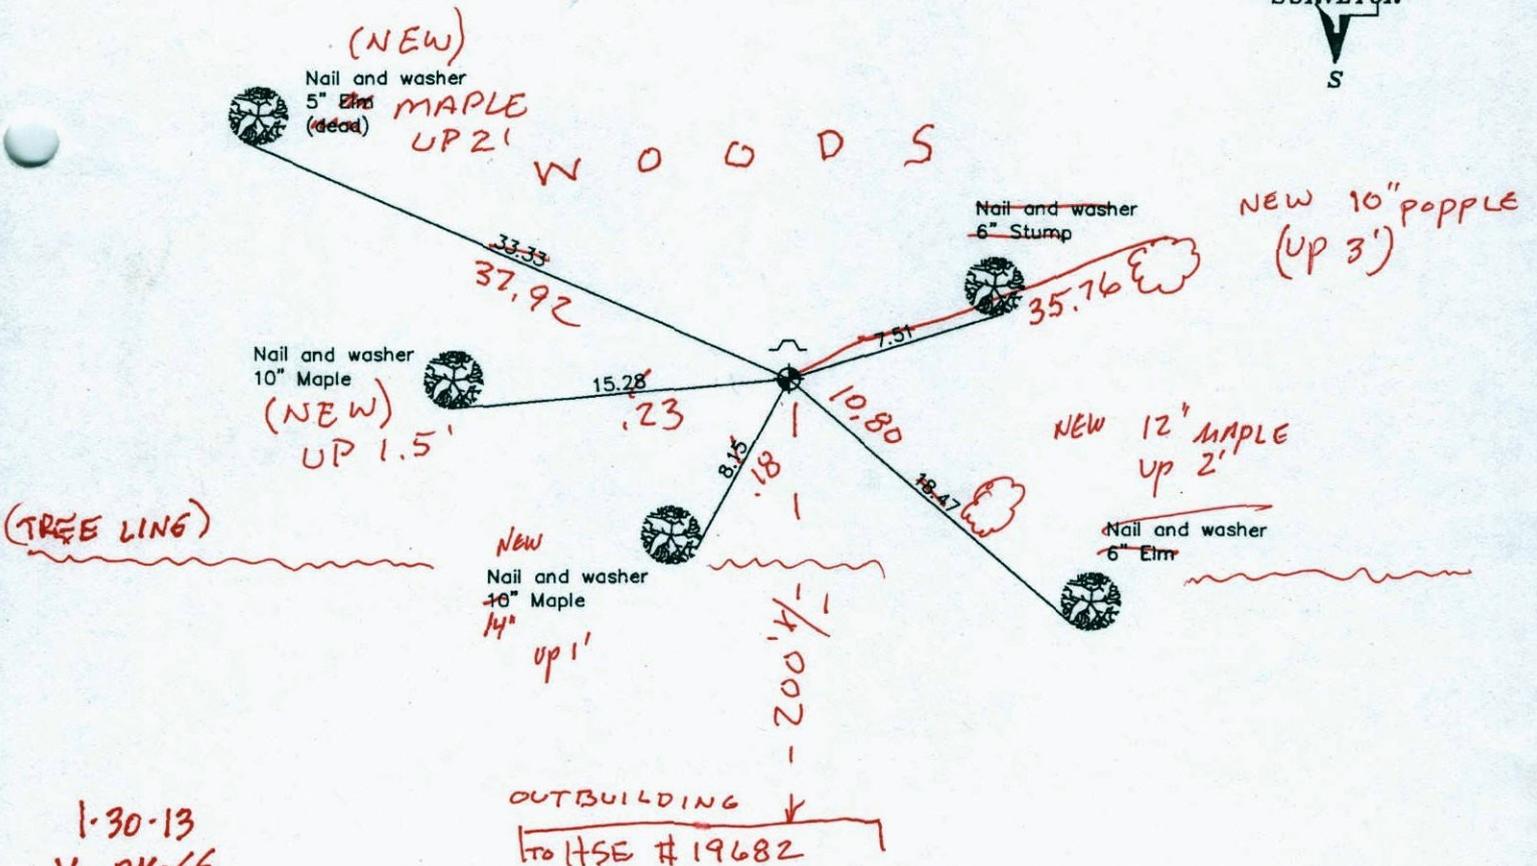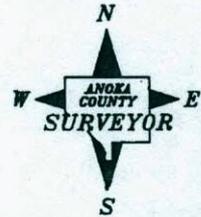

1-30-13
JG-BK-SS
TAPED

Revised date

| |
|---------|
| 8/15/97 |
| 6/26/00 |
| 6/11/02 |
| |
| |

N.A.D. 1983 Coordinates
(1996 Adjustment)

| |
|-----------------------------|
| County Project Coordinates |
| Northing <u>206306.3391</u> |
| Easting <u>515712.9328</u> |
| Date <u>6/11/02</u> |

I hereby certify that this United States public land survey monument record is correct and complete to the best of my knowledge and belief.

Larry D. Hoium Date 6/11/02
 Larry D. Hoium, Anoka County Surveyor
 Minnesota License Number 18165

CERTIFICATE OF LOCATION OF GOVERNMENT CORNER

County of Anoka


State of Minnesota

SOUTHWEST Corner of Sec. 22 Township 33 Range 23


I hereby certify that on the 15 day of MARCH, 1967, I found the described corner which was evidenced by 2" IRON PIPE

and I further certify that to perpetuate the location of said corner, I did, at the exact location thereof, place a permanent marker consisting of CAST IRON MONUMENT SIGN AND POST ON NORTH SIDE


which reference or witness monuments are located in the manner following:

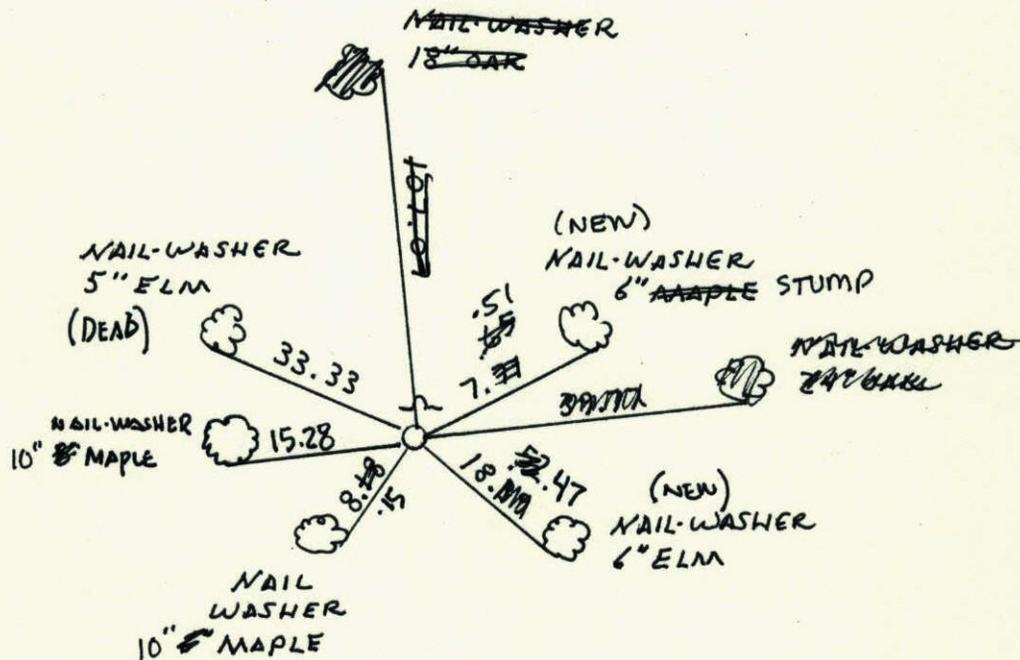

| Revised date | Revised date | Revised date |
|--------------|--------------|--------------|
| 8-21-68 | 8-15-97 | |
| 8-9-74 | 6-26-00 | |
| 7-13-77 | 6-11-02 | |
| 6-18-81 | | |
| 6-21-84 | | |
| 6-9-87 | | |
| 8-19-92 | | |

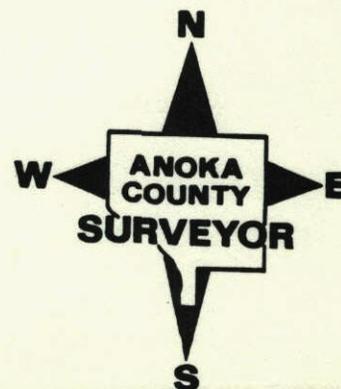

SW Cor. Sec. 22-T33-R23

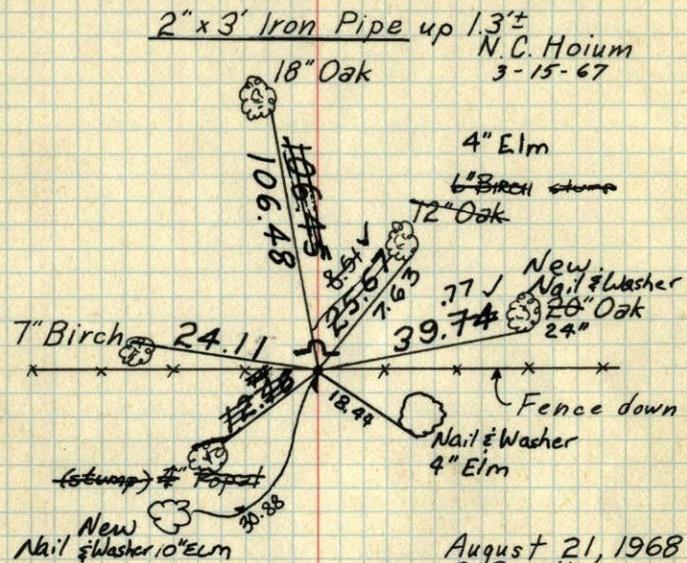

August 21, 1968
D. Powell
R. Olson
P. Pieh

SET CAST IRON FROM TIES
WITH WARNING SIGN 1'± N
OF MON 8-9-1974

R. FARMER
D. DAHL TIE CHECK
G. ADAMS 6-21-81
D. ROSS
R. BENNETT
G. LIPS

TIE CHECK
JULY 13, 1977
R. SANWERUD
S. BIRNEN
J. STEPHENS


TIE CHECK
6-18-81
P. ROSS
D. HORNSY

TEMPERATURE CORRECTED
AND HORIZONTALLY
TAPED MEASUREMENTS

ROLAND W. ANDERSON
COUNTY SURVEYOR
ANOKA COUNTY, MINNESOTA

SW Cor. Sec. 22-T33-R23

2" x 3" Iron Pipe up ~~1.3'±~~ 1.3'±
N.C. Hoium

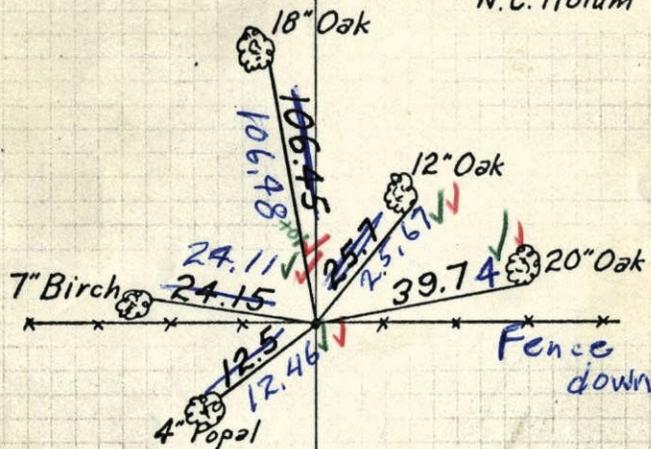

8/21/68
#6 - 75°
D. Powell
R. Olson
P. Pieh