

CERTIFICATE OF LOCATION OF GOVERNMENT CORNER

County of Anoka

State of Minnesota

North 1/4 Corner of Sec. 28 Township 33 Range 23


On the 22nd day of May, 1969, the described corner was evidenced by a 1 1/2" iron pipe

and to perpetuate the location of said corner, at the exact location thereof, a permanent marker was placed consisting of a cast iron monument with a sign and post on the north side

* COULD USE NEW SIGN

AND on the 24th day of March, 2003, said permanent marker was found and the ties were updated

Updated reference ties are as shown below.

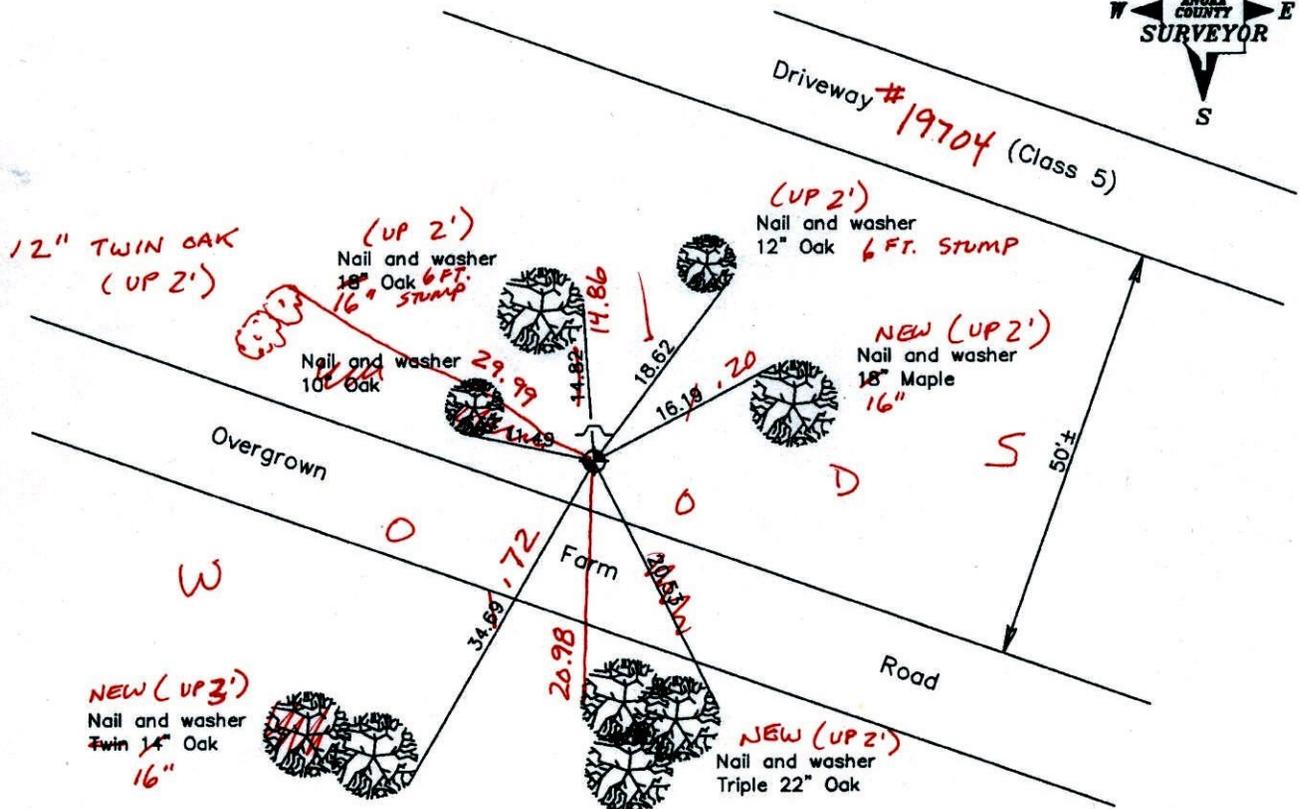

1-14-13
 BK-55
 T/T

(ONE BROKE) OFF

Revised date
6/02/87
8/19/92
3/24/03

N.A.D. 1983 Coordinates (1996 Adjustment)	
County Project Coordinates	
Northing	<u>206315.8560</u>
Easting	<u>513030.2483</u>
Date	<u>3/24/03</u>

I hereby certify that this United States public land survey monument record is correct and complete to the best of my knowledge and belief.

_____ Date 3/24/03
 Larry D. Hoium, Anoka County Surveyor
 Minnesota License Number 18165

CERTIFICATE OF LOCATION OF GOVERNMENT CORNER

County of Anoka


State of Minnesota

NORTH 1/4 Corner of Sec. 28 Township 33 Range 23

I hereby certify that on the 22 day of MAY, 1969, I found the described corner which was evidenced by 1 1/2" IRON PIPE

and I further certify that to perpetuate the location of said corner, I did, at the exact location thereof, place a permanent marker consisting of CAST IRON MONUMENT WITH SIGN AND POST ON THE NORTH SIDE

which reference or witness monuments are located in the manner following:

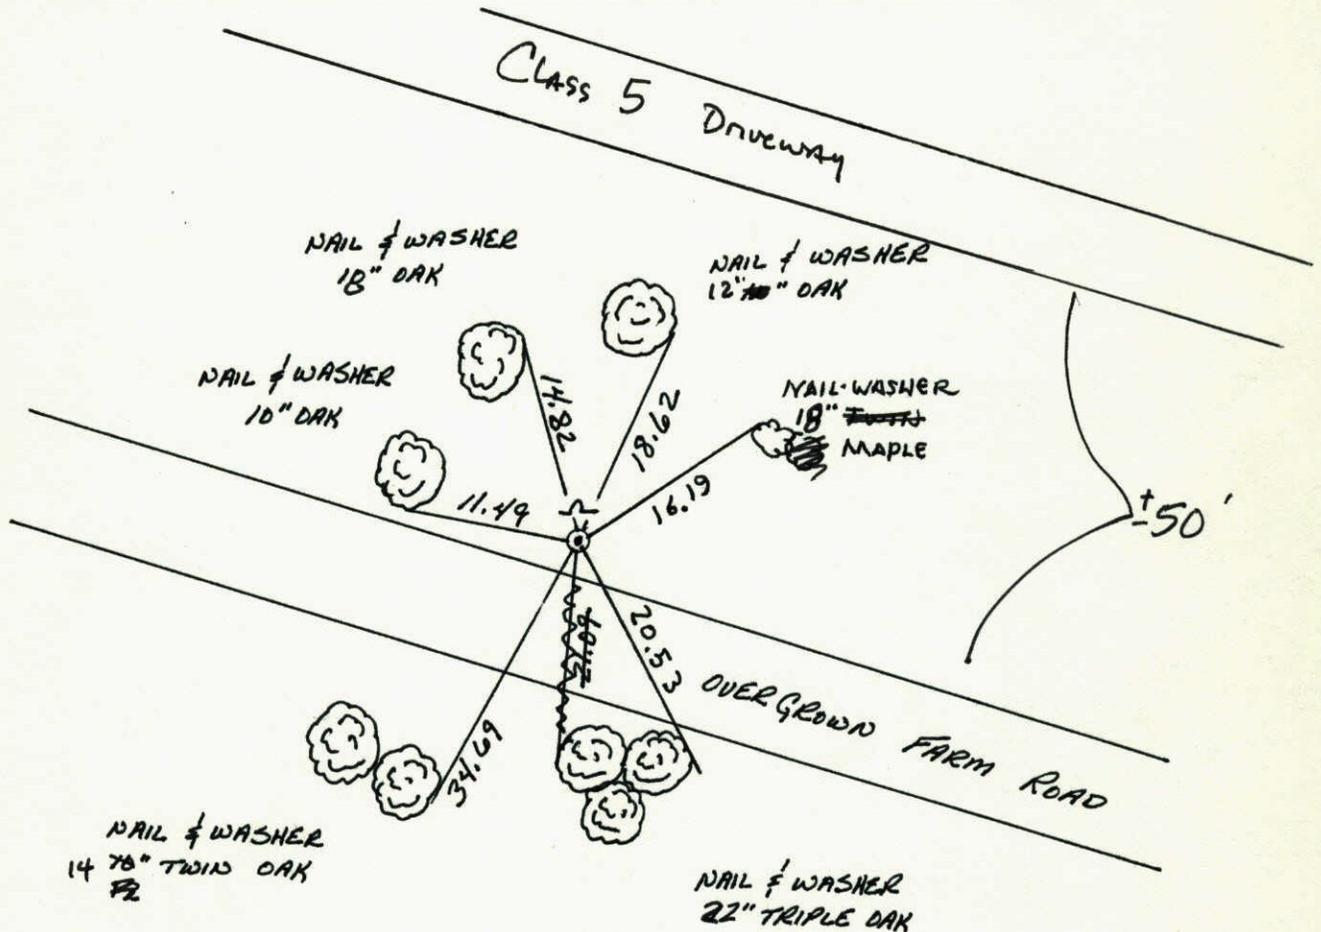

Revised date	Revised date	Revised date
8-8-74		
7-19-77		
6-18-81		
6-2-87		
8-19-92		
3-24-03		

