

CERTIFICATE OF LOCATION OF GOVERNMENT CORNER

County of Anoka State of Minnesota

West 1/4 Corner of Sec. 27 Township 33 Range 23



On the 20th day of May, 1969, the described corner was evidenced by area resurvey

and to perpetuate the location of said corner, at the exact location thereof, a permanent marker was placed consisting of a cast iron monument

SET 6" PARTIAL CIM ON TOP OF C.I.M. IN CONCRETE
CIRCLED TIES ARE FINAL TAPED DIST'S

AND on the 23rd day of June, 2000, said permanent marker was found and the ties were updated

Updated reference ties are as shown below.

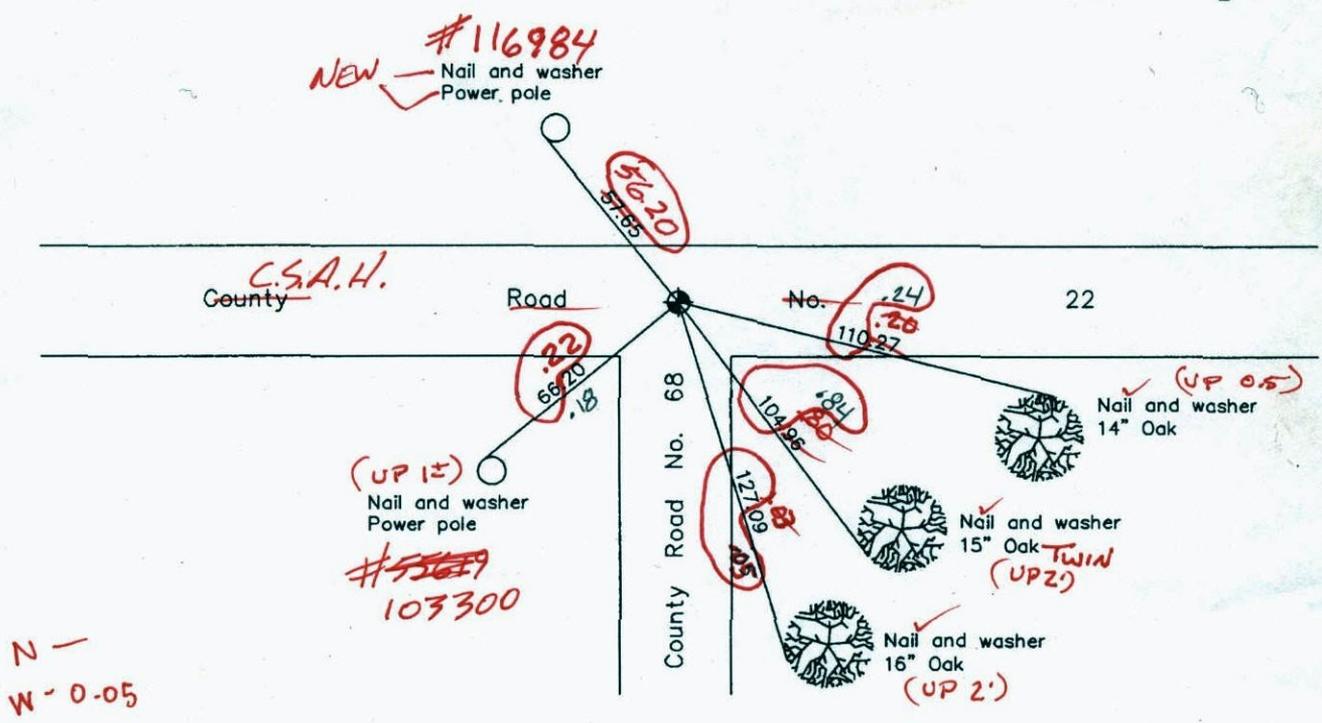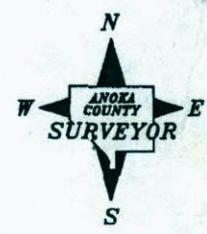

Revised date
7/29/92
7/29/97
6/23/00

N.A.D. 1983 Coordinates (1996 Adjustment)	
County Project Coordinates	
Northing	<u>203661.6208</u>
Easting	<u>515831.4967</u>
Date	<u>5/08/02</u>

I hereby certify that this United States public land survey monument record is correct and complete to the best of my knowledge and belief.

Larry D. Hoium Date 6/23/00

Larry D. Hoium, Anoka County Surveyor

Minnesota License Number 18165

CERTIFICATE OF LOCATION OF GOVERNMENT CORNER

County of Anoka State of Minnesota


West 1/4 Corner of Sec. 27 Township 33 Range 23

On the 20th day of May, 1969, the described corner was evidenced by area resurvey

and to perpetuate the location of said corner, at the exact location thereof, a permanent marker was placed consisting of a cast iron monument (N. OF E 4'± & 3'± W. OF E)

AND on the 23rd day of June, 2000, said permanent marker was found and the ties were updated

Updated reference ties are as shown below.

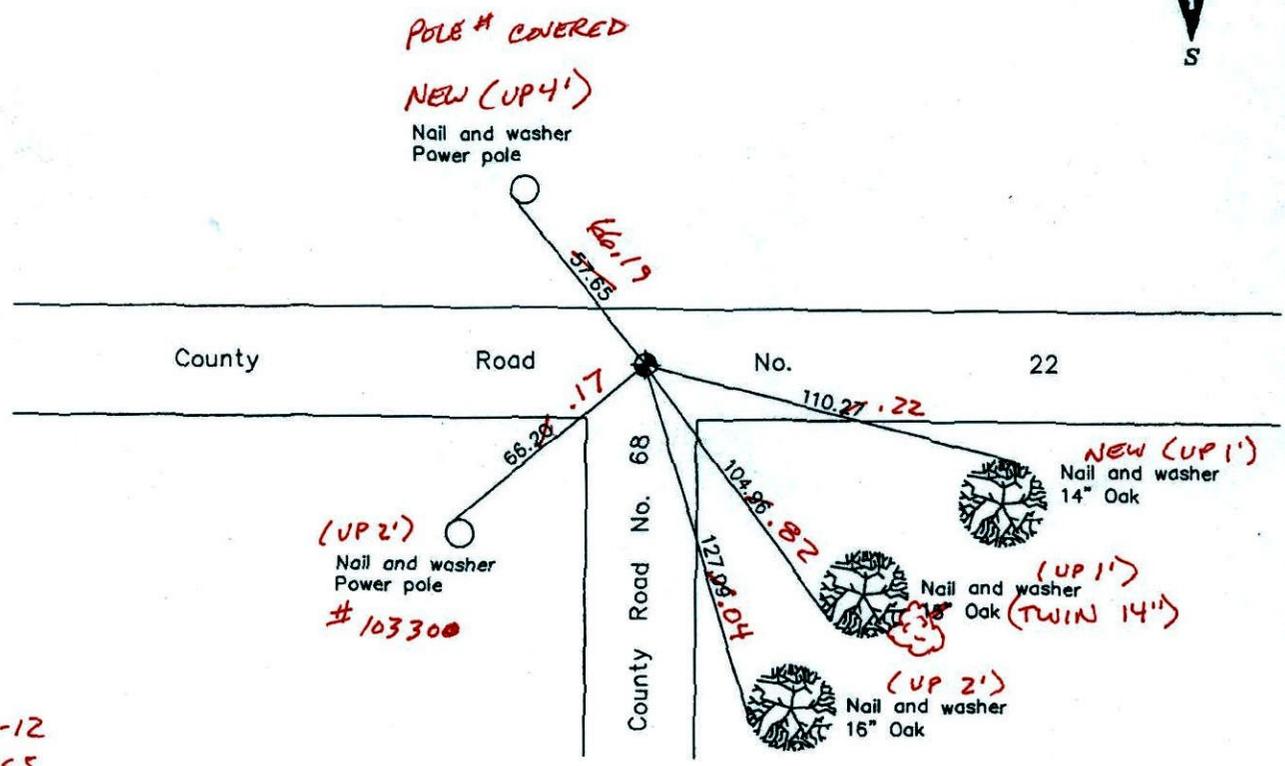

12-5-12
BK-SS
T/T-URS

Revised date
7/29/92
7/29/97
6/23/00

N.A.D. 1983 Coordinates (1996 Adjustment)	
County Project Coordinates	
Northing	203661.6208
Easting	515831.4967
Date	5/08/02

I hereby certify that this United States public land survey monument record is correct and complete to the best of my knowledge and belief.

Larry D. Hoium Date 6/23/00

Larry D. Hoium, Anoka County Surveyor

Minnesota License Number 18165

URS 3D = 0.04 N = 203661.5833 E = 515831.4508

CERTIFICATE OF LOCATION OF GOVERNMENT CORNER

County of Anoka


State of Minnesota

WEST QTR. Corner of Sec. 27 Township 33 Range 23


I hereby certify that on the 20 day of MAY, 1969, I found the described corner which was evidenced by AREA RESURVEY

and I further certify that to perpetuate the location of said corner, I did, at the exact location thereof, place a permanent marker consisting of CAST IRON MON.

which reference or witness monuments are located in the manner following:

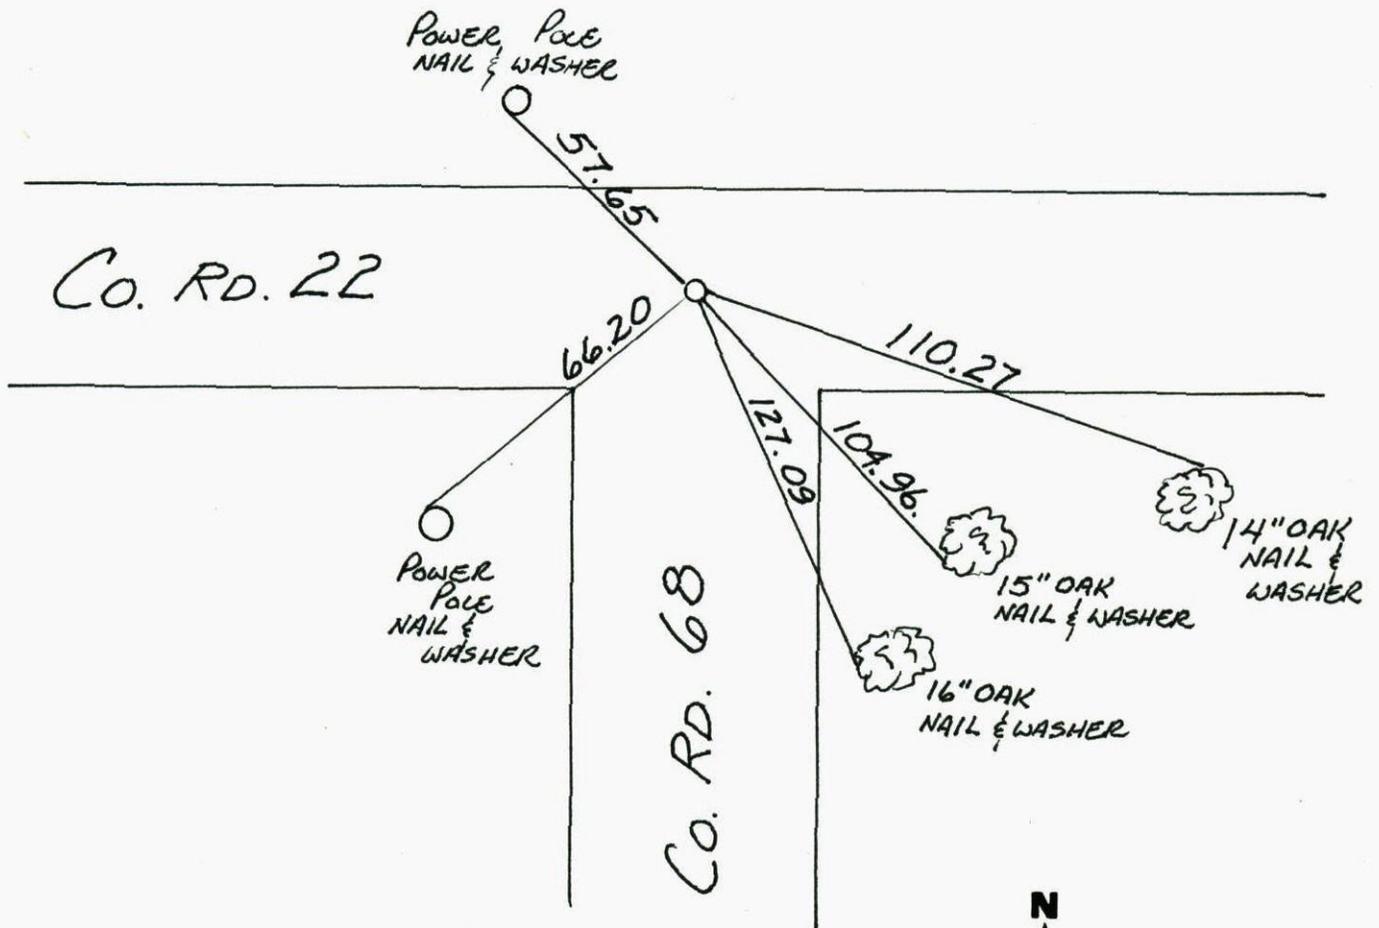


Revised date	Revised date	Revised date
8-21-86		
7-29-92		
7-29-97		
6-23-00		

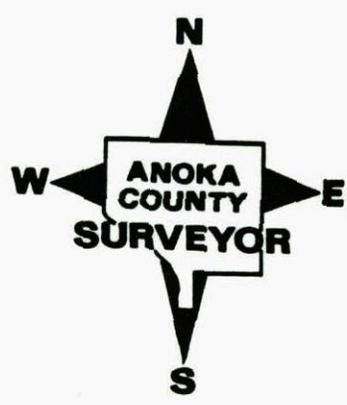

WEST QTR. SEC. 27 T-33 R-23

RETIED CAST IRON MON.

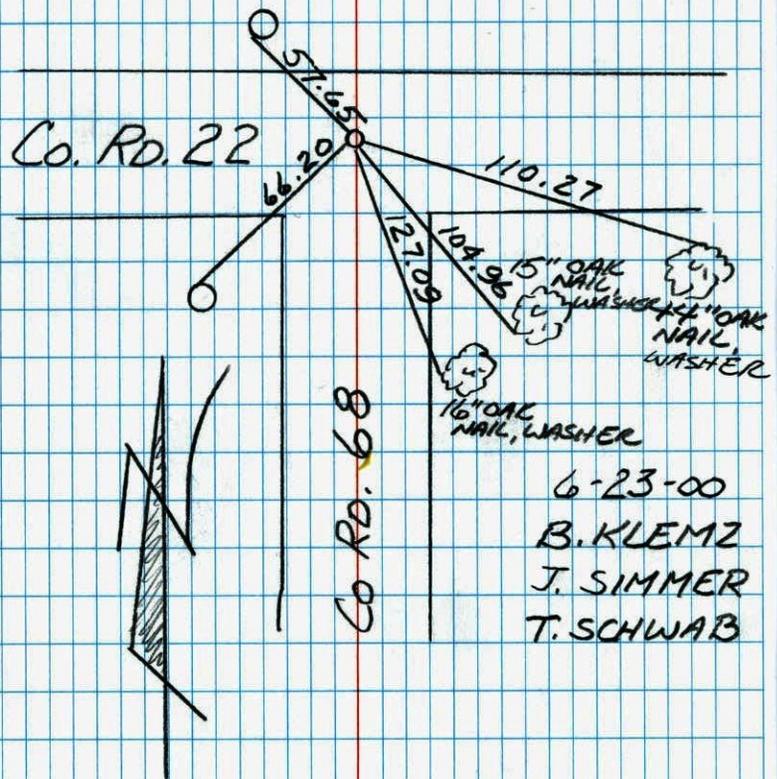


NO. 448

NATIONAL PRINTER

WEST 1/4 SEC 27 T 33 R 23

RETIED CAST IRON MONUMENT

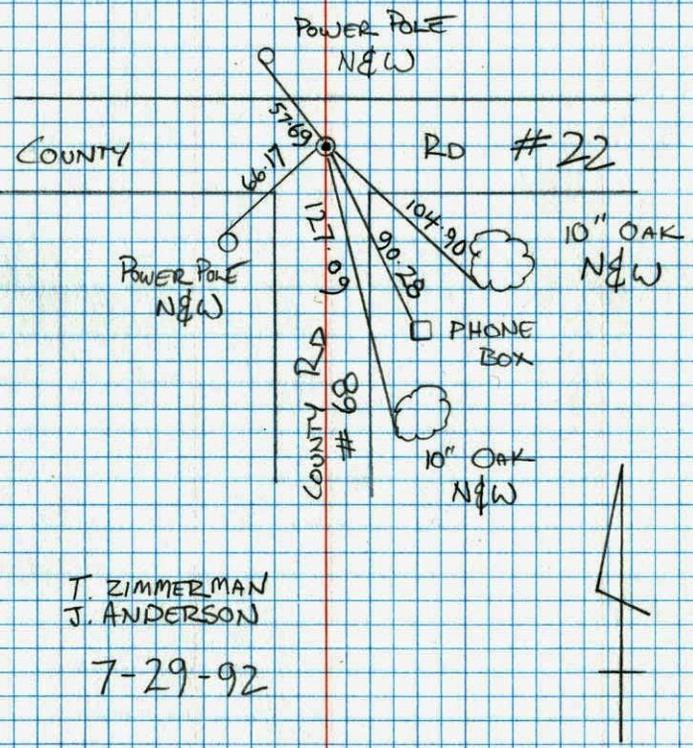

NO. 448

TELETYPE

W 1/4 Cor. Sec. 27 T33 R23

Set cast iron monument from
area resurvey. C.I. Flush.

RAISED 7-19-77 P.K's. NORTH & EAST May 20, 1969

TIE CHECK


JULY 19, 1977

R. SANIERUD

S. BRIEN

J. STEPHENS

M.D. Anderson
R.A. Olson

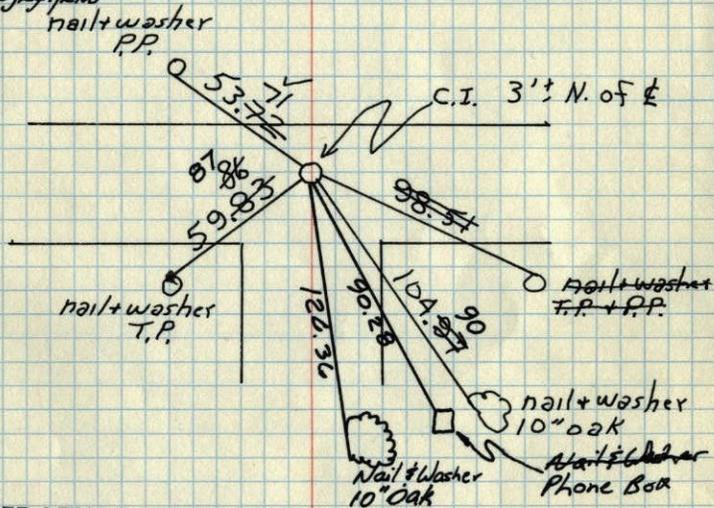

TEMPERATURE CORRECTED
AND HORIZONTALLY
TAPED MEASUREMENTS

ROLAND W. ANDERSON
COUNTY SURVEYOR
ANOKA COUNTY, MINNESOTA

TIE CHECK

6-11-81

P. ROSS

P. KREIBER

G. NEFFINGER

TIE CHECK

June 18, 1984

R. Bennett

D. Ross

G. Lips

TIE CHECK

8-12-74

D. DAHL

G. ADAMS

W 1/4 Cor. Sec. 27-T33-R23

set Cast Iron Monument flush in Blacktop
set from area resurvey

May 20, 1969

M.D. Anderson
R.A. Olson

temp. 50°
tape 60

