

CERTIFICATE OF LOCATION OF GOVERNMENT CORNER

County of Anoka

State of Minnesota


Meander Corner of Sec. 25 Township 33 Range 23
(Meander Cor. No. 12)

On the 19th day of October, 1962, the described corner was evidenced by a 1 1/2" iron pipe

and to perpetuate the location of said corner, at the exact location thereof, a permanent marker was placed consisting of a cast iron monument (down 2'±)

AND on the 11th day of June, 2002, said permanent marker was found and the ties were updated

Updated reference ties are as shown below.

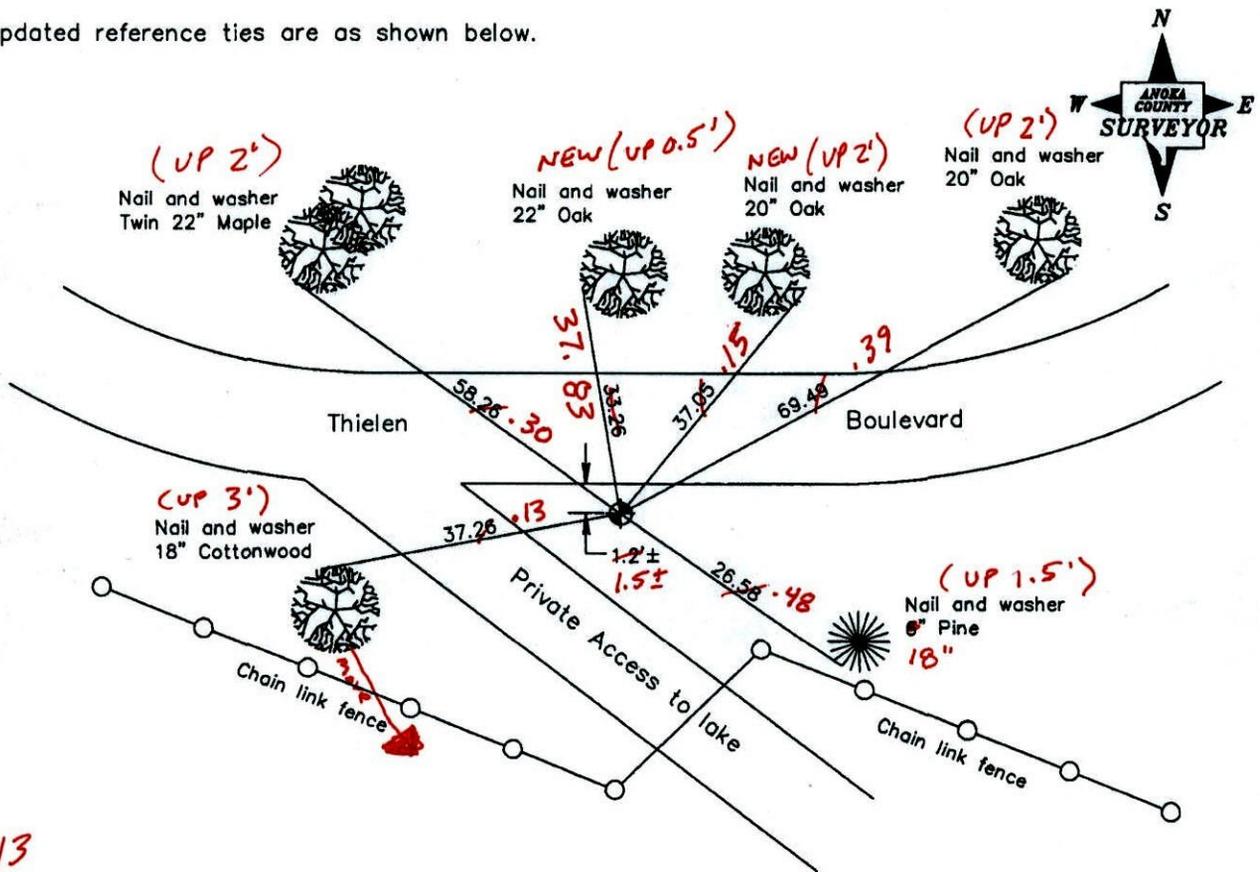

4-24-13
BK-55
T/T

Revised date
8/18/92
7/31/97
6/11/02

N.A.D. 1983 Coordinates (1996 Adjustment)	
County Project Coordinates	
Northing	200917.3138
Easting	527515.4335
Date	6/11/02

I hereby certify that this United States public land survey monument record is correct and complete to the best of my knowledge and belief.

Larry D. Holum Date 6/11/02
 _____, Anoka County Surveyor
 Minnesota License Number 18165

CERTIFICATE OF LOCATION OF GOVERNMENT CORNER

County of Anoka


State of Minnesota

MEANDER #12 Corner of Sec. 25 Township 33 Range 23
~~28~~


I hereby certify that on the 19 day of OCTOBER, 1962, I found the described corner which was evidenced by 1 1/2" IRON PIPE

and I further certify that to perpetuate the location of said corner, I did, at the exact location thereof, place a permanent marker consisting of CAST IRON MONUMENT
MONUMENT DOWN 2'

which reference or witness monuments are located in the manner following:

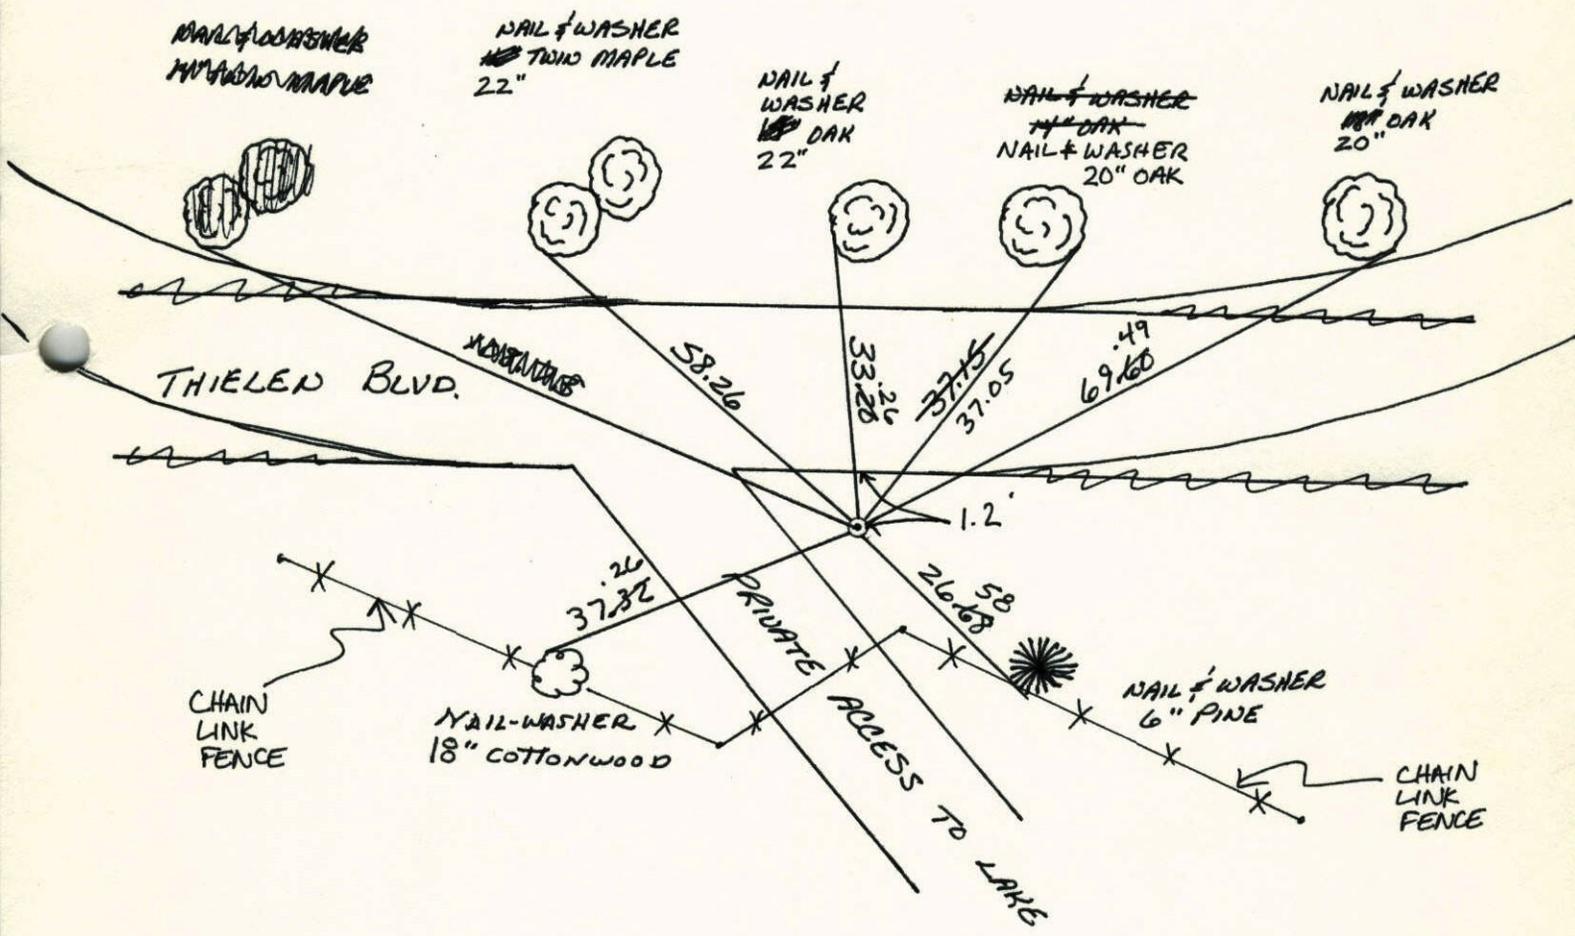


Revised date	Revised date	Revised date
9-25-64	7-31-97	
7-10-70	6-11-02	
7-19-77		
6-12-81		
7-5-84		
6-2-87		
8-18-92		

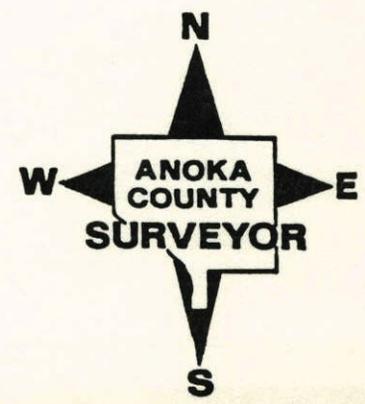

M.C. #12 on S. line Sec. 25-33-23

Set 1 1/2" x 8' Iron Pipe up. 3.5'

Pipe is painted with 1/2' Red & White bands.

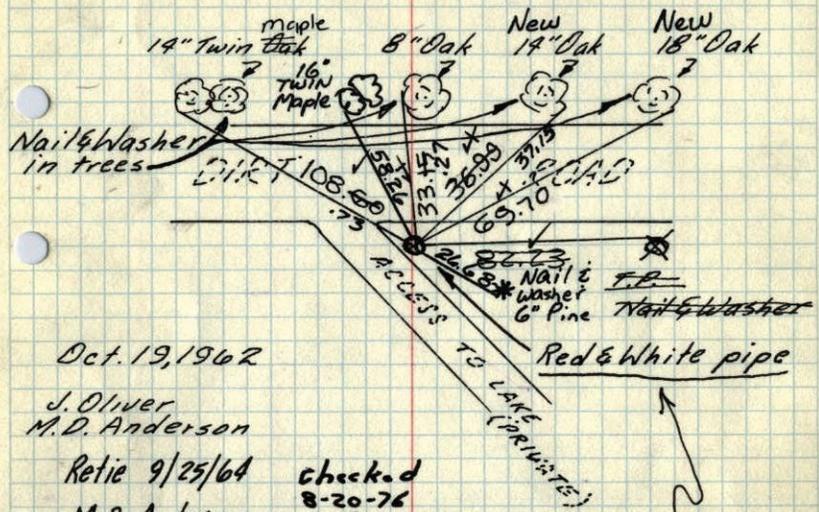

Oct. 19, 1962

J. Oliver
M.D. Anderson

Retie 9/25/64

M.D. Anderson
G. Mills

~~Frederick~~
~~June 9, 1965~~
~~M.D. Anderson~~
~~S. Dunlop~~

Tie Check
July 10, 1970
D. Powell
R. Brien

TIE CHECK
July 19, 1977
R. SAWYER
S. BRIEN
J. SJEDYENS

TIE CHECK
July 5, 1984
R. BENNETT
D. ROSS
G. LIPS

checked
8-20-76
R. Farmer

TIE CHECK
6-12-81
P. ROSS
P. HORNBY
G. NEISINGER

replaced iron pipe
with cast iron rhom

April 23 1971
H. Larson
J. Boettcher

ROLAND W. ANDERSON
COUNTY SURVEYOR
ANOKA COUNTY, MINNESOTA


TEMPERATURE CORRECTED
AND HORIZONTALLY
TAPED MEASUREMENTS

XX

M.C. #12 on S. line Sec. 25-33-23

Set 1 1/2" x 8' Iron Pipe up. 3.5'

Pipe is painted with 1/2' Red & White bands.

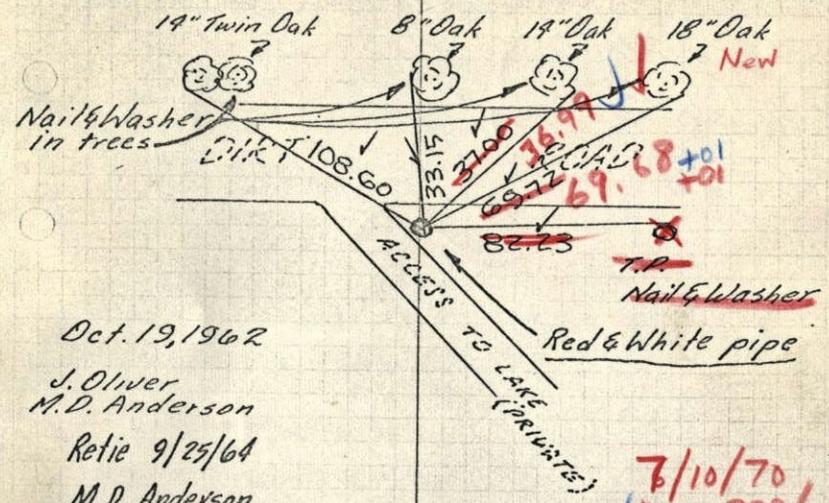

Oct. 19, 1962

J. Oliver
M.D. Anderson

Retie 9/25/64

M.D. Anderson
G. Mills


~~Frederick~~
~~June 9, 1965~~
~~M.D. Anderson~~
~~S. Dunlop~~

7/10/70
#10-880
D. Powell
R. Brien

ROLAND W. ANDERSON
COUNTY SURVEYOR
ANOKA COUNTY, MINNESOTA

TEMPERATURE CORRECTED
AND HORIZONTALLY
TAPED MEASUREMENTS

M.C. #12 on So. Line Sec. 25, T33, R23
 Set 1 1/2" x 8' I.P. Sticking up 3.5' with Top
 4' painted with Alternate Red & White
 Bands.

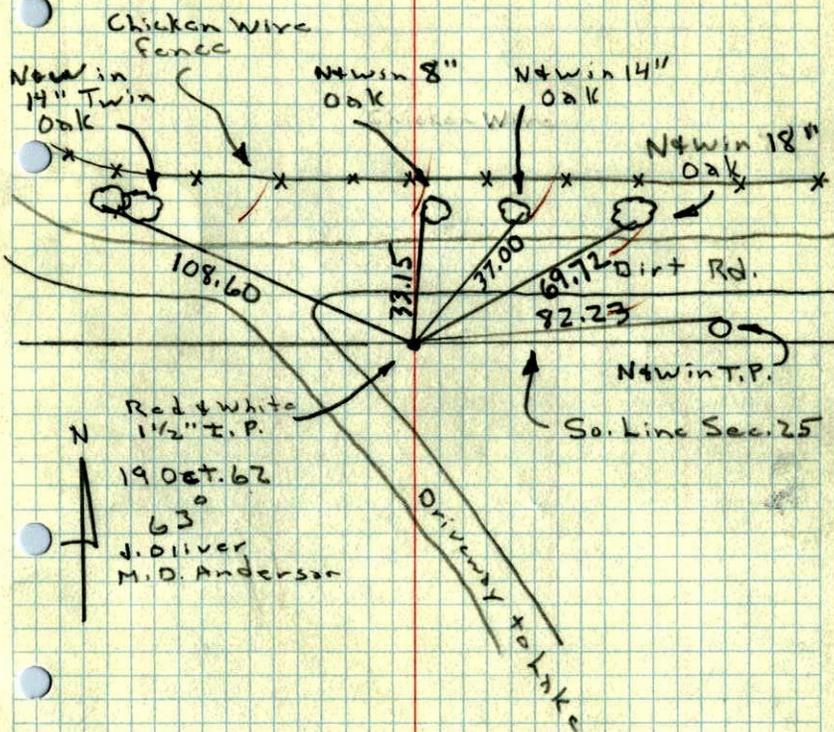

TEMP
 CORR.