NW Cor. Sec. 11, T33, R23

Set Red and white Iron Pipe from Resurvey.

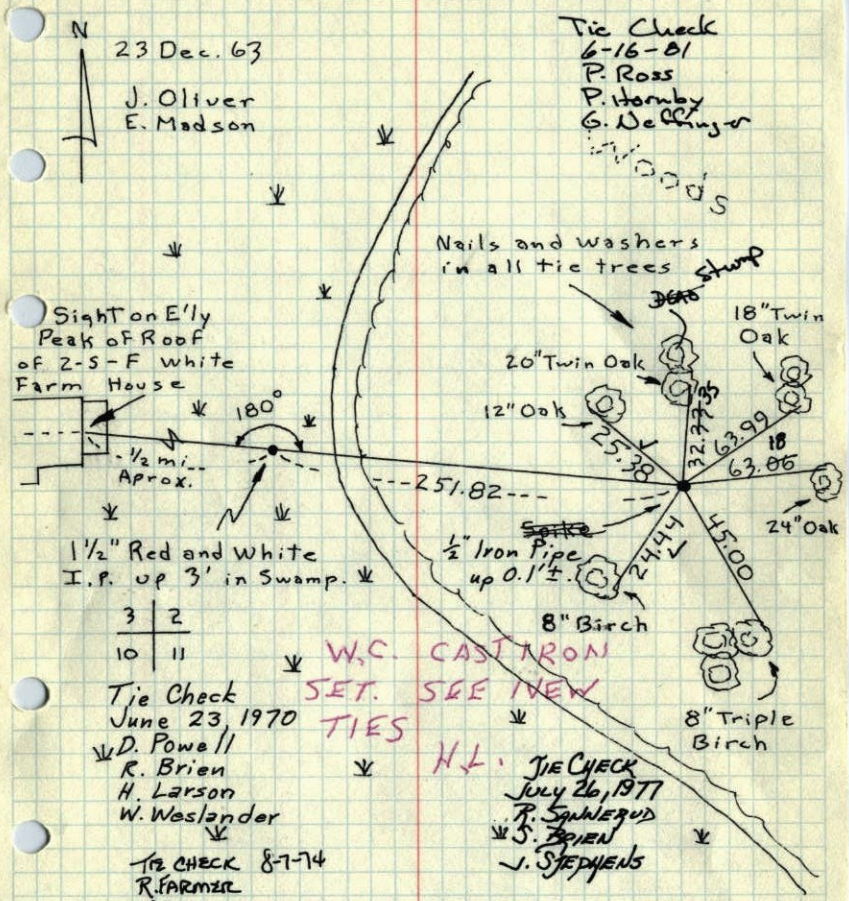

Tie Check
June 23, 1970
D. Powell
R. Brien
H. Larson
W. Weslander

W.C. CAST IRON
SET. SEE NEW
TIES
H.L.

TIE CHECK
JULY 26, 1977
R. SANNERUD
S. BRIEN
J. STEPHENS

TIE CHECK 8-7-74
R. FARMER
N. DAHL
D. DAHL

ROLAND W. ANDERSON
COUNTY SURVEYOR
ANOKA COUNTY, MINNESOTA

TEMPERATURE CORRECTED
AND HORIZONTALLY
TAPED MEASUREMENTS

NW Cor. Sec. 11, T33, R23

Set Red and white Iron Pipe from Resurvey.

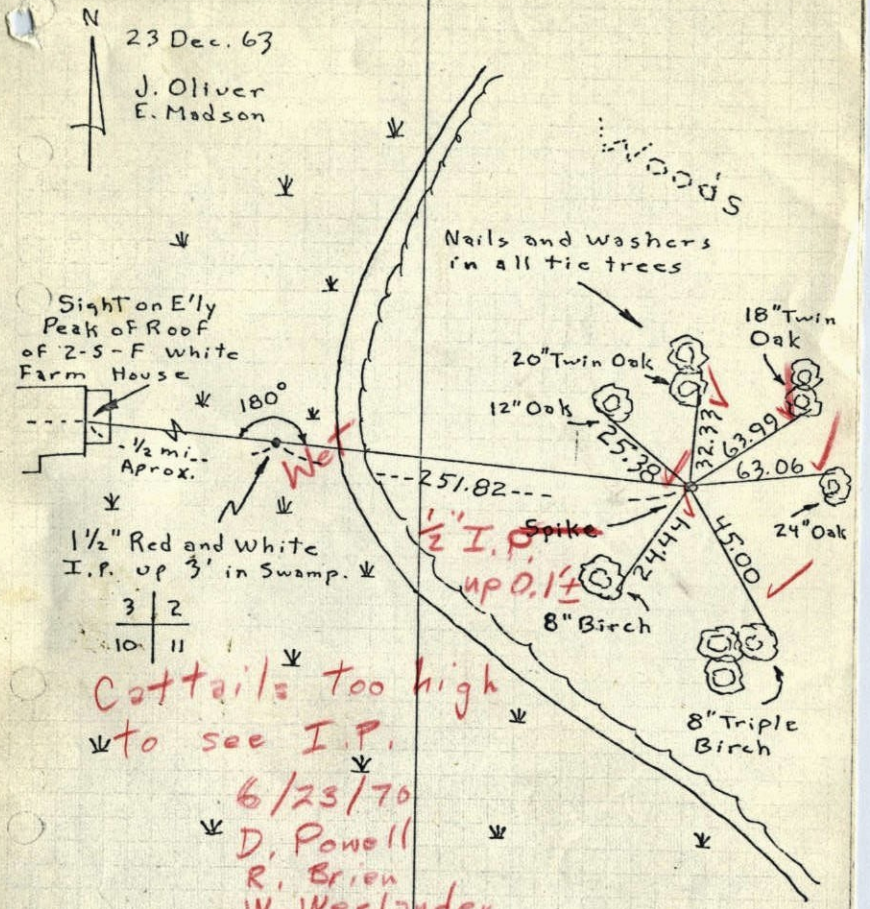

Cattails too high
to see I.P.
6/23/70
D. Powell
R. Brien
W. Weslander
H. Larson

ROLAND W. ANDERSON
COUNTY SURVEYOR
ANOKA COUNTY, MINNESOTA

TEMPERATURE CORRECTED
AND HORIZONTALLY
TAPED MEASUREMENTS

NW Cor. Sec. 11, T 33, R 23
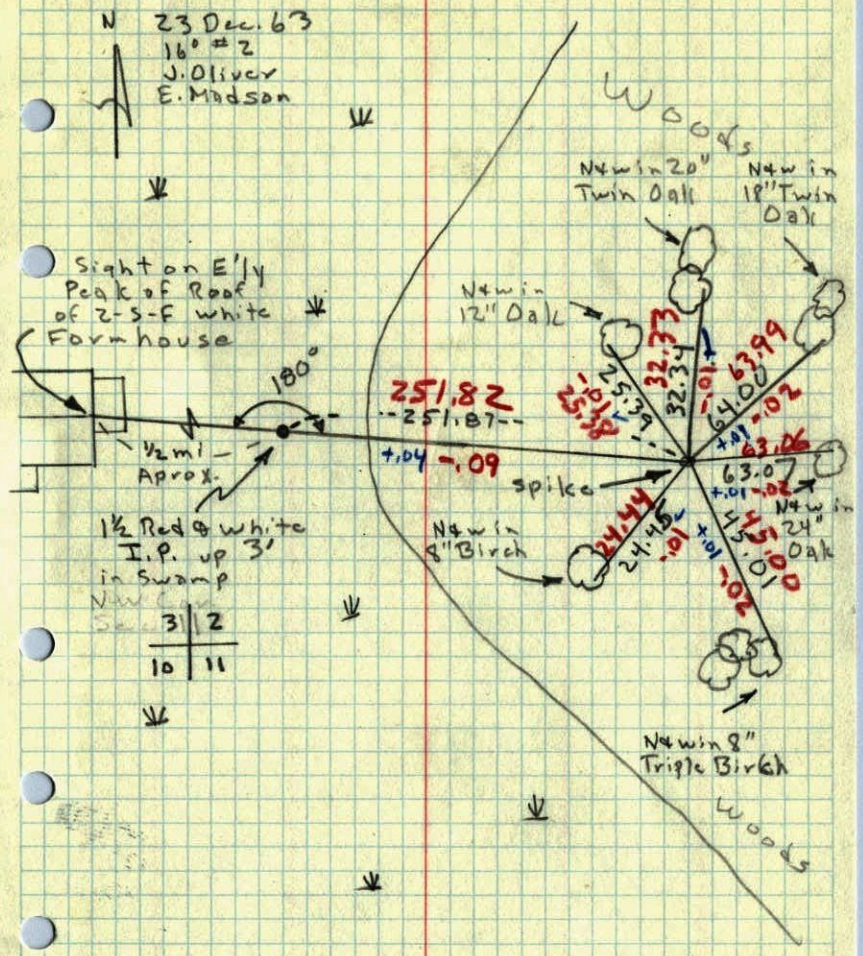
Set Red and white Iron Pipe from Resurvey.