NW Cor. Sec. 7 - T33 - R23

Set Cast Iron Monument flush July 23, 1962

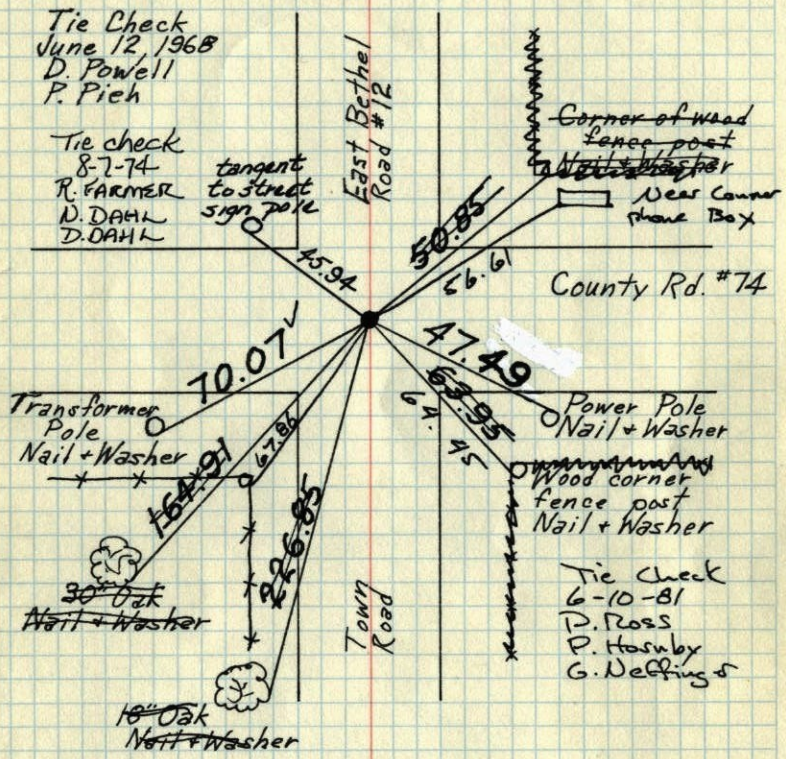

TIE CHECK
29 JUN 77
R. SANNERUD
S. BRIEN
J. STEPHENS

TIE CHECK
6-12-84
D. ROSS
G. LIPS
R. BENNETT

TEMPERATURE CORRECTED AND HORIZONTALLY TAPED MEASUREMENTS

ROLAND W. ANDERSON
COUNTY SURVEYOR
ANOKA COUNTY, MINNESOTA

NW Cor. Sec. 7, T 33, R 23

~~C.I. Mon. yet to be placed in Ground~~

Set Cast Iron Mon. flush July 23, 1962

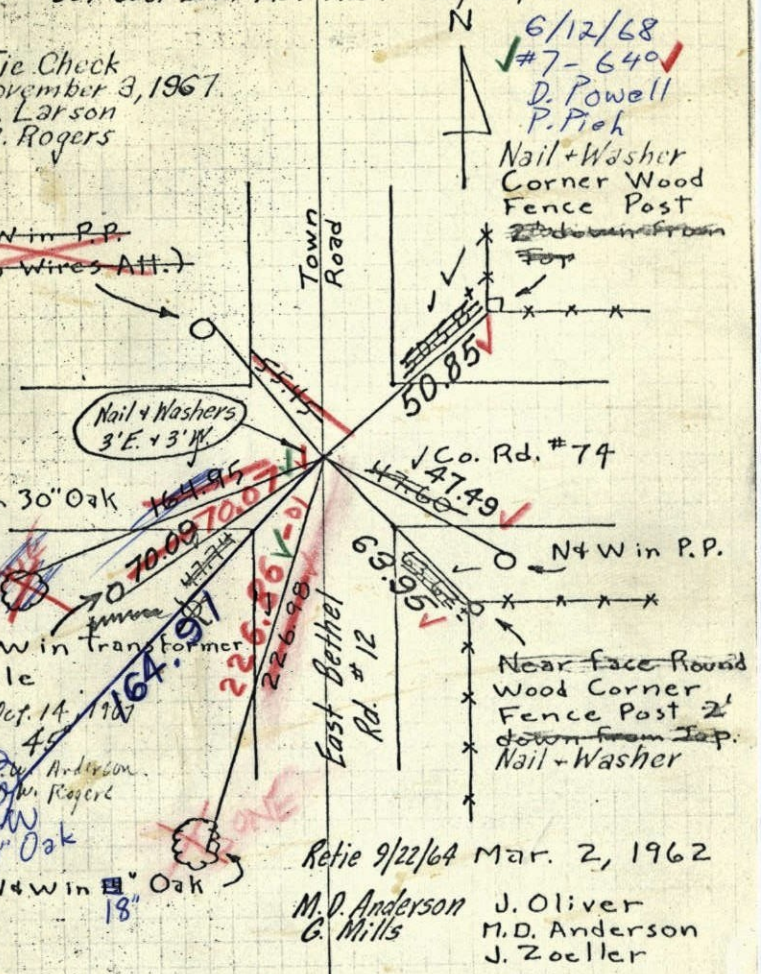

Retie 9/22/64 Mar. 2, 1962

M.D. Anderson
G. Mills

J. Oliver
M.D. Anderson
J. Zoeller

TEMPERATURE CORRECTED AND HORIZONTALLY TAPED MEASUREMENTS

ROLAND W. ANDERSON
COUNTY SURVEYOR
ANOKA COUNTY, MINNESOTA

NW Cor. Sec. 7, T 33, R 23

~~C.I. Mon. yet to be placed in Ground~~

Set Cast Iron Mon. flush July 23, 1962

Nov. 3 1967
Tape 5✓ 30°✓
H. Larson
B. Rogers

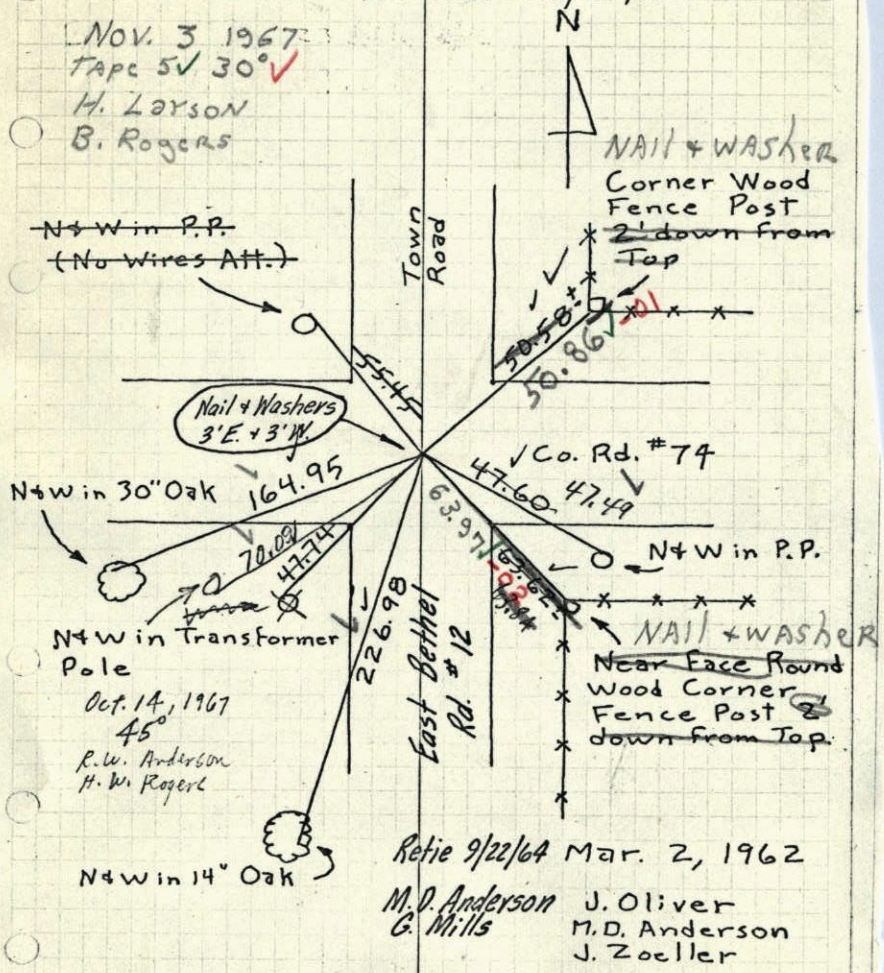

Retie 9/22/64 Mar. 2, 1962

M.D. Anderson
G. Mills

J. Oliver
M.D. Anderson
J. Zoeller

TEMPERATURE CORRECTED AND HORIZONTALLY TAPED MEASUREMENTS

ROLAND W. ANDERSON
COUNTY SURVEYOR
ANOKA COUNTY, MINNESOTA

21

NW Cor. Sec. 7, T 33, R 23

~~C.I. Mon. yet to be placed in Ground~~

Set Cast Iron Mon. flush July 23, 1962

Tie Check
November 3, 1967
H. Larson
B. Rogers

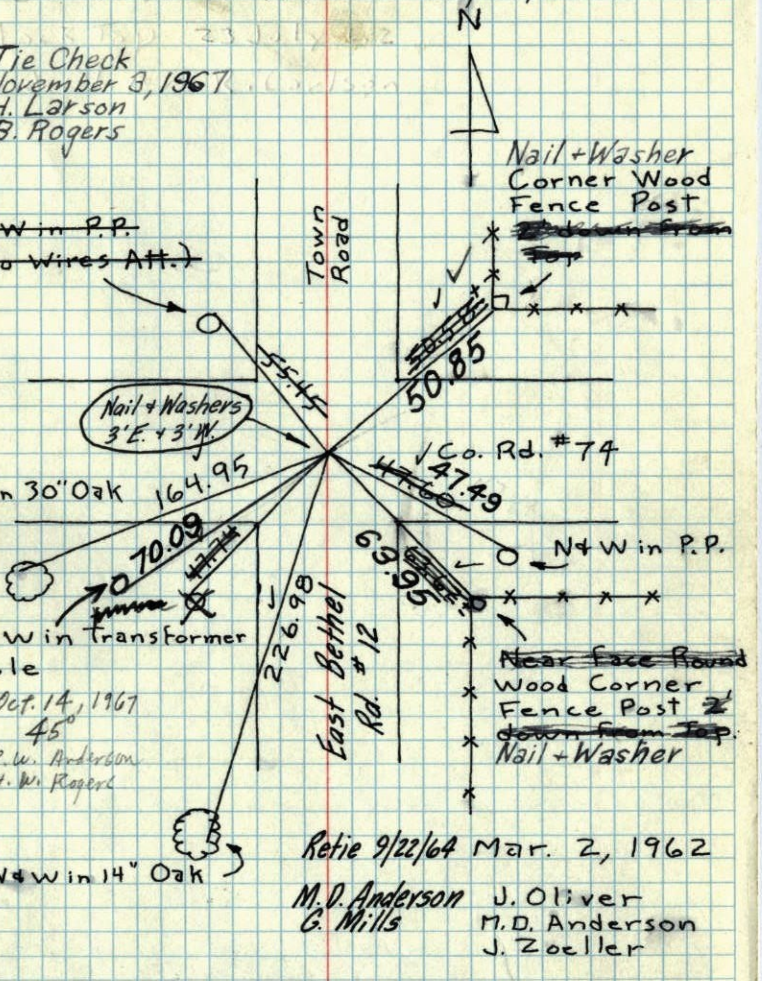

Retie 9/22/64 Mar. 2, 1962

M.D. Anderson
G. Mills

J. Oliver
M.D. Anderson
J. Zoeller

TEMPERATURE CORRECTED AND HORIZONTALLY TAPED MEASUREMENTS

ROLAND W. ANDERSON
COUNTY SURVEYOR
ANOKA COUNTY, MINNESOTA

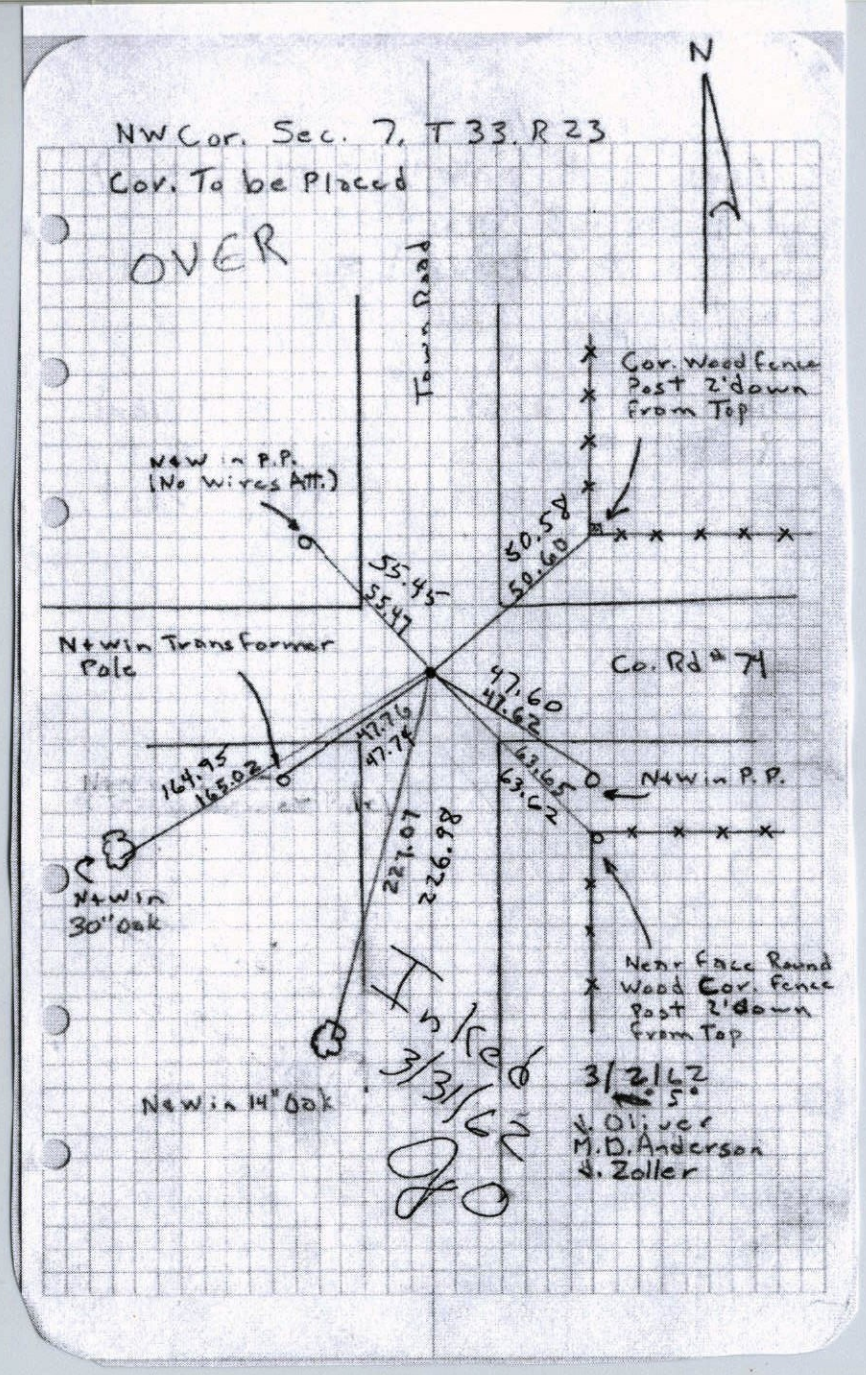

2/26/62

Ties Hit fair (Sept. 60 ties) dug in ± 3' Rad. down 1.5' (down 0.8' Hoium) Could find nothing.

3/2/62

Swung Hoiums Ties — Hit Good Retiet Point but could Set nothing Because of deep frost,