

CERTIFICATE OF LOCATION OF GOVERNMENT CORNER

County of Anoka State of Minnesota


West 1/4 Corner of Sec. 2 Township 33 Range 23

On the 23rd day of December, 1963, the described corner was evidenced by area resurvey

and to perpetuate the location of said corner, at the exact location thereof, a permanent marker was placed consisting of a red and white 1 1/2" galvanized pipe 3' tall

AND on the 18th day of January, 2013, said permanent marker was found and there were no objects to use as ties

Updated reference ties are as shown below.

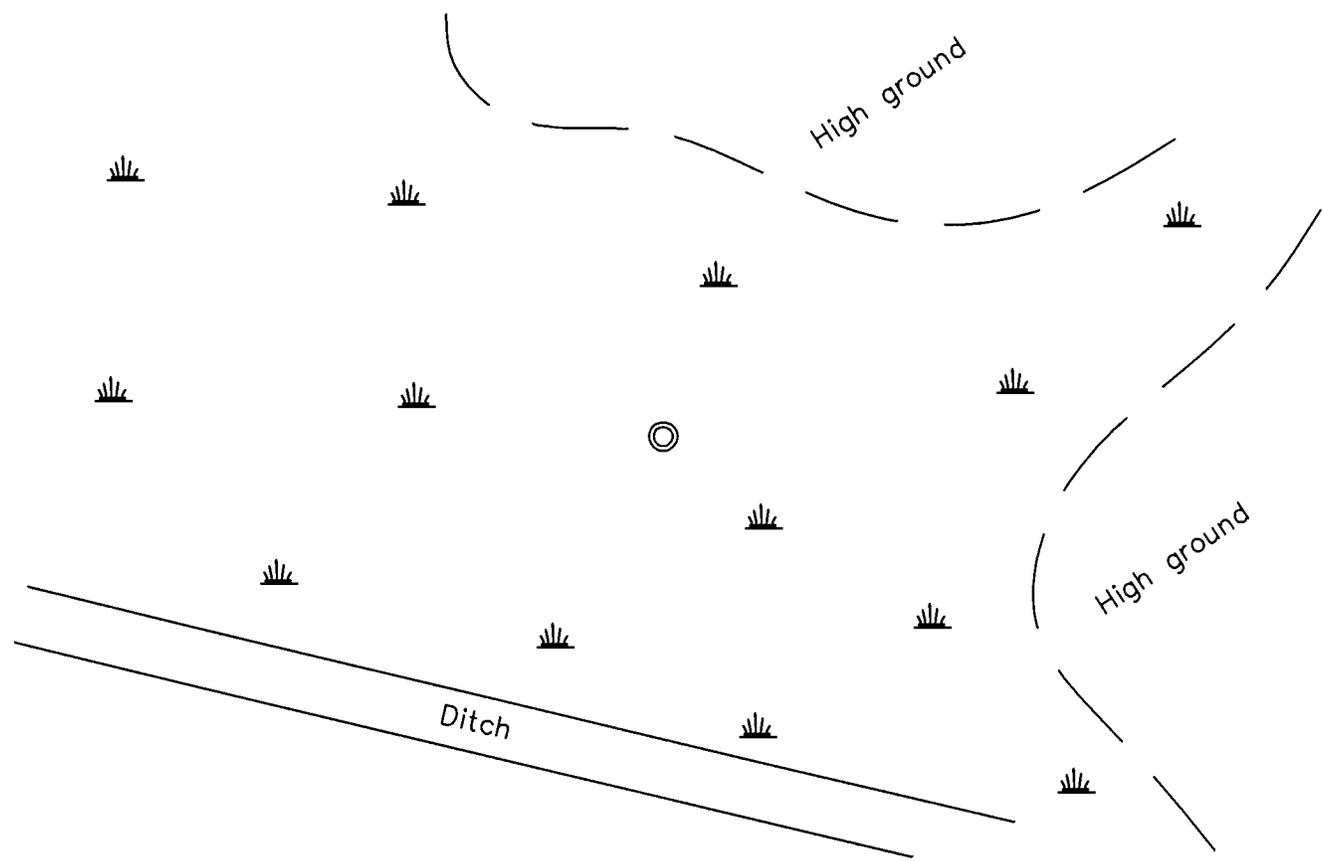

N
W ANOKA COUNTY SURVEYOR E
S

Revision Date
4/16/13

N.A.D. 1983 Coordinates
(1996 Adjustment)

County Project Coordinates	
Northing	224865.2561
Easting	521232.8260
Date	3/12/03

I hereby certify that this United States public land survey monument record is correct and complete to the best of my knowledge and belief.

Larry D. Hoium Date 4/16/13
 Larry D. Hoium, Anoka County Surveyor
 Minnesota License Number 18165