

# CERTIFICATE OF LOCATION OF GOVERNMENT CORNER

County of Anoka

State of Minnesota



## North $\frac{1}{4}$ Corner of Sec. 10 Township 33 Range 23

On the 30th day of April, 1957, the described corner was evidenced by a sand point set by the Highway Department

and to perpetuate the location of said corner, at the exact location thereof, a permanent marker was placed consisting of a cast iron monument

AND on the 26th day of July, 2012, said permanent marker was found down 1'± and the ties were updated

Updated reference ties are as shown below.

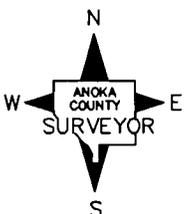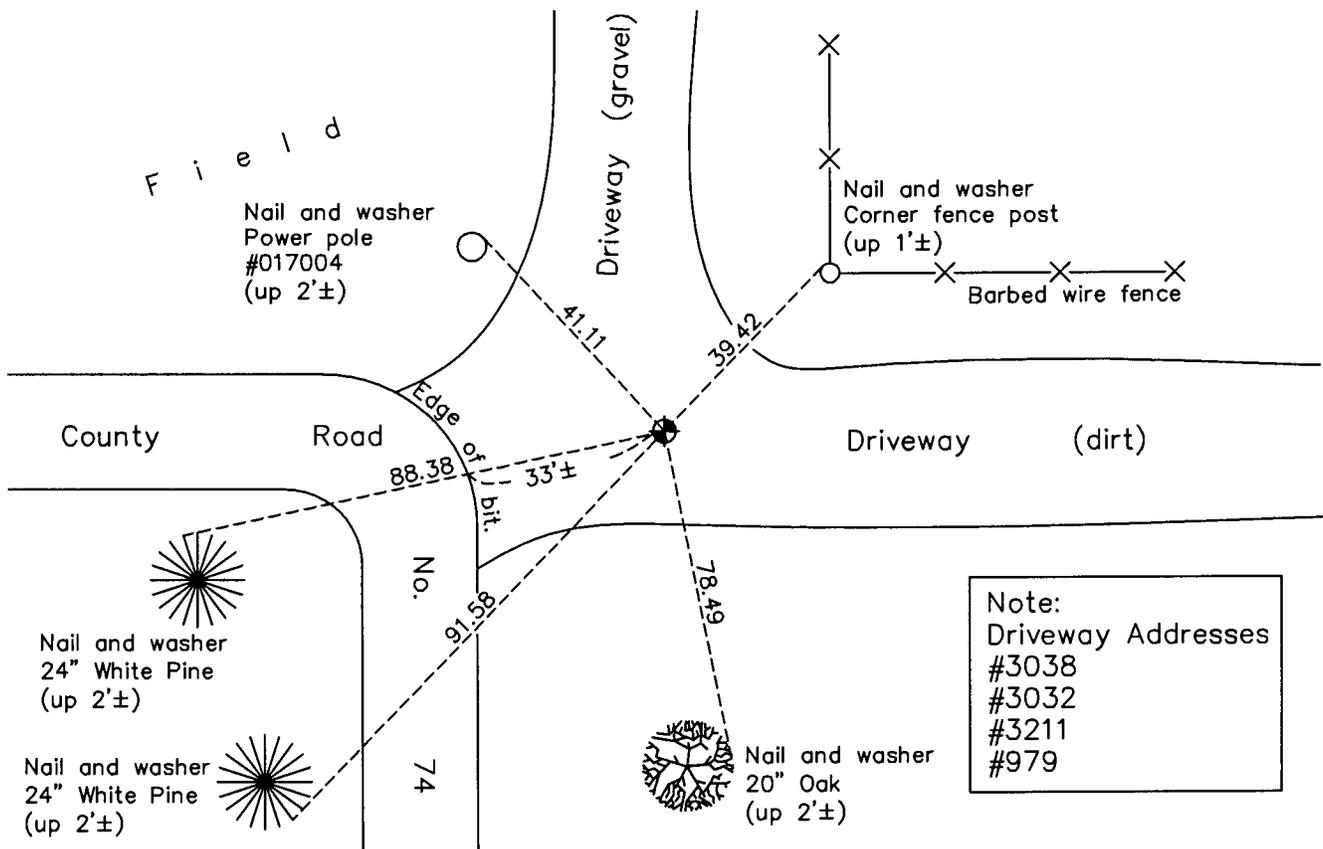

Revision Date  
5/14/13

N.A.D. 1983 Coordinates  
(1996 Adjustment)

County Project Coordinates	
Northing	222172.7516
Easting	518346.3912
Date	4/04/02

I hereby certify that this United States public land survey monument record is correct and complete to the best of my knowledge and belief.

*Larry D. Hoium* Date 5/14/13

Larry D. Hoium, Anoka County Surveyor  
Minnesota License Number 18165