

CERTIFICATE OF LOCATION OF GOVERNMENT CORNER

County of Anoka

State of Minnesota


Southwest Corner of Sec. 4 Township 33 Range 23

On the 18th day of April, 1960, the described corner was evidenced by a concrete monument

and to perpetuate the location of said corner, at the exact location thereof, a permanent marker was placed consisting of a cast iron monument

AND on the 19th day of October, 2015, said permanent marker was found and raised to flush with the surface. The ties were updated.

Updated reference ties are as shown below.

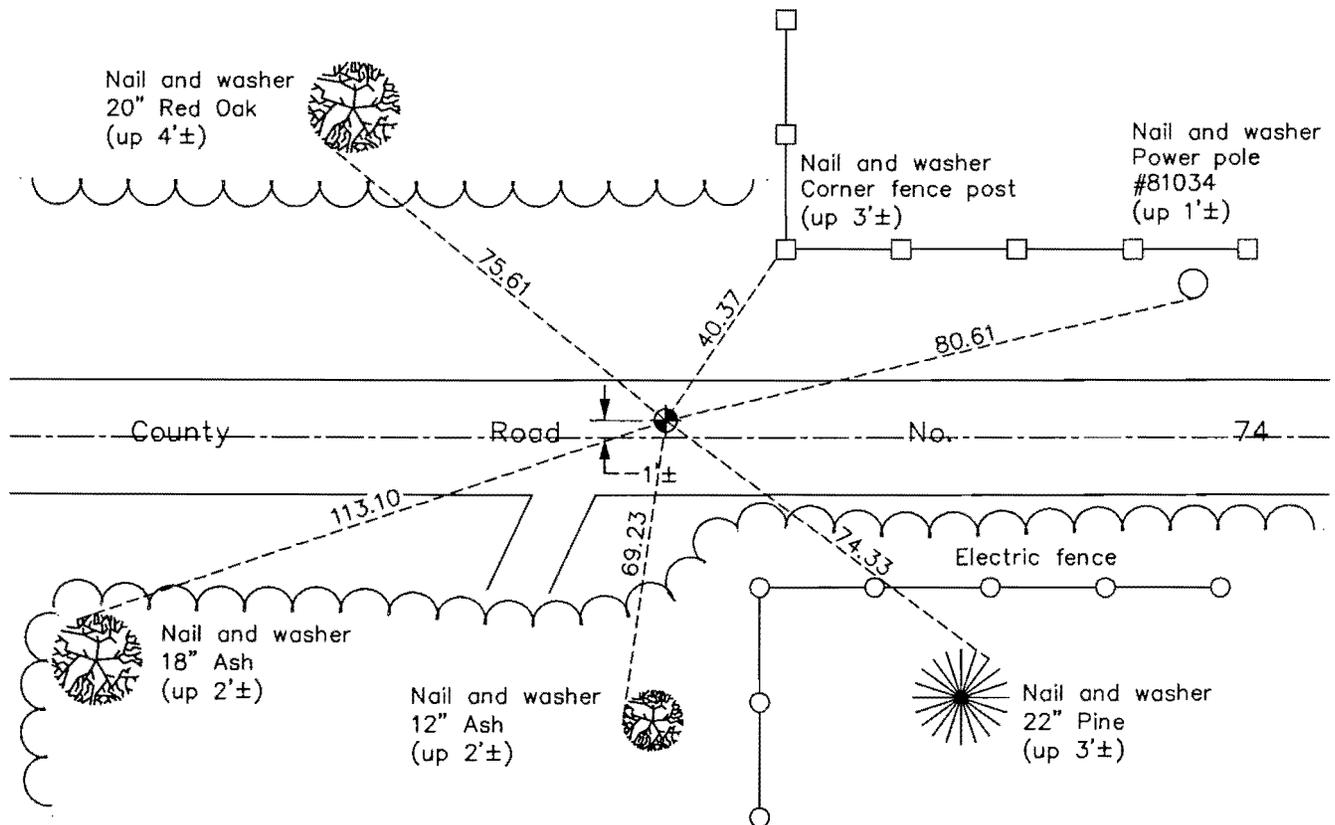

N
W ANOKA COUNTY SURVEYOR E
S

Revision Date
4/11/16

N.A.D. 1983 Coordinates
(1996 Adjustment)

County Project Coordinates	
Northing	222235.9360
Easting	510333.2737
Date	4/02/02

I hereby certify that this United States public land survey monument record is correct and complete to the best of my knowledge and belief.

Larry D. Hoium Date 4/11/16

Larry D. Hoium, Anoka County Surveyor
Minnesota License Number 18165