CERTIFICATE OF LOCATION OF GOVERNMENT CORNER

County of Anoka State of Minnesota

North 1/4 Corner of Sec. 8 Township 33 Range 23

On the 28th day of August, 1961, the described corner was evidenced by an iron pipe

and to perpetuate the location of said corner, at the exact location thereof, a permanent marker was placed consisting of a cast iron monument

AND on the 18th day of January, 2013, said permanent marker was found and the position was verified using VRS Global Positioning Systems. Ties were unable to be updated due to traffic.

Updated reference ties are as shown below.

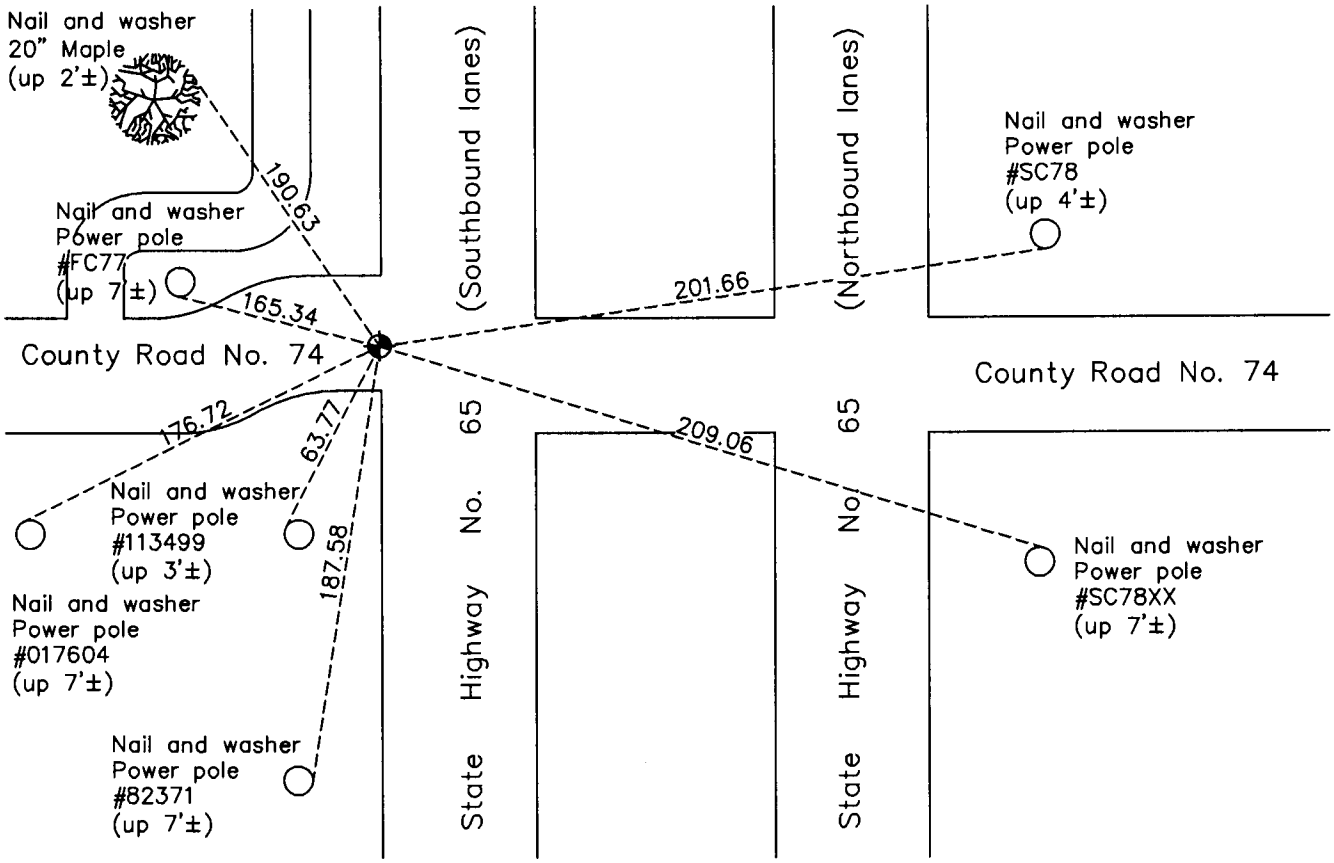

N
W ANOKA COUNTY SURVEYOR E
S

Revision Date
11/22/13

N.A.D. 1983 Coordinates
(1996 Adjustment)

County Project Coordinates	
Northing	222274.5103
Easting	507678.3594
Date	9/19/06

I hereby certify that this United States public land survey monument record is correct and complete to the best of my knowledge and belief.

Date 11/22/13

Larry D. Hoium, Anoka County Surveyor

Minnesota License Number 18165