CERTIFICATE OF LOCATION OF GOVERNMENT CORNER

County of Anoka State of Minnesota

Northeast Corner of Sec. 7 Township 33 Range 23

On the 28th day of August, 1961, the described corner was evidenced by an iron pipe

and to perpetuate the location of said corner, at the exact location thereof, a permanent marker was placed consisting of a cast iron monument

AND on the 18th day of January, 2013, said permanent marker was found and the ties were updated

Updated reference ties are as shown below.

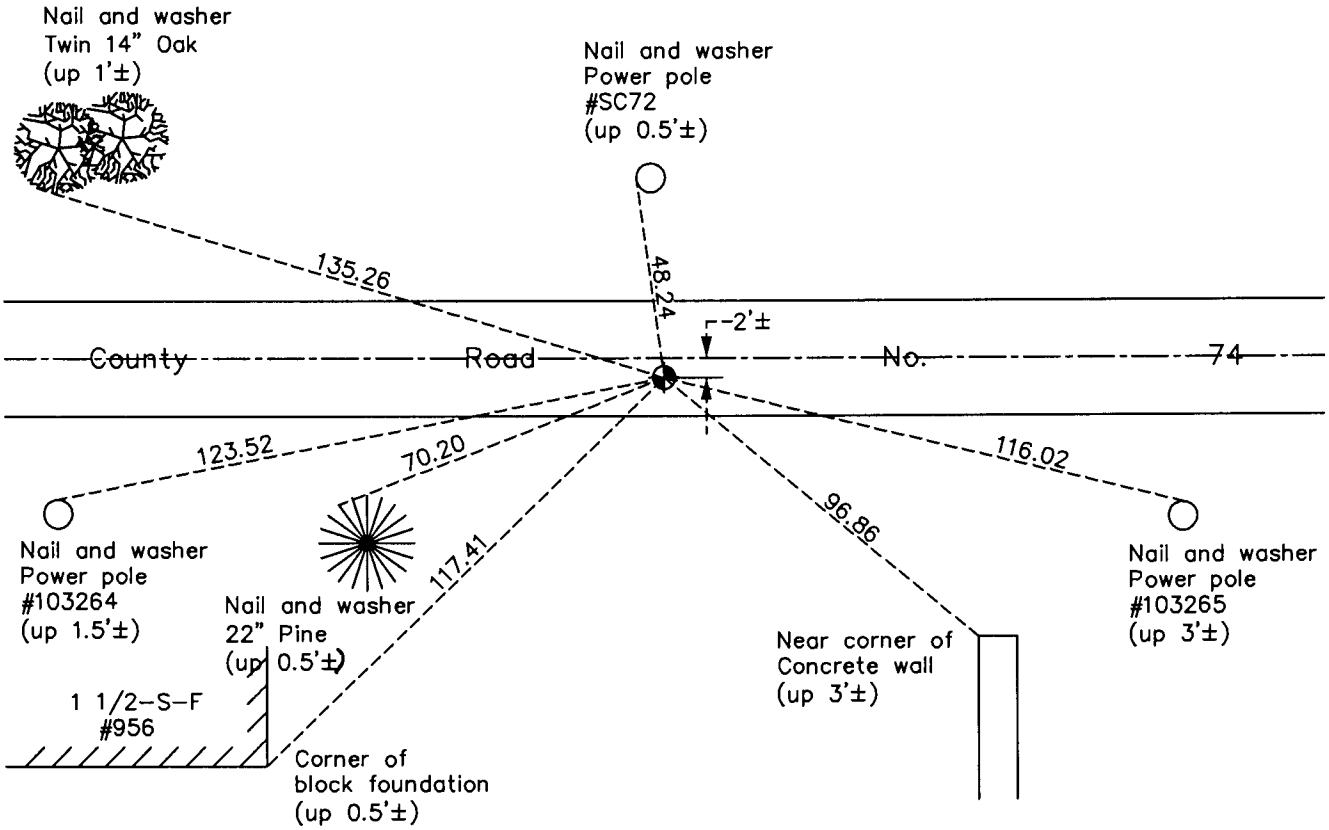

N
W ANOKA COUNTY SURVEYOR E
S

Revision Date
5/17/13

N.A.D. 1983 Coordinates
(1996 Adjustment)

County Project Coordinates	
Northing	222283.5581
Easting	505041.3095
Date	4/04/02

I hereby certify that this United States public land survey monument record is correct and complete to the best of my knowledge and belief.

Larry D. Hoium Date 5/17/13

Larry D. Hoium, Anoka County Surveyor

Minnesota License Number 18165