

CERTIFICATE OF LOCATION OF GOVERNMENT CORNER

County of Anoka

State of Minnesota



East 1/4 Corner of Sec. 8 Township 33 Range 23

On the 5th day of February, 1963, the described corner was evidenced by a 3/4" iron pipe

and to perpetuate the location of said corner, at the exact location thereof, a permanent marker was placed consisting of a cast iron monument with a sign and post on the south side

AND on the 3rd day of April, 2013, said permanent marker was found and the ties were updated. The sign and post were found to be missing.

Updated reference ties are as shown below.

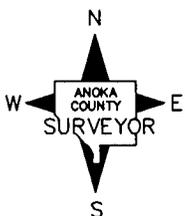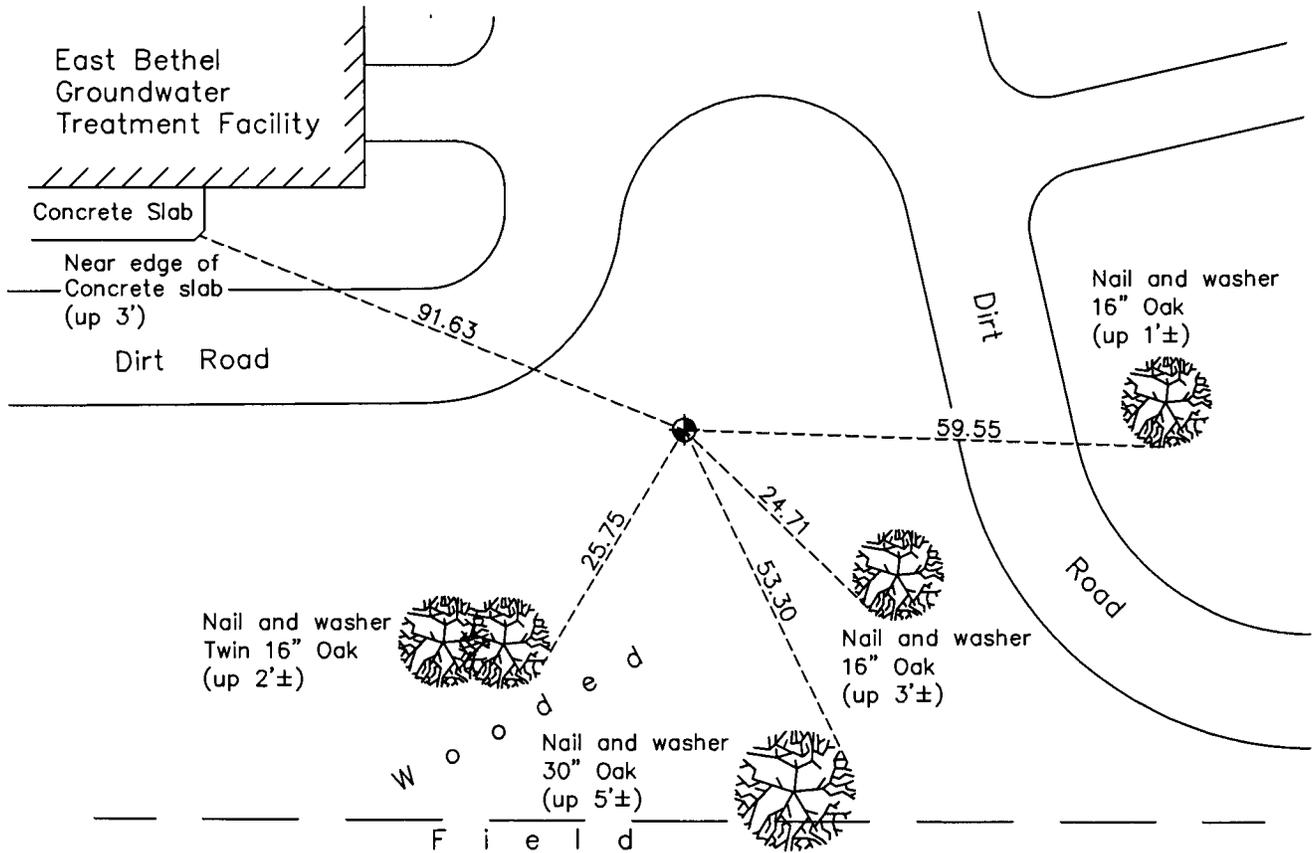

Revision Date
 5/30/13

N.A.D. 1983 Coordinates
 (1996 Adjustment)

County Project Coordinates	
Northing	219534.3317
Easting	510285.6267
Date	7/02/02

I hereby certify that this United States public land survey monument record is correct and complete to the best of my knowledge and belief.

Larry D. Hoium Date 5/30/13
 Larry D. Hoium, Anoka County Surveyor
 Minnesota License Number 18165