

CERTIFICATE OF LOCATION OF GOVERNMENT CORNER

County of Anoka State of Minnesota



Southeast Corner of Sec. 8 Township 33 Range 23

On the 2nd day of June, 1964, the described corner was evidenced by area resurvey

and to perpetuate the location of said corner, at the exact location thereof, a permanent marker was placed consisting of a red and white iron pipe

AND on the 6th day of February, 2013, said permanent marker was found to be a red and white 2" square Telspar monument with a sign attached facing west

Updated reference ties are as shown below.

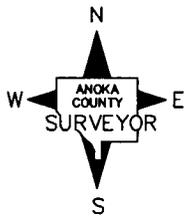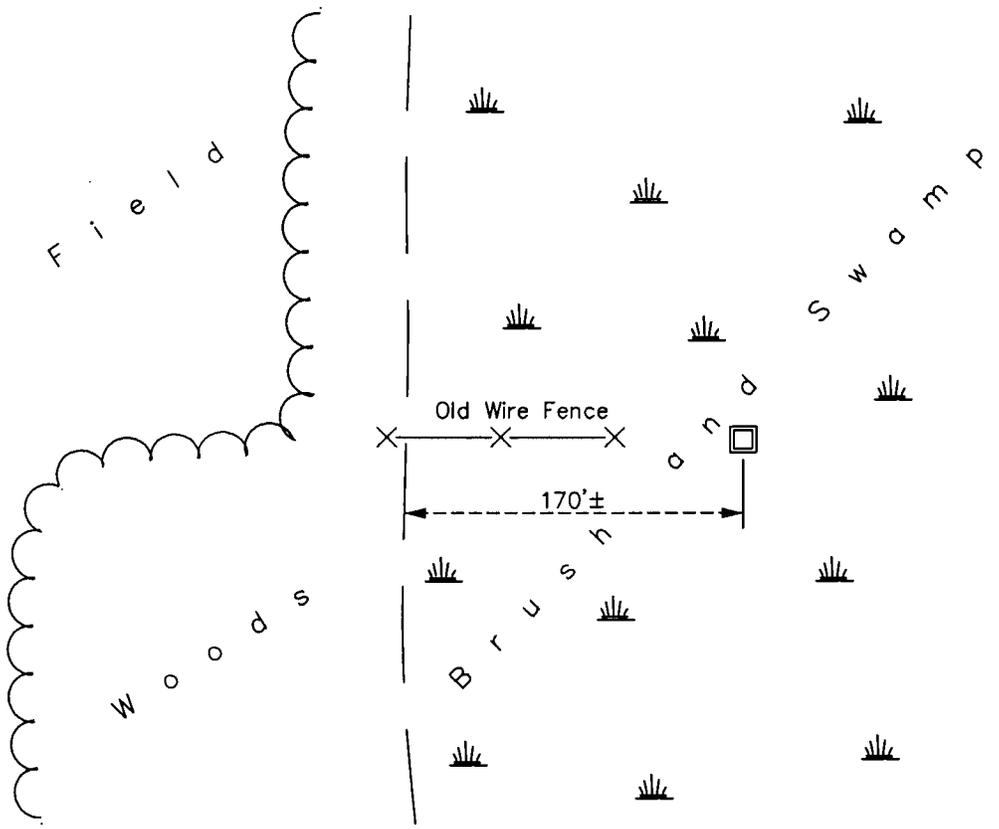

Revision Date
6/20/13

N.A.D. 1983 Coordinates
 (1996 Adjustment)

County Project Coordinates	
Northing	<u>216921.9471</u>
Easting	<u>510278.4189</u>
Date	<u>3/10/03</u>

I hereby certify that this United States public land survey monument record is correct and complete to the best of my knowledge and belief.

Larry D. Hoium Date 6/20/13

Larry D. Hoium, Anoka County Surveyor
 Minnesota License Number 18165