

CERTIFICATE OF LOCATION OF GOVERNMENT CORNER

County of Anoka

State of Minnesota


Northwest Corner of Sec. 20 Township 33 Range 23

On the 13th day of February, 1962, the described corner was evidenced by a 1 1/2" broken well point

and to perpetuate the location of said corner, at the exact location thereof, a permanent marker was placed consisting of a cast iron monument

AND on the day of January, 2013, said permanent marker was found and the ties were updated

Updated reference ties are as shown below.

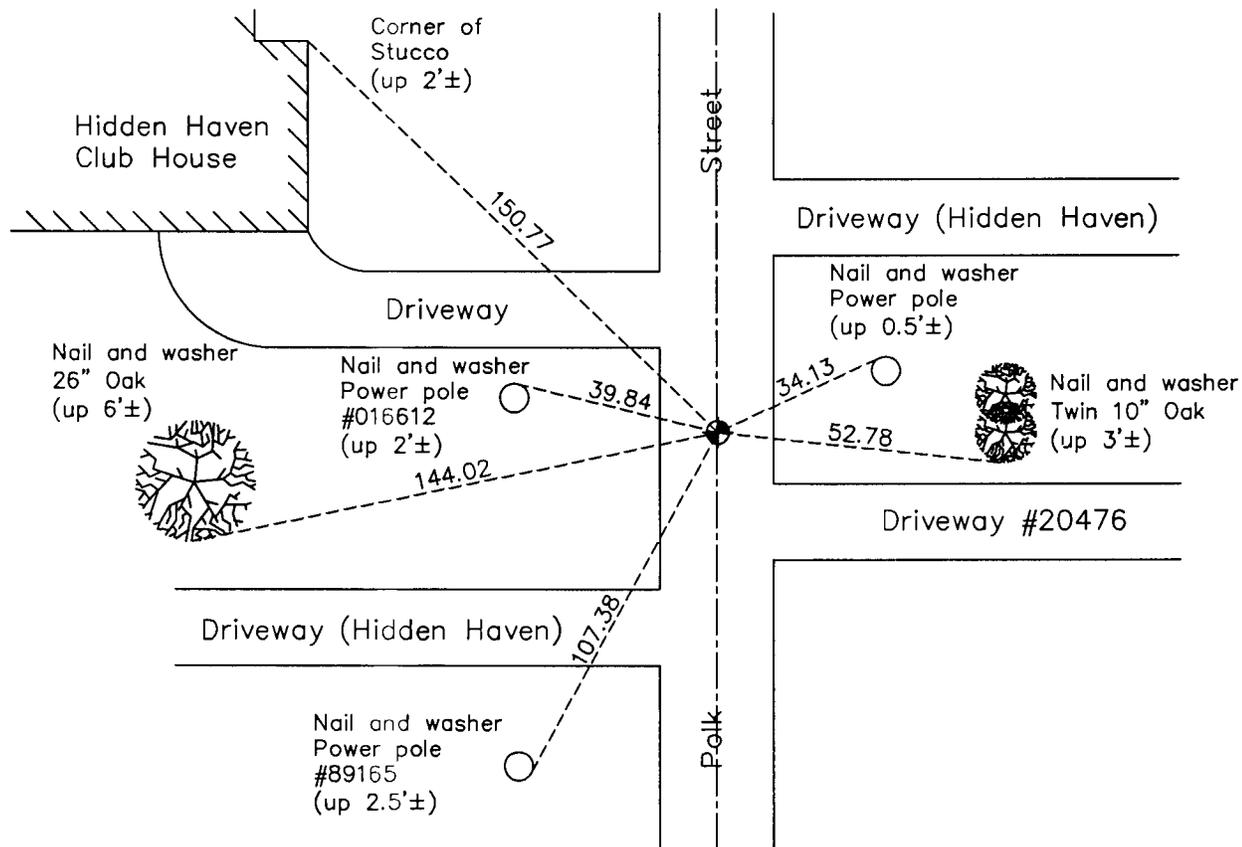

N

 S

Revision Date
7/23/13

N.A.D. 1983 Coordinates
(1996 Adjustment)

County Project Coordinates	
Northing	211678.6202
Easting	505014.8322
Date	4/05/02

I hereby certify that this United States public land survey monument record is correct and complete to the best of my knowledge and belief.

Larry D. Hoium Date 7/23/13

Larry D. Hoium, Anoka County Surveyor
 Minnesota License Number 18165