CERTIFICATE OF LOCATION OF GOVERNMENT CORNER

County of Anoka State of Minnesota

West 1/4 Corner of Sec. 24 Township 33 Range 23

On the 28th day of October, 1970, the described corner was evidenced by area resurvey

and to perpetuate the location of said corner, at the exact location thereof, a permanent marker was placed consisting of a cast iron monument with a sign and post on the north side

AND on the 29th day of January, 2013, said permanent marker was found down 0.2'±. All ties to trees were found missing with no additional features available for ties.

Updated reference ties are as shown below.

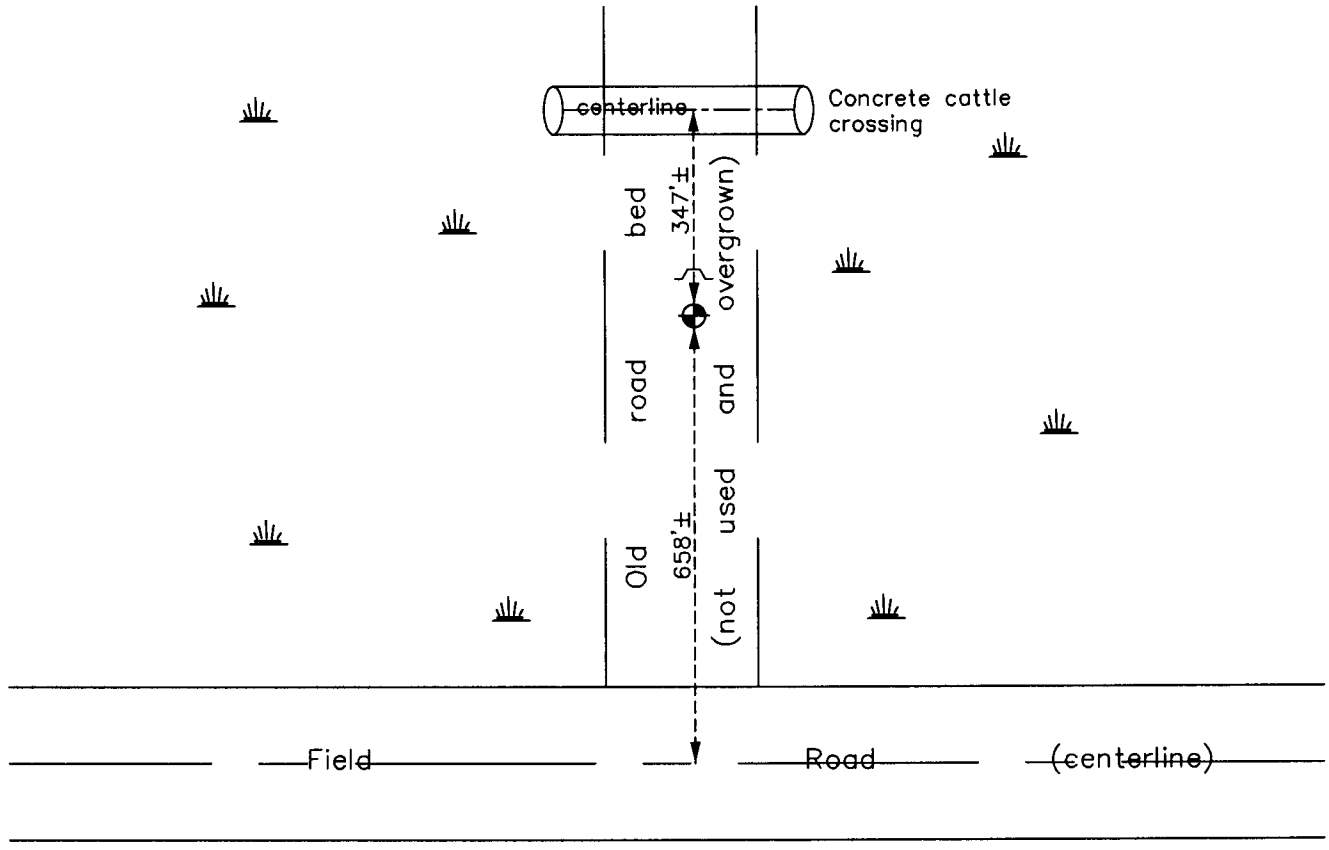

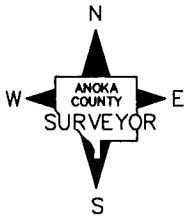

Revision Date
7/30/13

N.A.D. 1983 Coordinates
(1996 Adjustment)

County Project Coordinates	
Northing	208863.3110
Easting	526401.6593
Date	3/12/03

I hereby certify that this United States public land survey monument record is correct and complete to the best of my knowledge and belief.

Date 7/30/13

Larry D. Hoium, Anoka County Surveyor

Minnesota License Number 18165