

# CERTIFICATE OF LOCATION OF GOVERNMENT CORNER

County of Anoka

State of Minnesota

## Meander Corner of Sec. 25 Township 33 Range 23



(Meander Corner No. 15—on east line of section)

On the 15th day of June, 1960, the described corner was evidenced by a concrete monument

and to perpetuate the location of said corner, at the exact location thereof, a permanent marker was placed consisting of the same concrete monument with a sign and post on the south side

AND on the 22nd day of February, 2013, said permanent marker was found down 0.2'± and 0.5'± west of fence and the ties were updated. Top of monument is chipped.

Updated reference ties are as shown below.

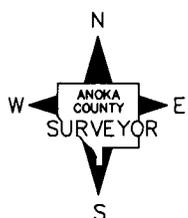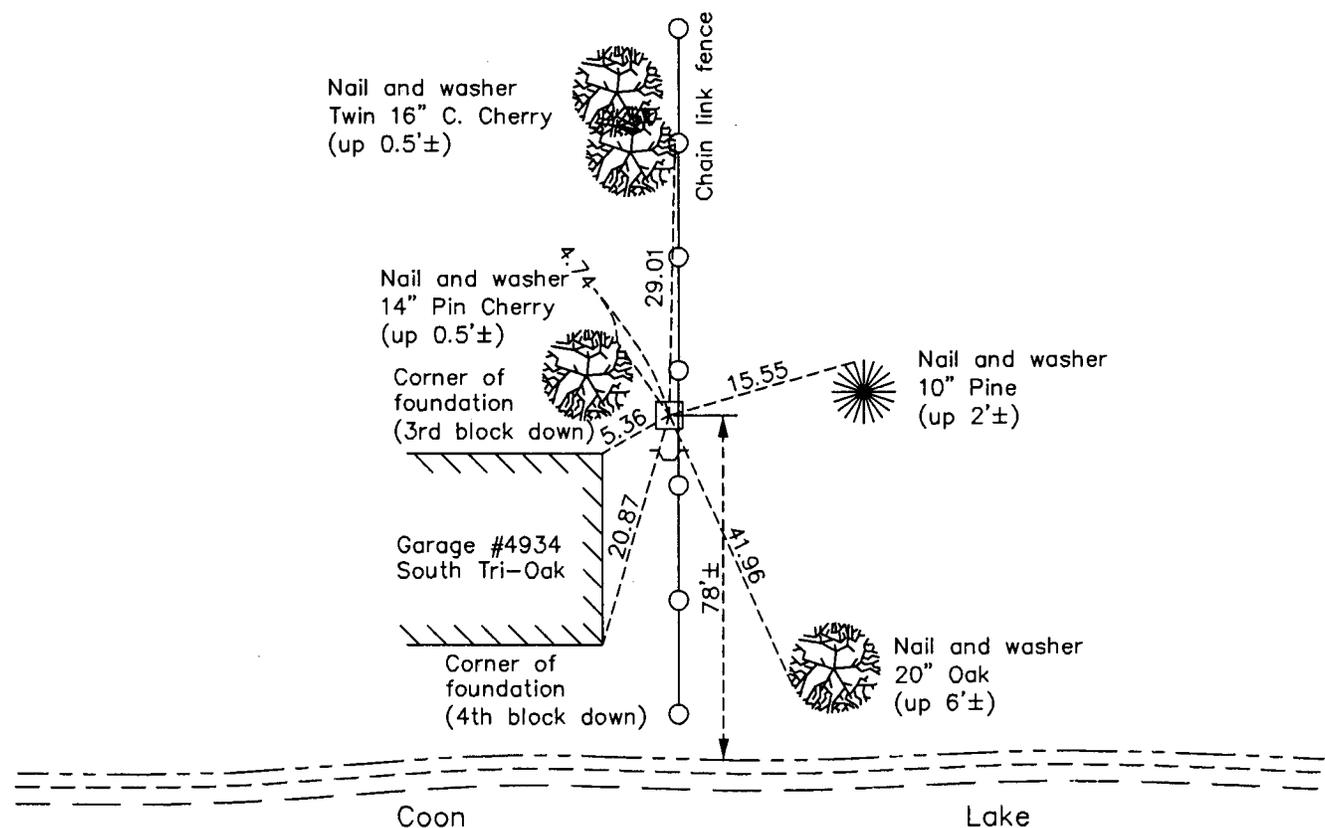

Revision Date  
8/29/13

N.A.D. 1983 Coordinates  
(1996 Adjustment)

County Project Coordinates	
Northing	203832.9391
Easting	531840.1648
Date	7/15/02

I hereby certify that this United States public land survey monument record is correct and complete to the best of my knowledge and belief.

*Larry D. Hoium* Date 8/29/13  
 Larry D. Hoium, Anoka County Surveyor  
 Minnesota License Number 18165