

CERTIFICATE OF LOCATION OF GOVERNMENT CORNER

County of Anoka

State of Minnesota

Meander Corner of Sec. 35 Township 33 Range 23


(Meander Cor. No. 10—On north line of section)

On the 13th day of June, 1960, the described corner was evidenced by a concrete monument

and to perpetuate the location of said corner, at the exact location thereof, a permanent marker was placed consisting of a cast iron monument

AND on the 20th day of June, 1985, said permanent marker was not found

Updated reference ties are as shown below.

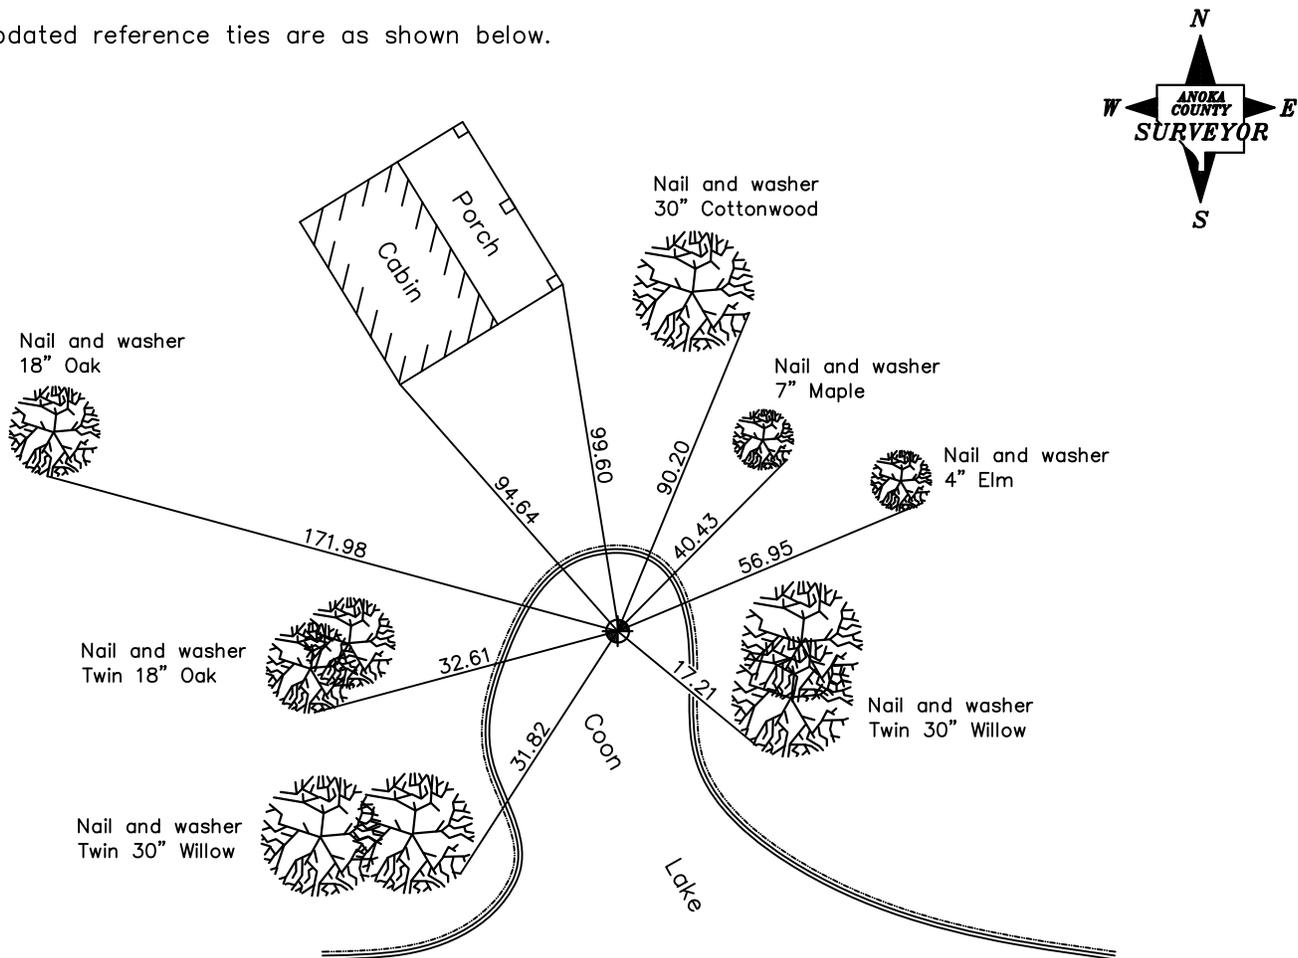

Revised date

6/12/81
7/06/84
6/20/85

N.A.D. 1983 Coordinates
(1996 Adjustment)

County Project Coordinates
Northing <u>not available</u>
Easting _____
Date _____

I hereby certify that this United States public land survey monument record is correct and complete to the best of my knowledge and belief.

_____ Date _____
 _____, Anoka County Surveyor
 Minnesota License Number _____