

# CERTIFICATE OF LOCATION OF GOVERNMENT CORNER

County of Anoka

State of Minnesota



## North 1/4 Corner of Sec. 31 Township 33 Range 23

On the 26th day of April, 1982, the described corner was evidenced by an old well  
point down 0.5'± at intersection of fences

and to perpetuate the location of said corner, at the exact location thereof, a permanent marker  
 was placed consisting of a cast iron monument

AND on the 12th day of February, 2013, said permanent marker was found and the ties  
were updated

Updated reference ties are as shown below.

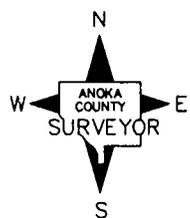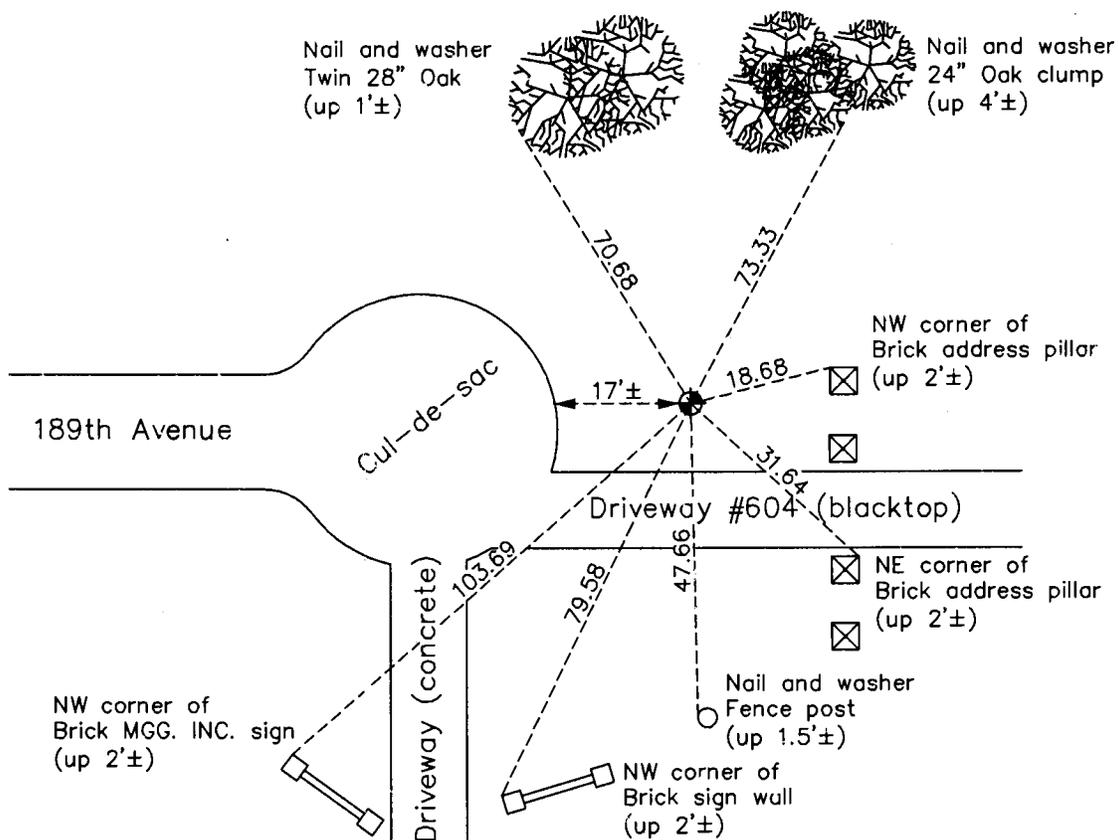

N.A.D. 1983 Coordinates  
(1996 Adjustment)

County Project Coordinates	
Northing	<u>201119.7950</u>
Easting	<u>502652.9167</u>
Date	<u>5/08/02</u>

Revision Date  
9/09/13

I hereby certify that this United States public land survey monument record is correct and complete to the best of my knowledge and belief.

*Larry D. Hoium* Date 9/09/13

Larry D. Hoium, Anoka County Surveyor

Minnesota License Number 18165