

# CERTIFICATE OF LOCATION OF GOVERNMENT CORNER

County of Anoka

State of Minnesota

## Meander Corner of Sec. 35 Township 33 Range 23



(Meander Corner No. 15—on west line of section)

On the 20th day of January, 1961, the described corner was evidenced by a 1 1/2" iron pipe

and to perpetuate the location of said corner, at the exact location thereof, a permanent marker was placed consisting of a cast iron monument

AND on the 4th day of April, 2013, said permanent marker was found and the ties were updated

Updated reference ties are as shown below.

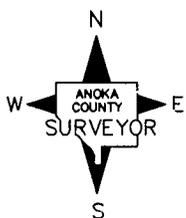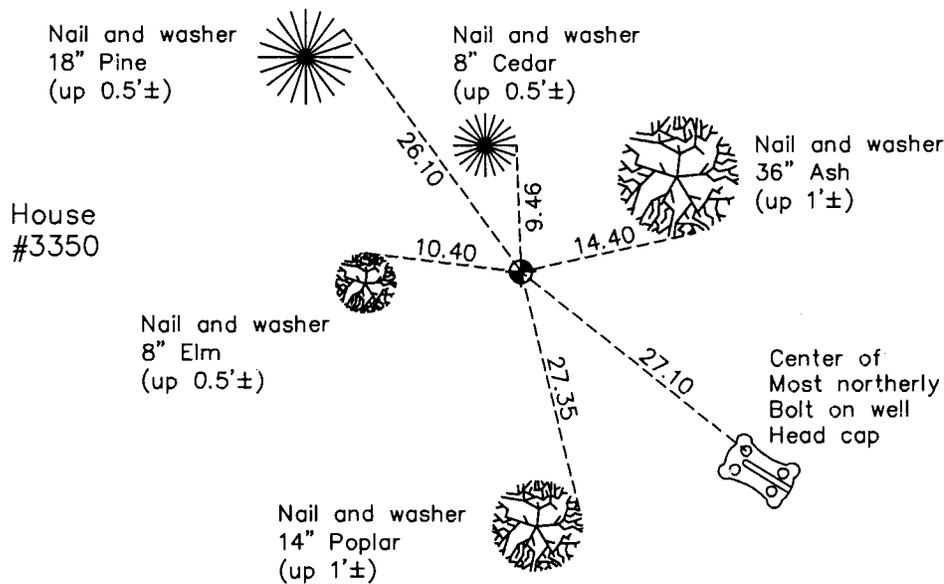

Revision Date  
9/10/13

N.A.D. 1983 Coordinates  
(1996 Adjustment)

County Project Coordinates	
Northing	196885.4544
Easting	521318.5335
Date	3/18/03

I hereby certify that this United States public land survey monument record is correct and complete to the best of my knowledge and belief.

*Larry D. Hoium* Date 9/10/13

Larry D. Hoium, Anoka County Surveyor

Minnesota License Number 18165