

# CERTIFICATE OF LOCATION OF GOVERNMENT CORNER

County of Anoka

State of Minnesota



## North 1/4 Corner of Sec. 5 Township 33 Range 23

On the 14th day of July, 1967, the described corner was evidenced by an iron pipe

and to perpetuate the location of said corner, at the exact location thereof, a permanent marker was placed consisting of a cast iron monument

AND on the 18th day of January, 2013, said permanent marker was found and the ties were updated

Updated reference ties are as shown below.

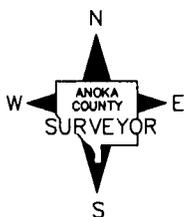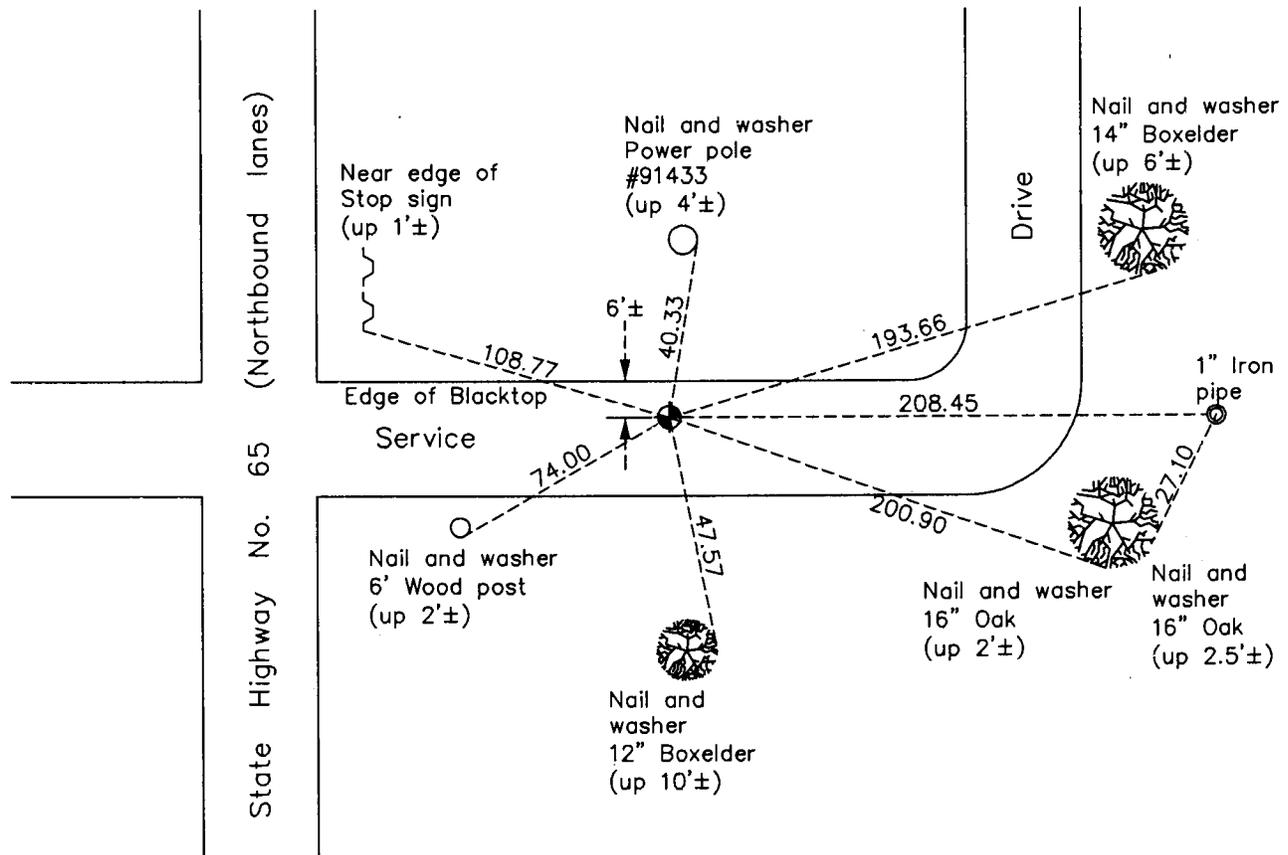

Revision Date

10/22/13

N.A.D. 1983 Coordinates  
(1996 Adjustment)

County Project Coordinates

Northing 227442.5257

Easting 508335.8710

Date 5/20/02

I hereby certify that this United States public land survey monument record is correct and complete to the best of my knowledge and belief.

*Lotry D. Hoium* Date 10/22/13

Lotry D. Hoium, Anoka County Surveyor

Minnesota License Number 18165