

CERTIFICATE OF LOCATION OF GOVERNMENT CORNER

County of Anoka

State of Minnesota


Witness Corner of Sec. 12 Township 30 Range 24
 (On east line of section)

On the 12th day of September, 1960, the described corner was evidenced by a granite monument

and to perpetuate the location of said corner, at the exact location thereof, a permanent marker was placed consisting of a cast iron monument with a sign and post on the north side

AND on the 28th day of August, 2008, said permanent marker was found and the ties were updated

Updated reference ties are as shown below.

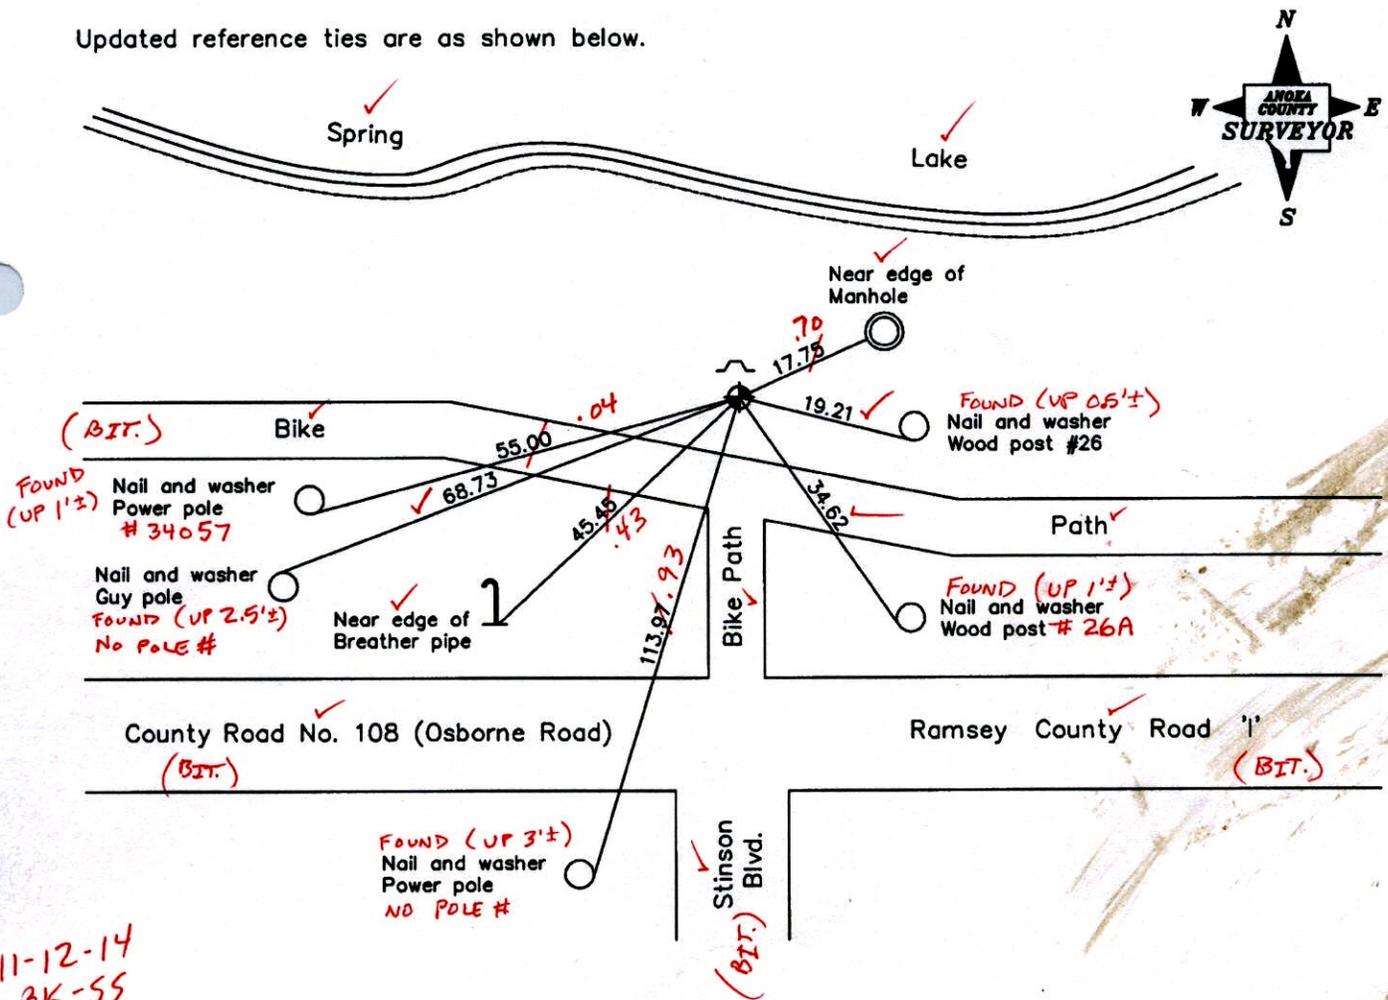

11-12-14
BK-55
TOTAL STA.

VRS.

Revised date	7/27/94
	2/18/99
	8/28/08

N.A.D. 1983 Coordinates (1996 Adjustment)	
County Project Coordinates	
Northing	126235.5761
Easting	510033.0107
Date	7/22/03

I hereby certify that this United States public land survey monument record is correct and complete to the best of my knowledge and belief.

Larry D. Hoium Date 11/06/08
 Larry D. Hoium, Anoka County Surveyor
 Minnesota License Number 18165

3DQ = 0.07 N = 126235.5888 E = 510032.9977

CERTIFICATE OF LOCATION OF GOVERNMENT CORNER

County of Anoka

State of Minnesota


Witness Corner of Sec. 12 Township 30 Range 24
(On east line of section)

On the 12th day of September, 1960, the described corner was evidenced by a granite monument

and to perpetuate the location of said corner, at the exact location thereof, a permanent marker was placed consisting of a cast iron monument with a sign and post on the north side

AND on the 28th day of August, 2008, said permanent marker was found and the ties were updated

Updated reference ties are as shown below.

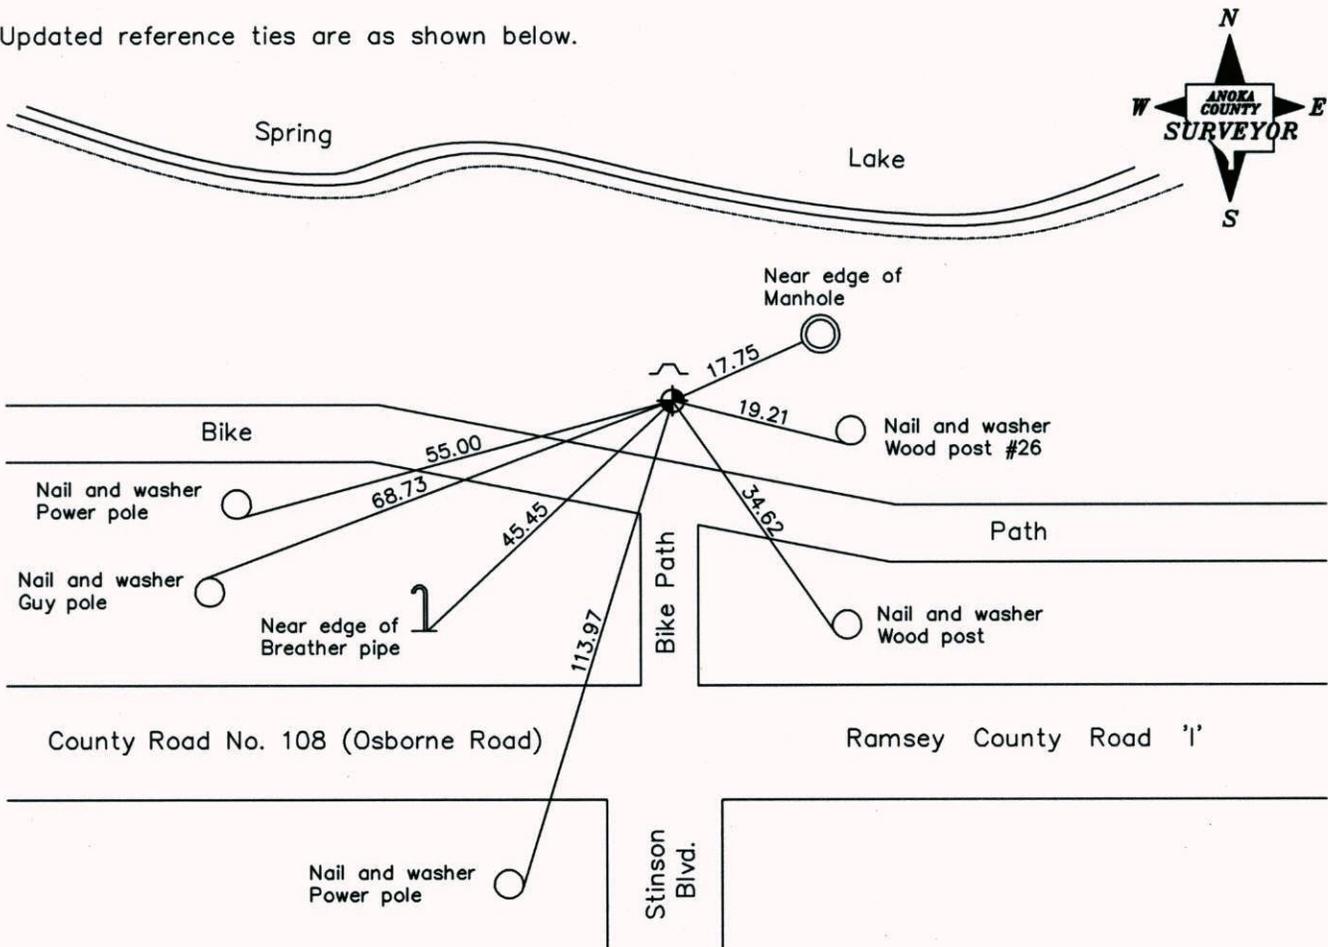

Revised date
7/27/94
2/18/99
8/28/08

N.A.D. 1983 Coordinates (1996 Adjustment)	
County Project Coordinates	
Northing	<u>126235.5761</u>
Easting	<u>510033.0107</u>
Date	<u>7/22/03</u>

I hereby certify that this United States public land survey monument record is correct and complete to the best of my knowledge and belief.

Larry D. Hoium Date 11/06/08
 _____, Anoka County Surveyor
 Minnesota License Number 18165

CERTIFICATE OF LOCATION OF GOVERNMENT CORNER

County of Anoka

State of Minnesota

WITNESS ON

EAST LINE Corner of Sec. 12 Township 30 Range 24

I hereby certify that on the 12TH day of SEPTEMBER, 19 60, I found the described corner which was evidenced by GRANITE MONUMENT

and I further certify that to perpetuate the location of said corner, I did, at the exact location thereof, place a permanent marker consisting of CAST IRON MONUMENT
SIGN & POST ON NORTH SIDE


which reference or witness monuments are located in the manner following:

S P R I N G
L A K E

N.A.D.	1983	Co-ordinates
County Project		Co-ordinates
Northing		<u>126235.5761</u>
Easting		<u>510033.0107</u>
State Plane Co-ordinates		
Y		
X		
Date <u>7/22/03</u>		

I hereby certify that this United States public land survey monument record is correct and complete to the best of my knowledge and belief.

Larry D. Hoium Date 11/6/08
LARRY D. HOIUM, Anoka County Surveyor
 Minnesota License Number 18165

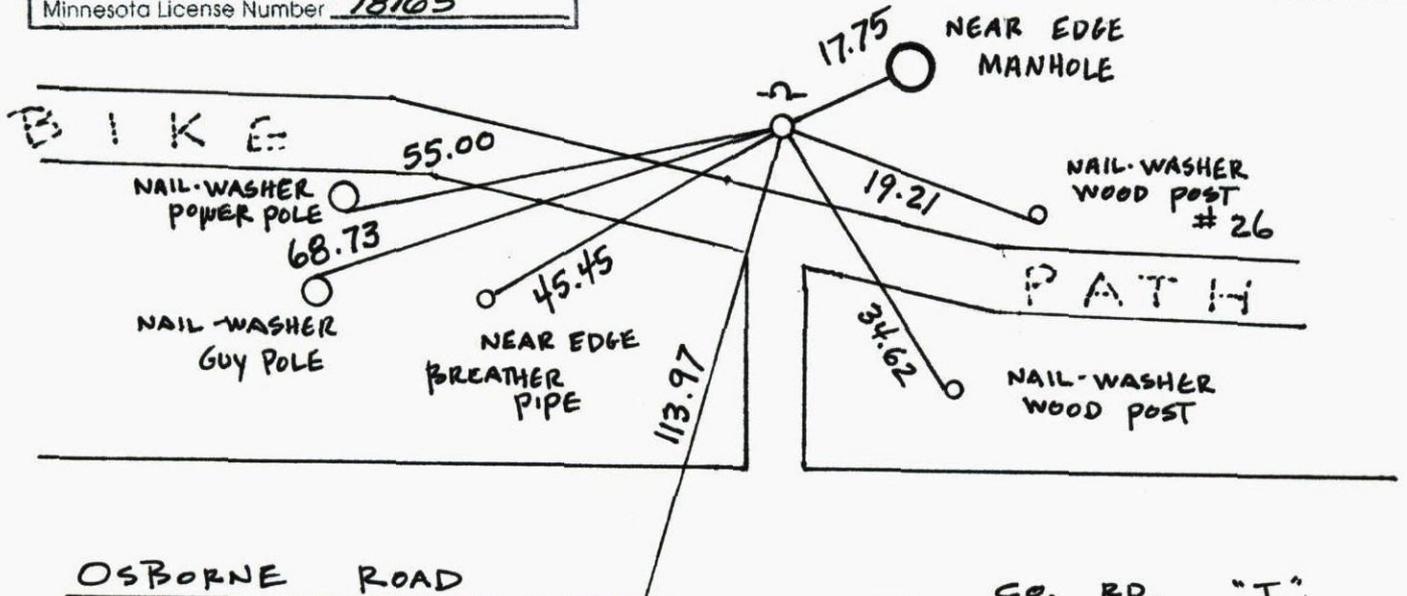

Revised date	Revised date	Revised date
<u>7-2-86</u>		
<u>7-3-89</u>		
<u>7-27-94</u>		
<u>2-18-99</u>		
<u>8-28-08</u>		

STINSON BLVD.

Done ✓

CERTIFICATE OF LOCATION OF GOVERNMENT CORNER

County of Anoka


State of Minnesota

WITNESS CORNER Corner of Sec. 12 Township 30 Range 24
ON EAST LINE

I hereby certify that on the 12TH day of SEPTEMBER, 1960, I found the described corner which was evidenced by GRANITE MONUMENT

and I further certify that to perpetuate the location of said corner, I did, at the exact location thereof, place a permanent marker consisting of CAST IRON MONUMENT


which reference or witness monuments are located in the manner following:

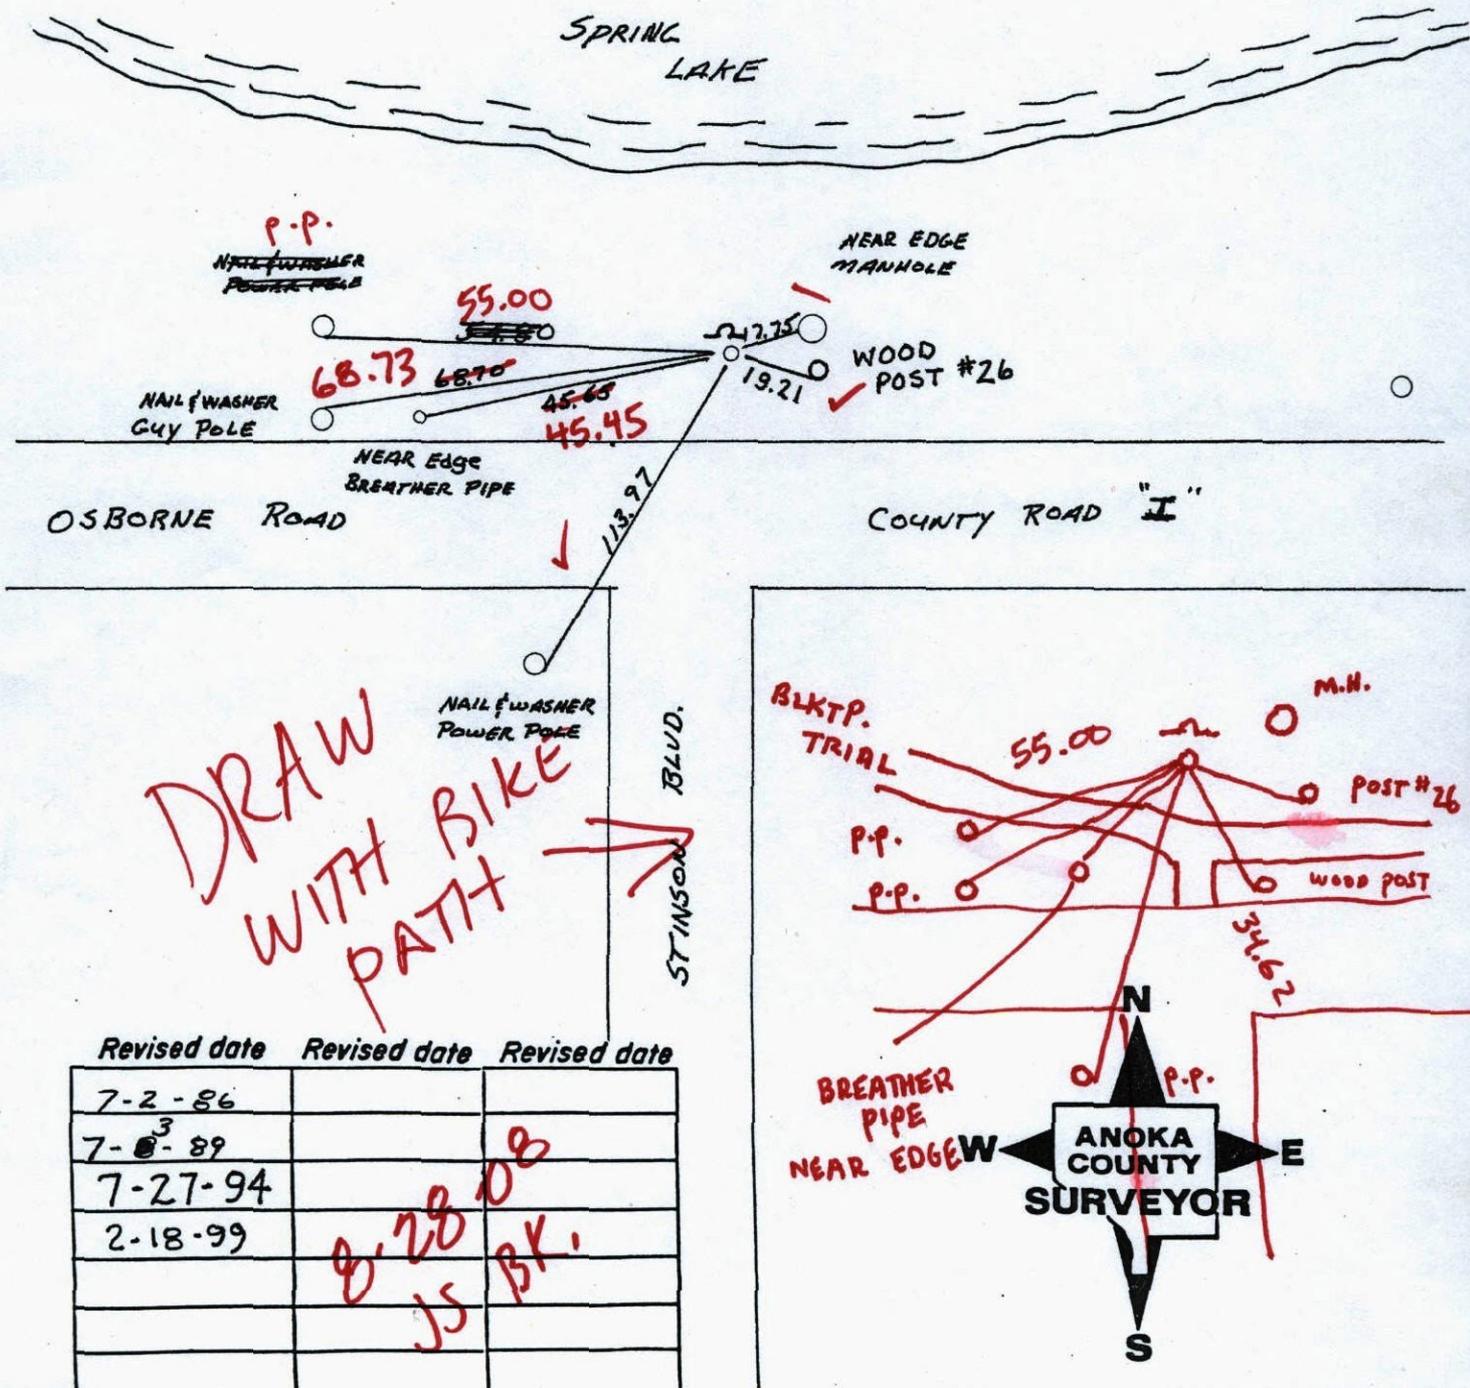

Revised date	Revised date	Revised date
7-2-86		
7- ³ 8-89		
7-27-94		
2-18-99	8-28-08	JS BK.

W.C on East line
 Sec. 12 T.30 R.24
 Retie Cast Iron Mon.

SPRING LAKE

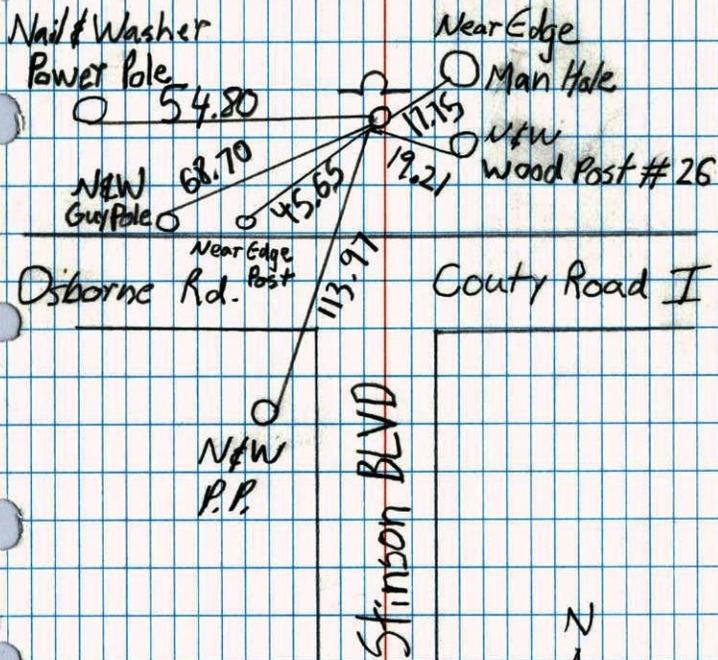


Jay Mc
 Josh Anderson

WITNESS CORNER ON THE EAST LINE OF
 SEC 12 T30 R24

RETIED CAST IRON MONUMENT, SIGN
 AND POST ON THE NORTH SIDE.

SPRING LAKE

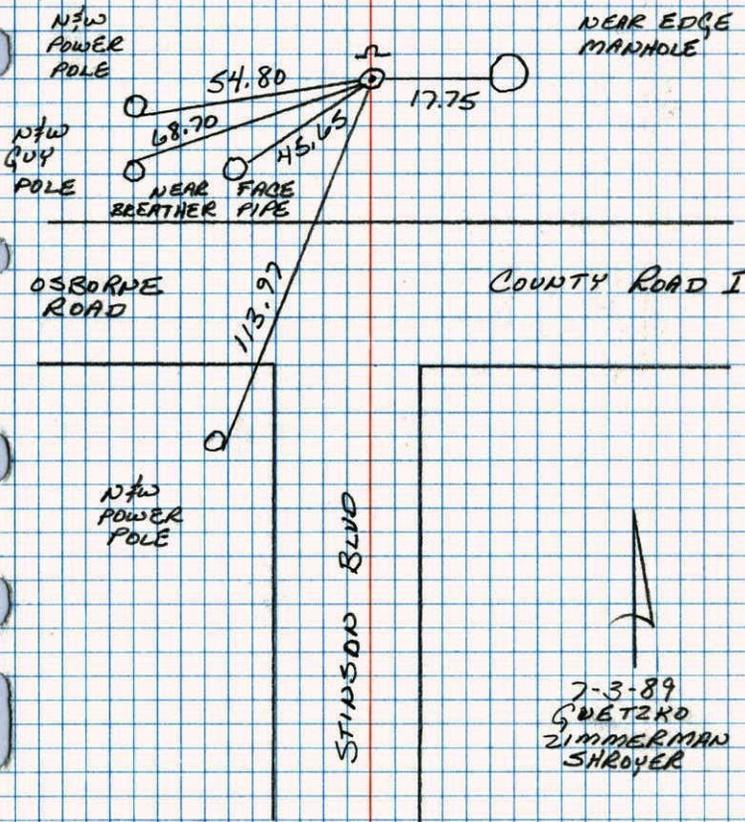

7-3-89
 GUBETZKO
 ZIMMERMAN
 SHROYER

W.C. COR on E line of Sec 12-T30-R24
On So. Side of Lake


Broken off Granite Mon

replaced leaning granite with cast Iron
set by ties (down .5')

June 25, 1974

R Farmer
N Dahl

Spring Lake

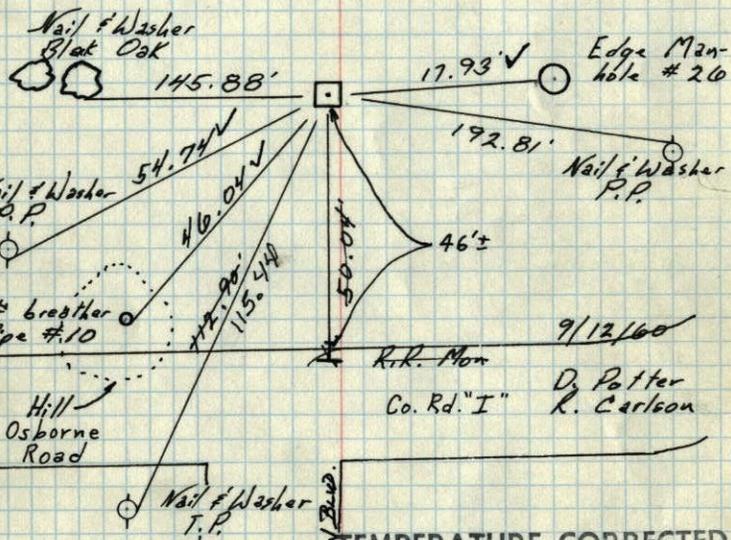

TEMPERATURE CORRECTED
AND HORIZONTALLY
TAPED MEASUREMENTS

Tie Check
July 5, 1966
H. Larson
D. Potter

Tie Check
Aug 17, 1970
R. Brien
B. Olson

TIE CHECK
7-14-80
B. STEPHENS
P. ROSS
P. HORNBY
J. STEPHENS


ROLAND W. ANDERSON
COUNTY SURVEYOR
ANOKA COUNTY, MINNESOTA

W.C. COR on E line of Sec 12-T30-R24
On So. Side of Lake

Broken off Granite Mon

Retied
May 11, 1964 (All ties good)
M.D.A.
Spring Lake

Check closely with
Cartwrights Tie

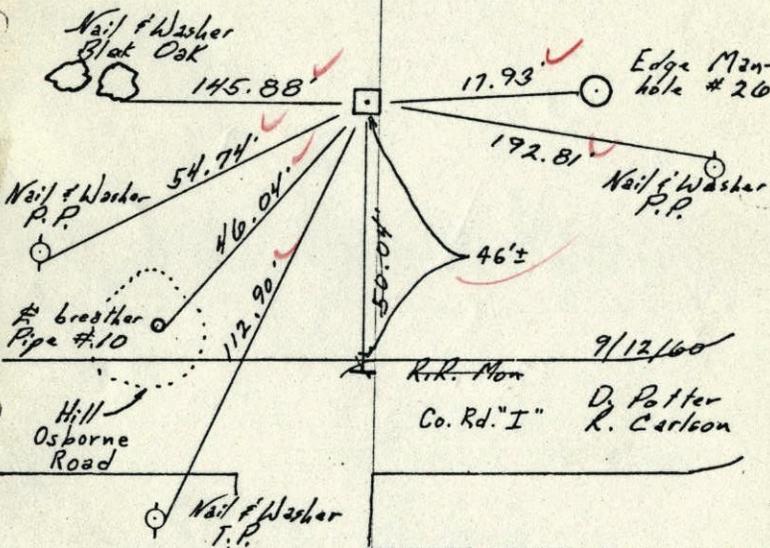


TEMPERATURE CORRECTED
AND HORIZONTALLY
TAPED MEASUREMENTS

Tie Check
July 5, 1966
H. Larson
D. Potter

Tie Check
August 17, 1970
R. Brien
B. Olson

ROLAND W. ANDERSON
COUNTY SURVEYOR
ANOKA COUNTY, MINNESOTA


1960
 W.C. on E. line of Sec. 12, T30, R24
 on So. Side of Lake
 broken off Granite
 up .5'

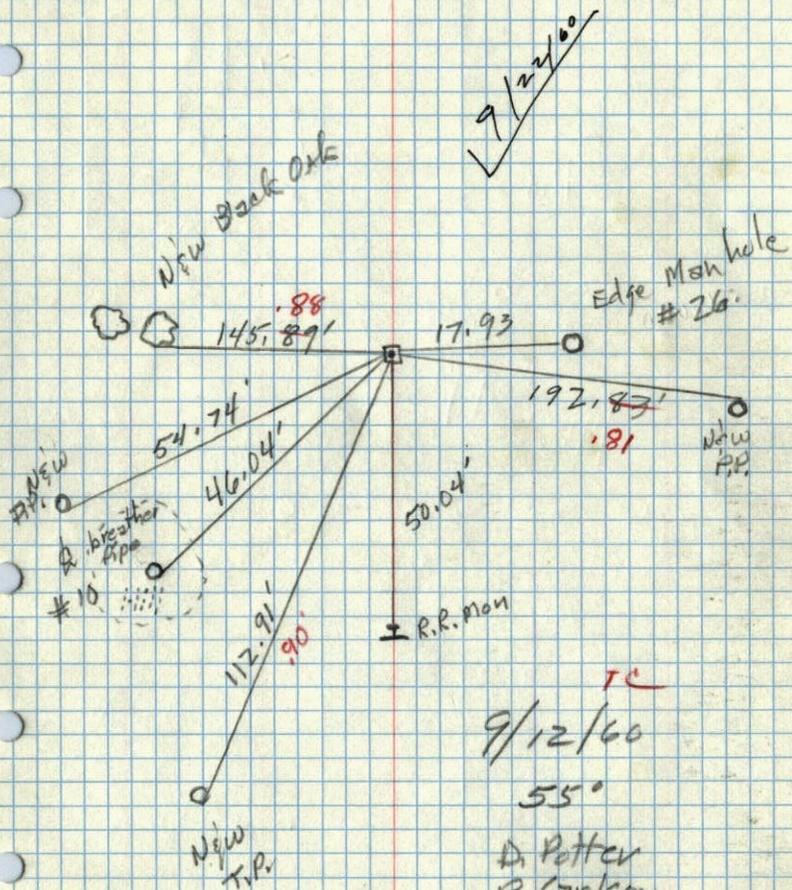

TC
 9/12/60
 55°
 D. Potter
 R. Carlson

20A

M.C. ON S-Side Wood LAKE ON E. Side of
 Sec. 12, Twp 30 N, R 24 W
 GRANITE

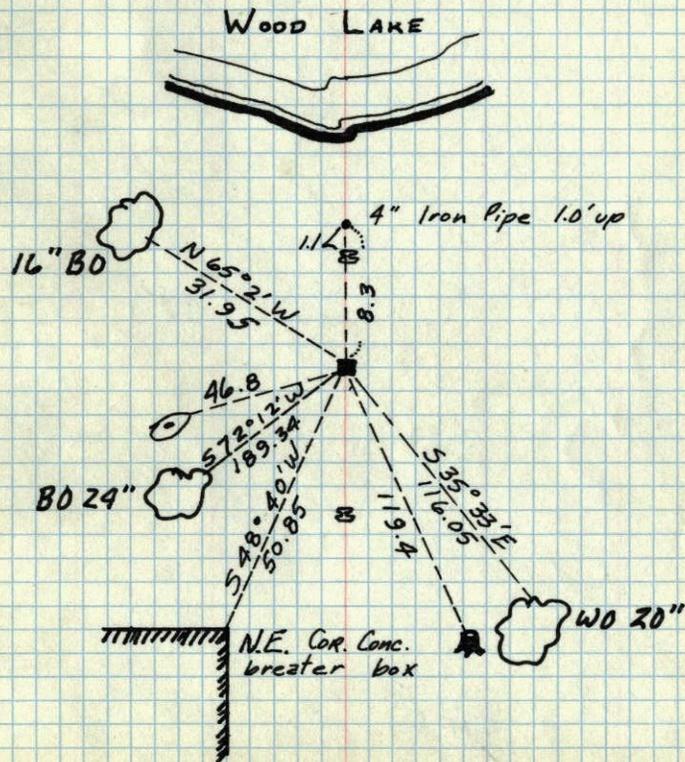


N.C. Hoium
 April 10, 1943
 Harvey A.
 CARTWRIGHT

1943 18 ✓


M.C. on S side Woodlake on E. side of Sec 12 T30R24

Granite 8" x 8" flush

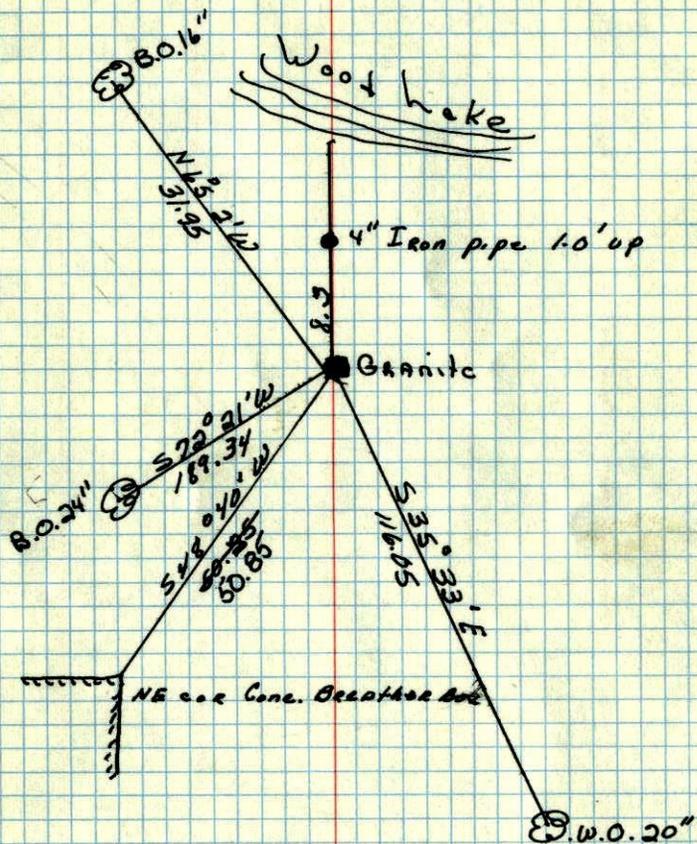


April 10, 1943.
Harvey A. Cartwright

M.C. E - Sec 12, T30, R24 ✓

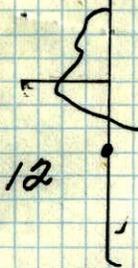

letie

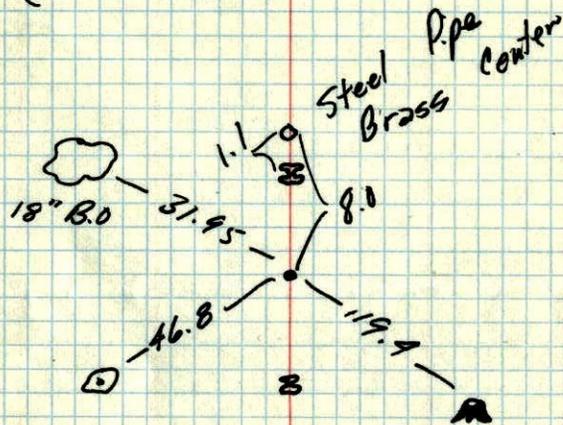

Boivin