CERTIFICATE OF LOCATION OF GOVERNMENT CORNER

County of Anoka State of Minnesota

Northwest Corner of Sec. 13 Township 30 Range 24

On the 10th day of February, 1960, the described corner was evidenced by granite moument

and to perpetuate the location of said corner, at the exact location thereof, a permanent marker was placed consisting of the granite monument with a sign on the corner fence post (DOWN 0.5'±)

AND on the 20th day of November, 2008, said permanent marker was moved to a position that was used to locate adjoining plats and agrees with area resurvey

Updated reference ties are as shown below.

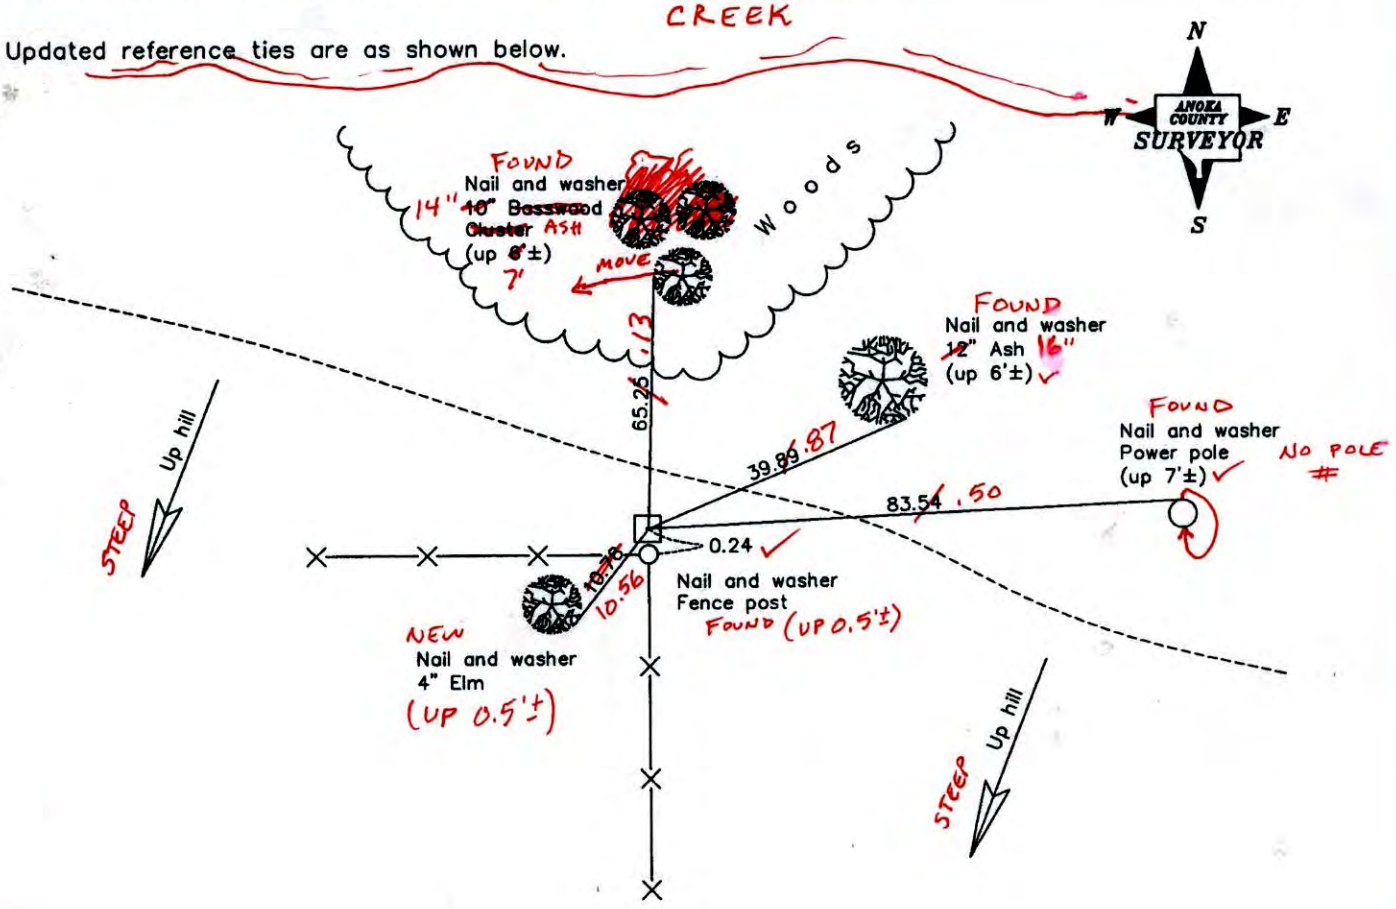

11-7-14
BK-55
TAPED

Revised date HSE # 851

8/05/94
3/02/05
11/20/08

N.A.D. 1983 Coordinates (1996 Adjustment)

County Project Coordinates	
Northing	121188.8420
Easting	504704.8253
Date	11/20/08

HSE # 861

I hereby certify that this United States public land survey monument record is correct and complete to the best of my knowledge and belief.

Date 11/21/08

Larry D. Hoium, Anoka County Surveyor

Minnesota License Number 18165

CERTIFICATE OF LOCATION OF GOVERNMENT CORNER

County of Anoka State of Minnesota

Northwest Corner of Sec. 13 Township 30 Range 24

On the 10th day of February, 1960, the described corner was evidenced by granite moument

and to perpetuate the location of said corner, at the exact location thereof, a permanent marker was placed consisting of the granite monument with a sign on the corner fence post

AND on the 20th day of November, 2008, said permanent marker was moved to a position that was used to locate adjoining plats and agrees with area resurvey

Updated reference ties are as shown below.

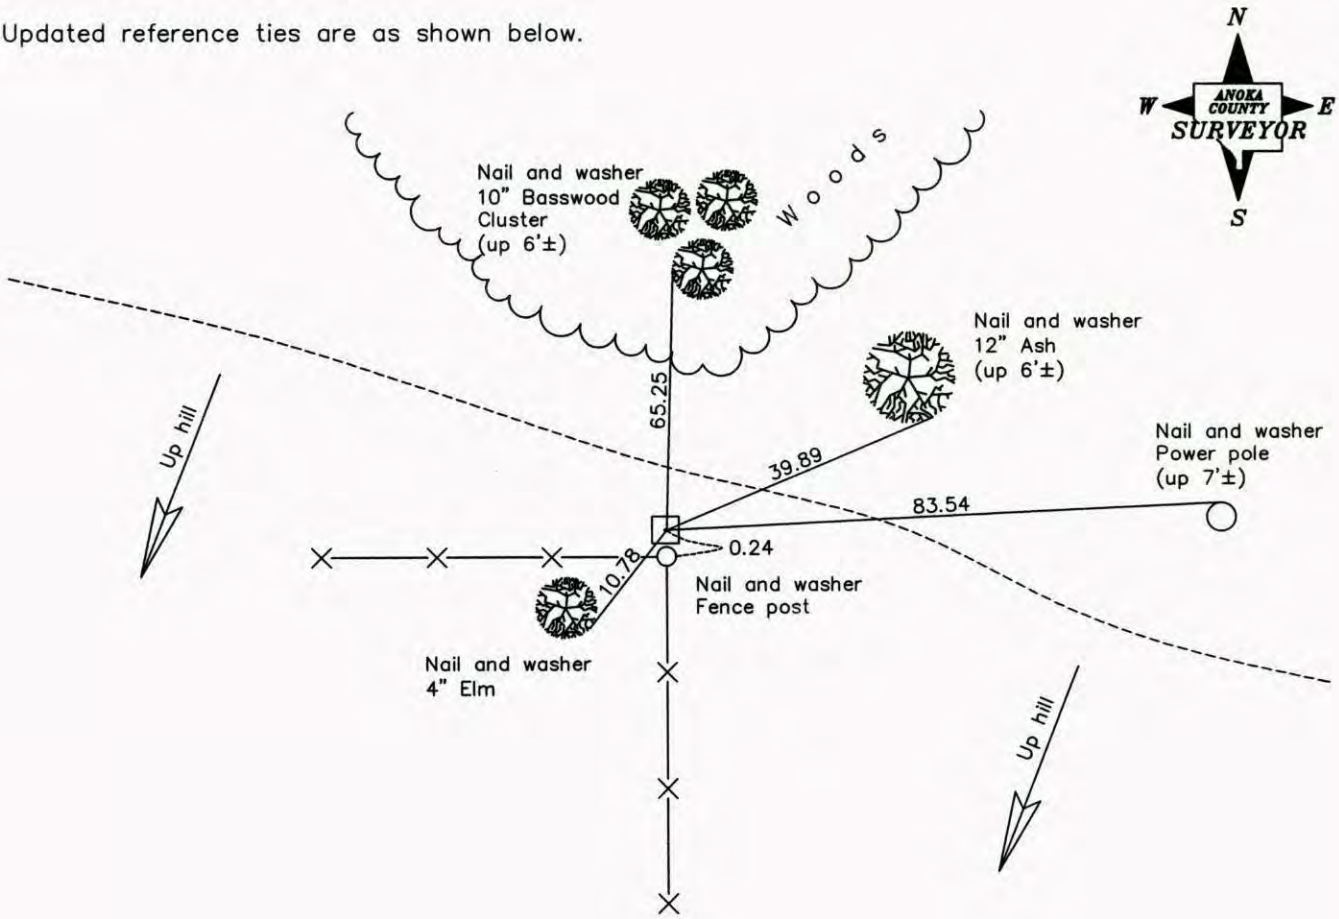

Revised date
8/05/94
3/02/05
11/20/08

N.A.D. 1983 Coordinates
(1996 Adjustment)

County Project Coordinates	
Northing	121188.8420
Easting	504704.8253
Date	11/20/08

I hereby certify that this United States public land survey monument record is correct and complete to the best of my knowledge and belief.

Date 11/21/08

Larry D. Hoium, Anoka County Surveyor

Minnesota License Number 18165

Page No. 29

CERTIFICATE OF LOCATION OF GOVERNMENT CORNER

County of Anoka State of Minnesota

NORTHWEST Corner of Sec. 13 Township 30 Range 24

I hereby certify that on the 10 day of FEB., 1960, I found the described corner which was evidenced by GRANITE MON.

and I further certify that to perpetuate the location of said corner, I did, at the exact location thereof, place a permanent marker consisting of GRANITE MON. SIGN ON COR. FENCE POST MOVED MON W + N.

which reference or witness monuments are located in the manner following:

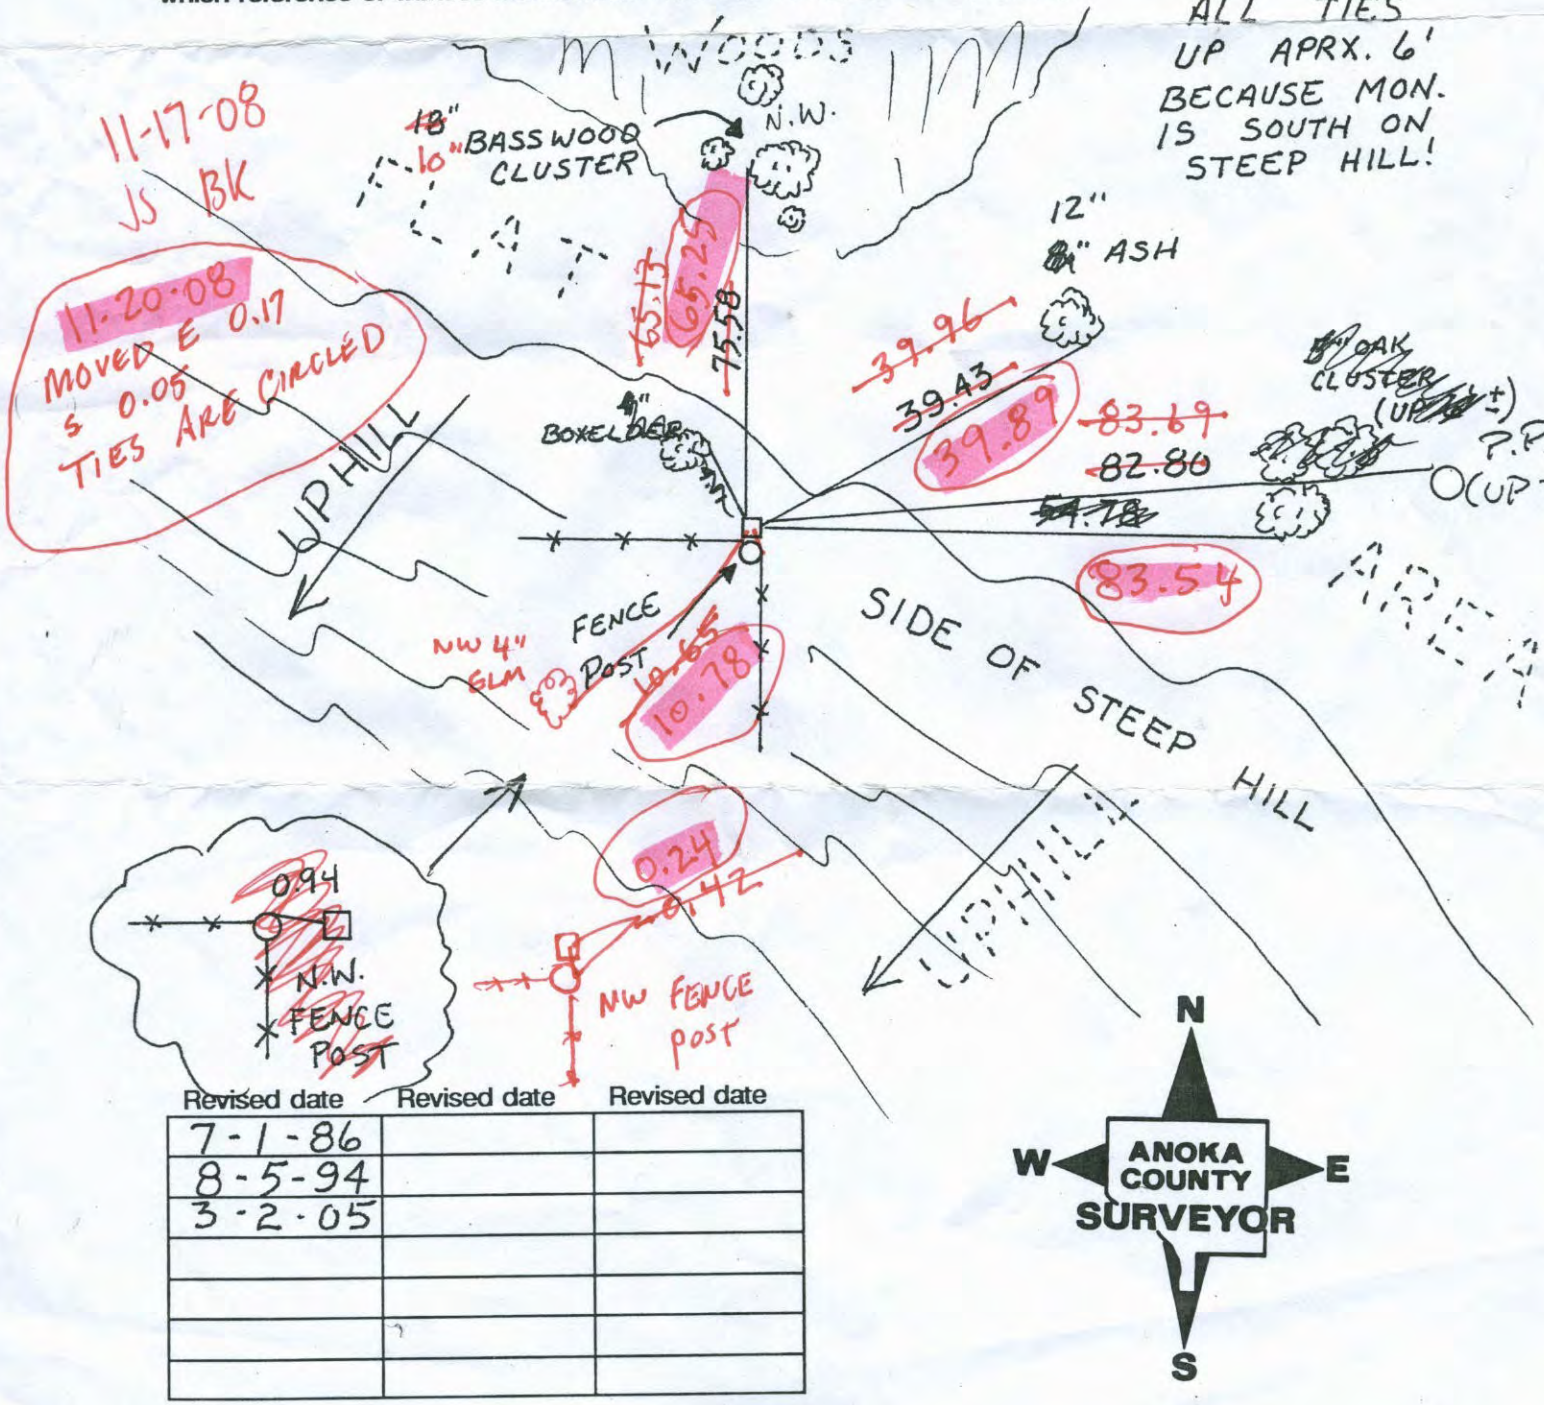

Revised date	Revised date	Revised date
7-1-86		
8-5-94		
3-2-05		

NW CORNER SECTION 13 T30R24

FOUND AND STRAGATENED GRANITE MON. RETIED. PUT SIGN ON COR. FENCE POST. GRANITE DOWN 1' ±

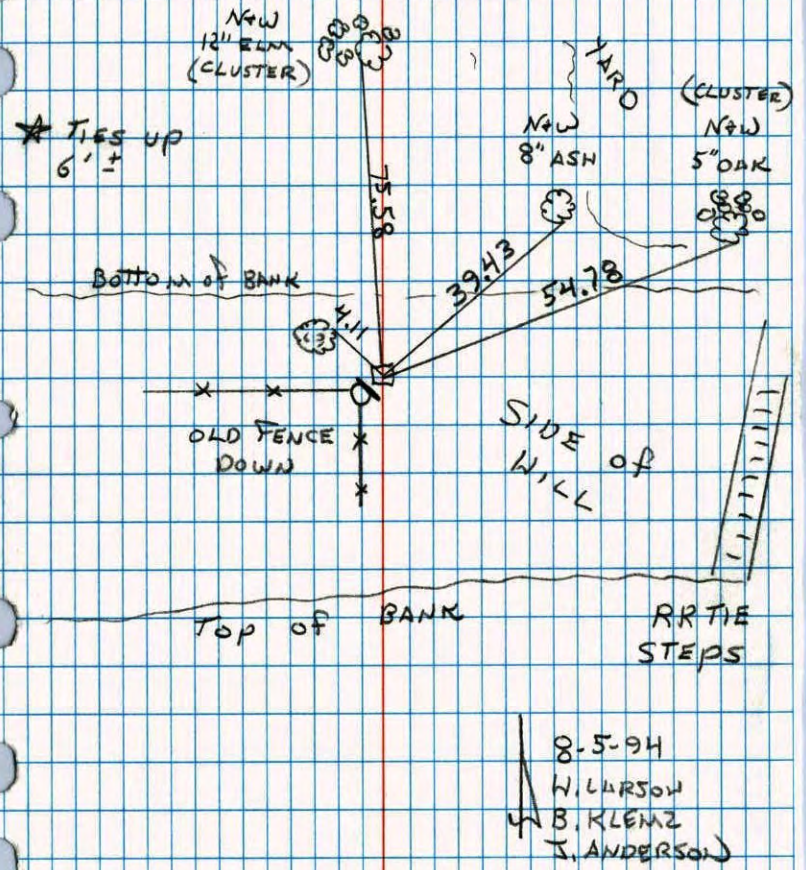

8-5-94
W. LARSON
B. KLEMZ
I. ANDERSON

NORTHWEST CORNER SEC. 13 T30 R24

RETIED GRANITE MONUMENT LEANING WEST.

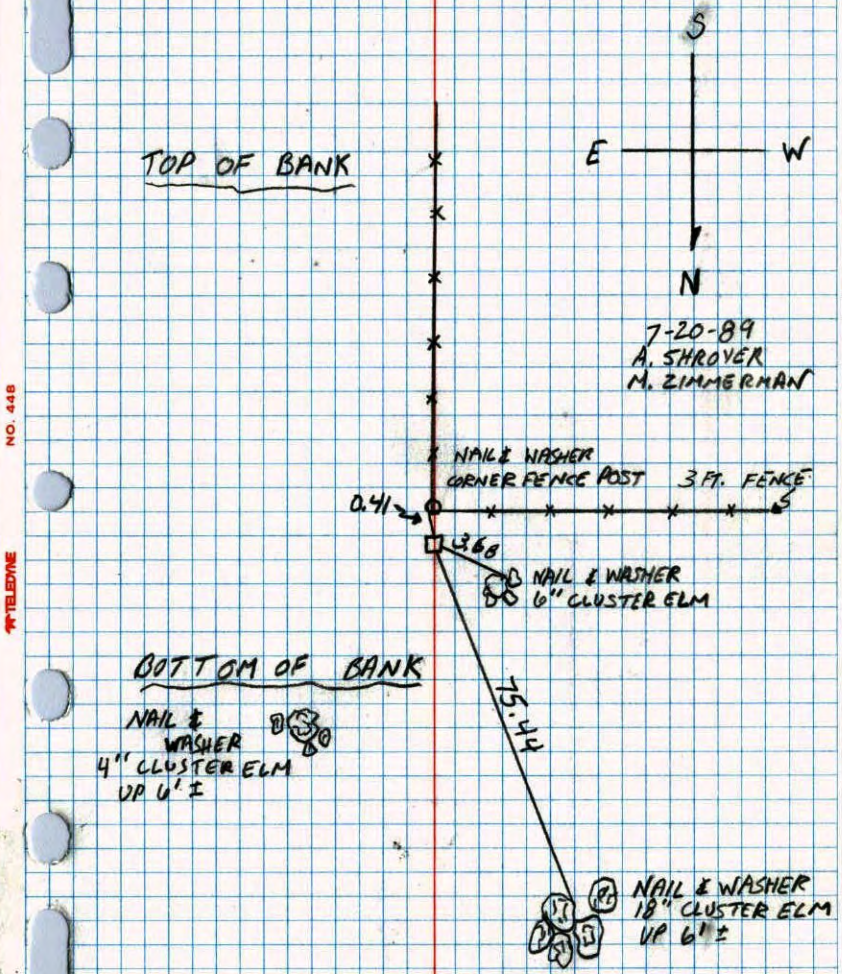

Northwest Corner of Section 13, Twsp. 30, Rge. 24
Granite Down 1½' Leaning NW

TEMPERATURE CORRECTED AND HORIZONTALLY TAPED MEASUREMENTS

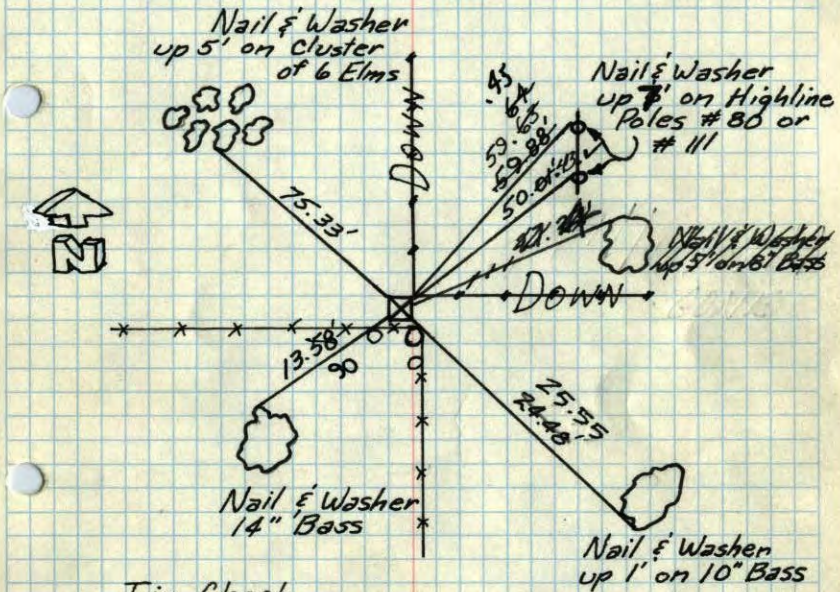

Tie Check
July 5, 1966
H. Larson
D. Potter

Tie Check
Aug 17 1970
R. Brien
B. Olson

Tie Check
June 19, 1974
R Farmer
N Dahl
D Dahl

TIE CHECK
July 29, 1977
R. SQUNTERUP
B. BRIEN
J. STEPHENS

TIE CHECK
7-22-80
B. STEPHENS
P. ROSS
P. HORNBY

Ties checked
June 3, 1964
M.O.A. ~ R.C.

Feb. 10, 1960
H. J. McLaughlin Assist.

ROLAND W. ANDERSON
COUNTY SURVEYOR
ANOKA COUNTY, MINNESOTA

29

Northwest Corner of Section 13, Twsp. 30, Rge. 24
Granite Down 1½' Leaning NW

TEMPERATURE CORRECTED AND HORIZONTALLY TAPED MEASUREMENTS

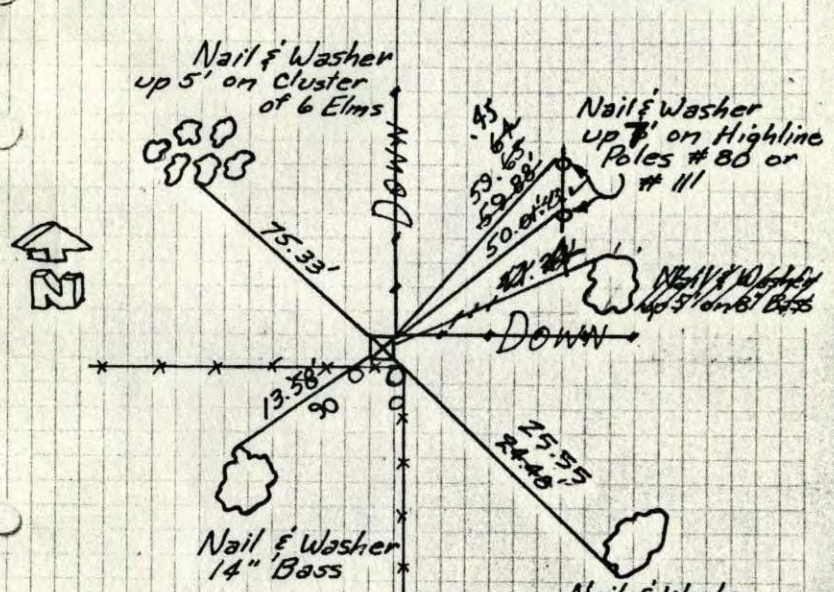

Tie Check
July 5, 1966
H. Larson
D. Potter

Tie Check
Aug 17 1970
R. Brien
B. Olson

Tie Check
June 19, 1974
R Farmer
N Dahl
D Dahl

TIE CHECK
July 29, 1977
R. SQUNTERUP
B. BRIEN
J. STEPHENS

TIE CHECK
7-22-80
B. STEPHENS
P. ROSS
P. HORNBY

Ties checked
June 3, 1964
M.O.A. ~ R.C.

Feb. 10, 1960
H. J. McLaughlin Assist.

ROLAND W. ANDERSON
COUNTY SURVEYOR
ANOKA COUNTY, MINNESOTA

1970 27

Northwest Corner of Section 13, Twsp. 30, Rge. 24
Granite Down 1½' Leaning NW

TEMPERATURE CORRECTED
AND HORIZONTALLY
TAPED MEASUREMENTS

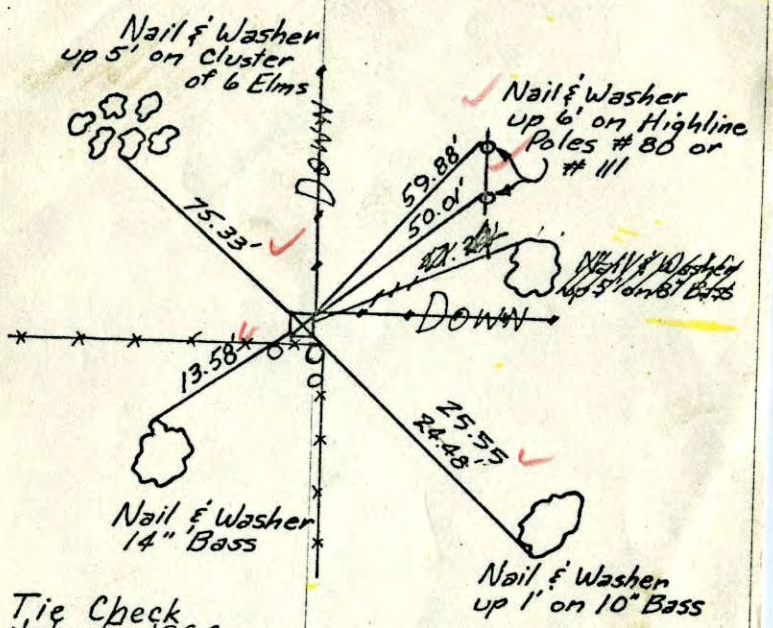

Tie Check
July 5, 1966
H. Larson
D. Potter

Tie Check
Aug 17, 1970
R. Brier
B. Olson

Ties checked
June 3, 1964
M.D.A. ~ R.C.

Feb. 10, 1960
H. J. McLaughlin Assist.

ROLAND W. ANDERSON
COUNTY SURVEYOR
ANOKA COUNTY, MINNESOTA

1964

Northwest Corner of Section 13, Twsp. 30, Rge.
Granite Down 1½' Leaning NW
2½'

Retied
June 3, 1964
M.D.A.
R.C.
69°
#3

TEMPERATURE CORRECTI
AND HORIZONTALLY
TAPED MEASUREMENTS

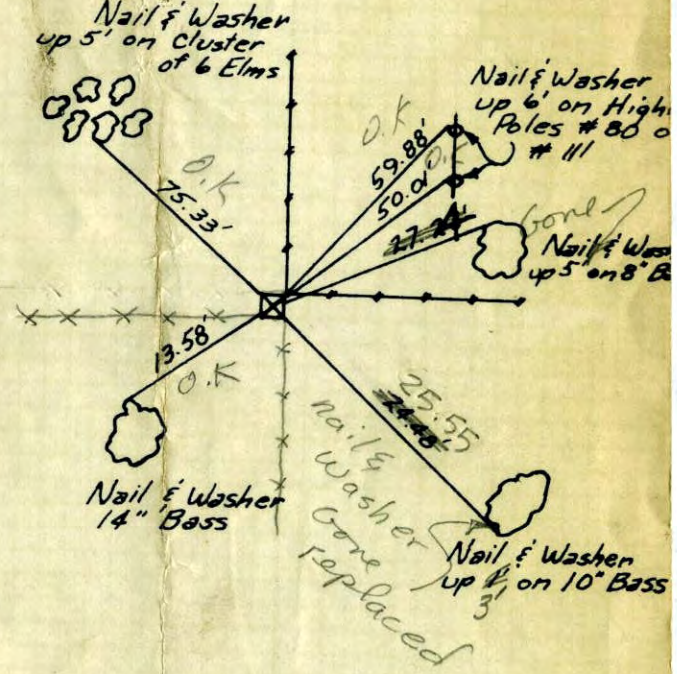

Feb. 10, 1960
H. J. McLaughlin Assist

ROLAND W. ANDERSON
COUNTY SURVEYOR
ANOKA COUNTY, MINNESOTA

1943 23

NW corner of Sec 13 T. 30 N R. 24 W
Granite 8"x8" down 4.0'

Re-tied By
W. J. Lundstrom
4-30-55

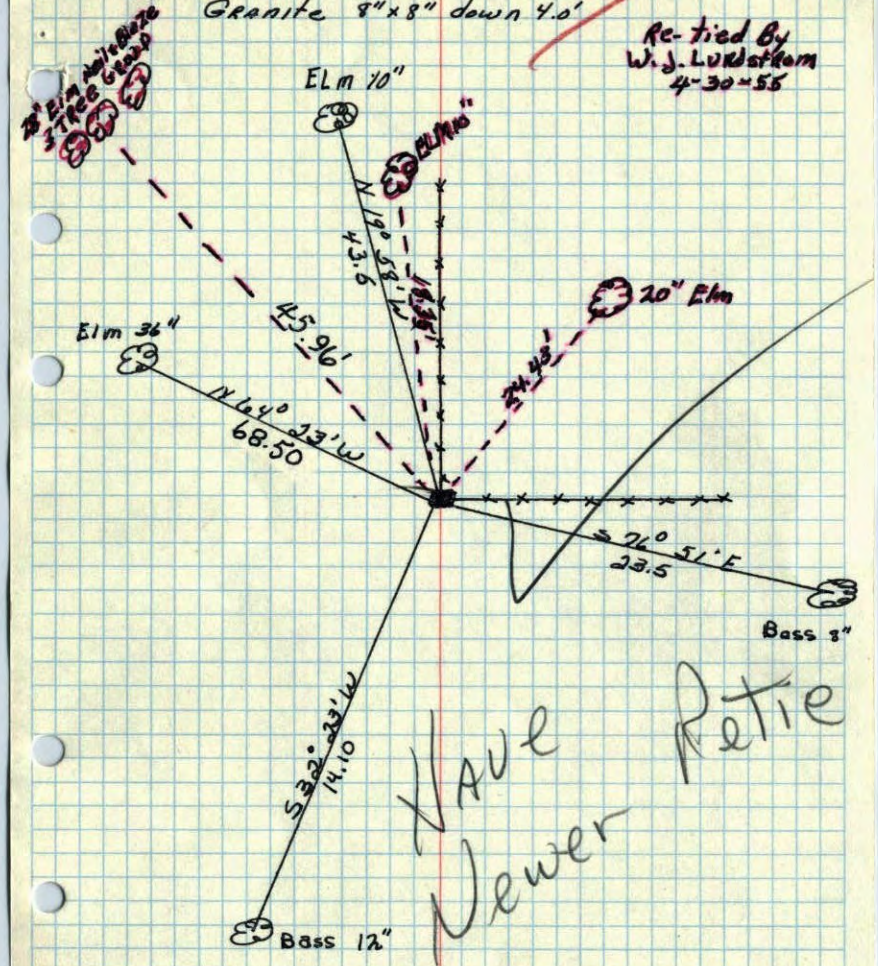

Wave Retie
Newer

April 10, 1943
Harvey A. Cartwright

NO DATE

NW Corn. Sec. 13, 30-24

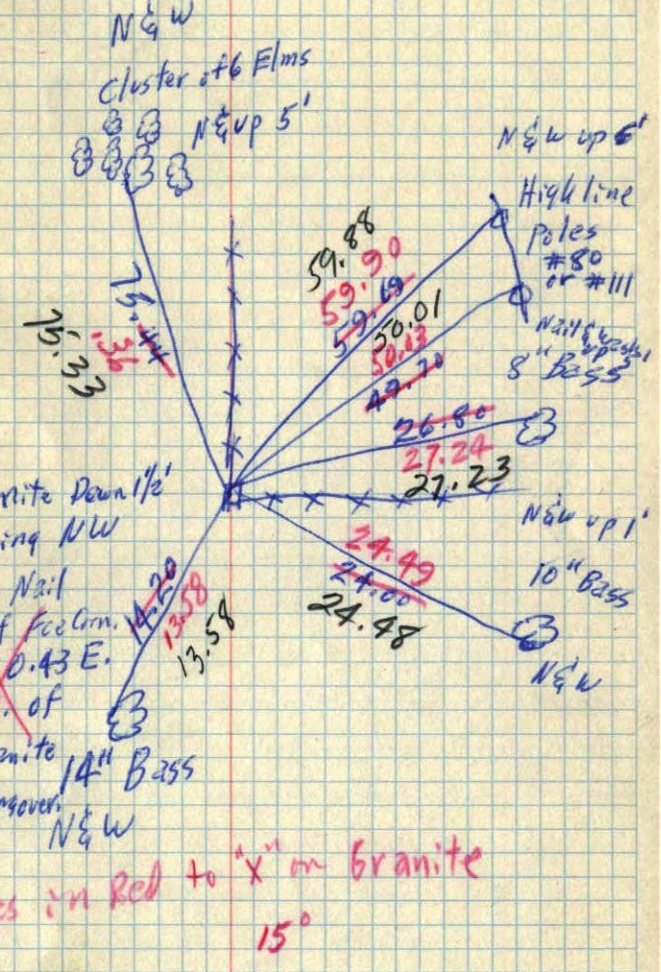

Ties in Red to "X" on Granite
15°

1993

NW corner of Sec 13 T. 30 N R. 24 W
Granite 8" x 8" down 4.5'

Re-tied By

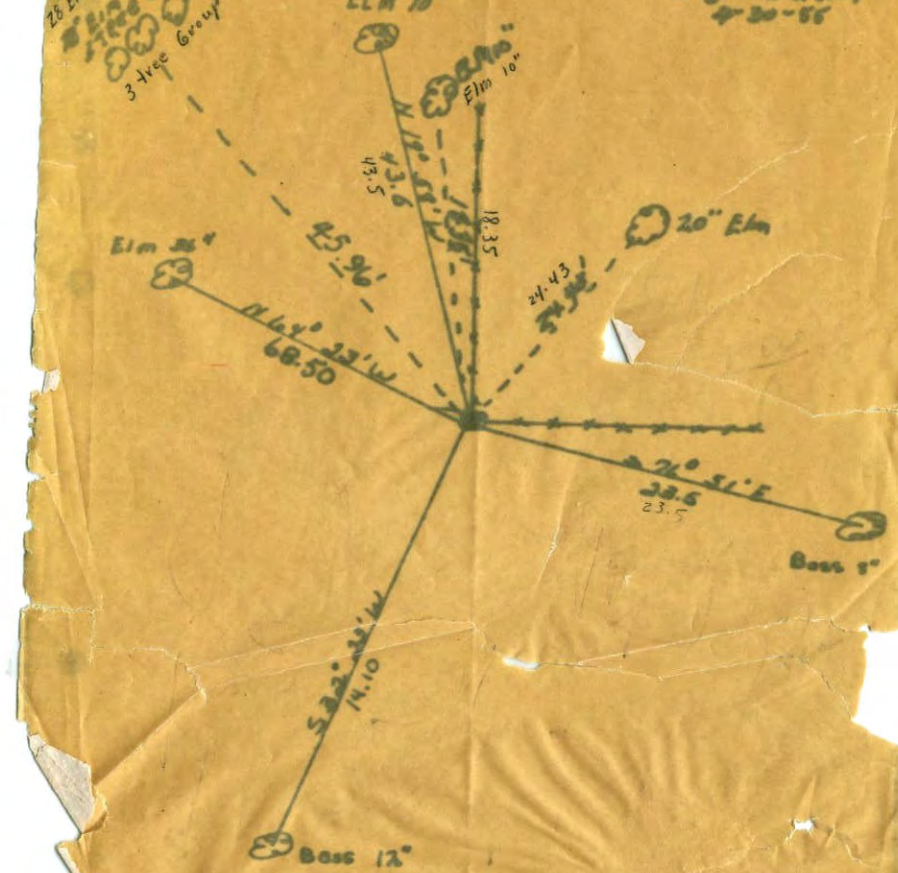

