

CERTIFICATE OF LOCATION OF GOVERNMENT CORNER

County of Anoka

State of Minnesota


Meander Corner of Sec. 1 Township 30 Range 24
(on west side of Laddie Lake)

On the 27th day of June, 1960, the described corner was evidenced by a concrete monument

and to perpetuate the location of said corner, at the exact location thereof, a permanent marker was placed consisting of a cast iron monument with a sign and post on the south side

AND on the 18th day of August, 2008, said permanent marker was found and the ties were updated

Updated reference ties are as shown below.

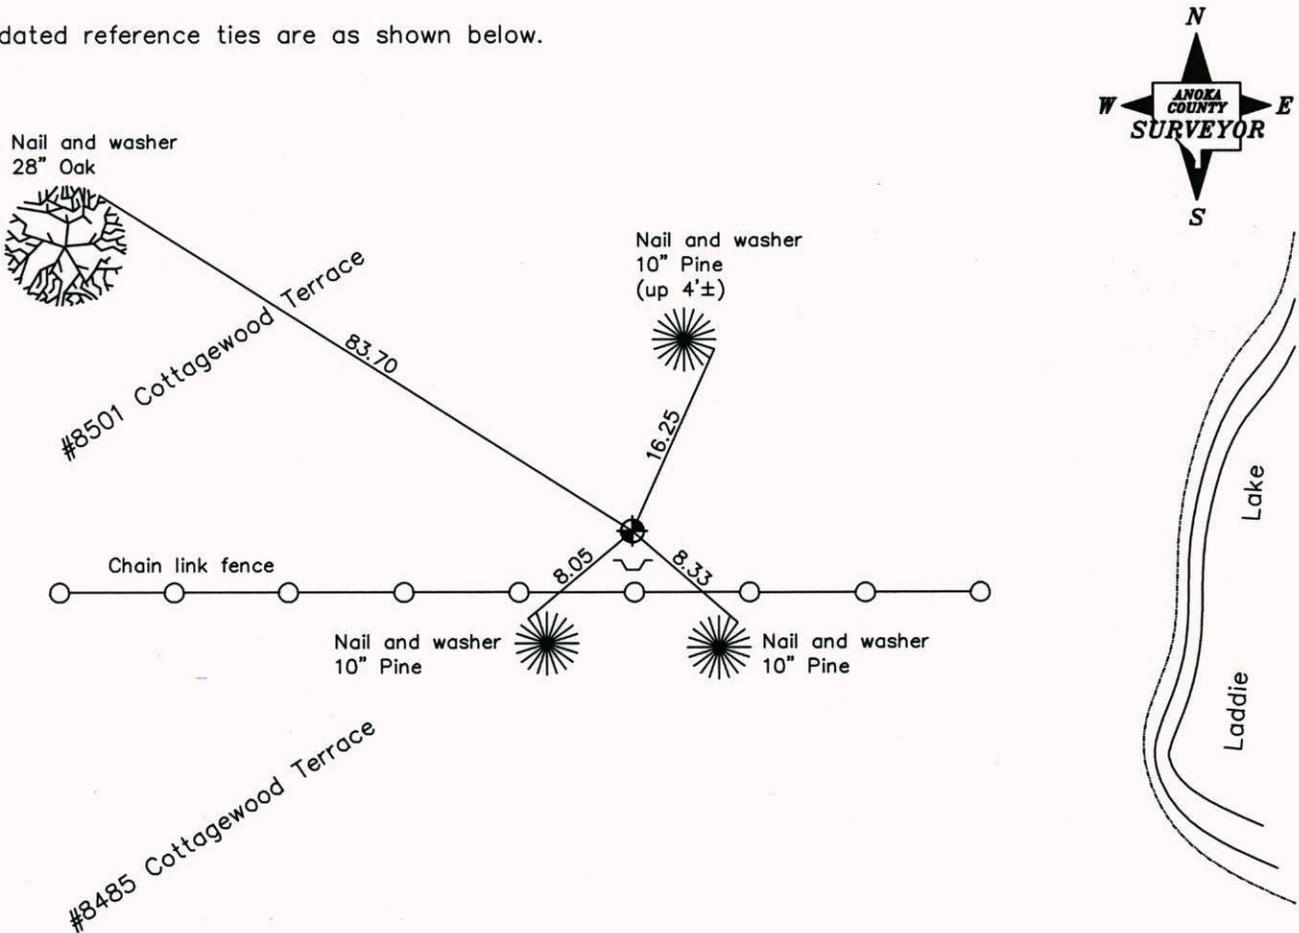

Revised date
8/02/94
2/02/00
8/18/08

N.A.D. 1983 Coordinates (1996 Adjustment)	
County Project Coordinates	
Northing	132550.2298
Easting	505946.4223
Date	N/A

I hereby certify that this United States public land survey monument record is correct and complete to the best of my knowledge and belief.

Date 11/06/08
 _____, Anoka County Surveyor
 Minnesota License Number 18165

CERTIFICATE OF LOCATION OF GOVERNMENT CORNER

County of Anoka State of Minnesota

MEANDER COR.
 WEST SIDE Corner of Sec. 1 Township 30 Range 24
LADDIE LAKE


I hereby certify that on the 27 day of JUNE, 1960, I found the described corner which was evidenced by CONCRETE MONUMENT

and I further certify that to perpetuate the location of said corner, I did, at the exact location thereof, place a permanent marker consisting of CAST IRON MONT.
SIGN & POST ON SOUTH SIDE

which reference or witness monuments are located in the manner following:

N.A.D.	1983	Co-ordinates
County	Project	Co-ordinates
Northing	<u>132550.2298</u>	
Easting	<u>505946.4223</u>	
State Plane Co-ordinates		
Y	_____	
X	_____	
Date _____		


#8501
COTTAGE WOOD
TERRACE

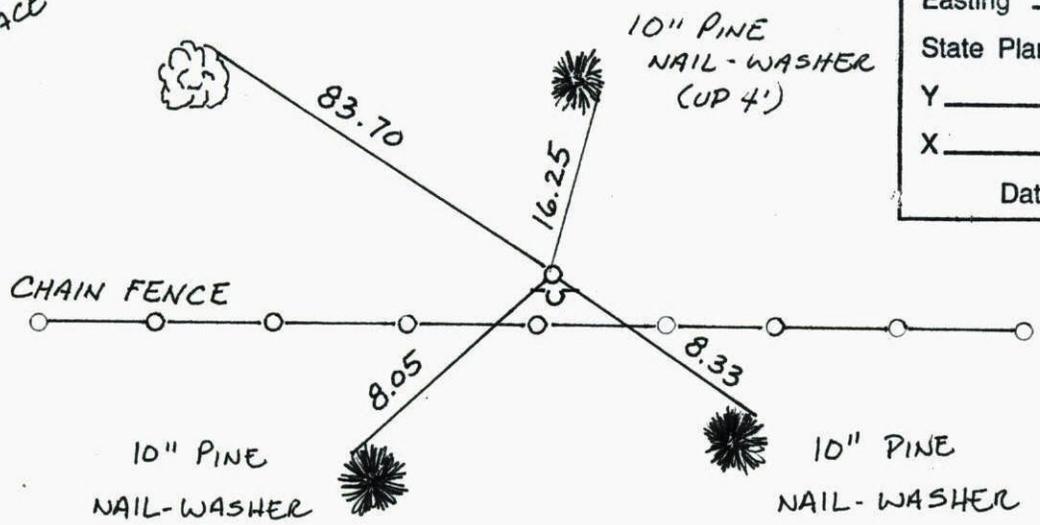

#8485

I hereby certify that this United States public land survey monument record is correct and complete to the best of my knowledge and belief.
Larry D. Hoium Date 11/6/68
LARRY D. HOIUM, Anoka County Surveyor
 Minnesota License Number 18165

Revised date	Revised date	Revised date
1-10-89		
7-13-89		
8-2-94		
2-2-00		
8-18-08		

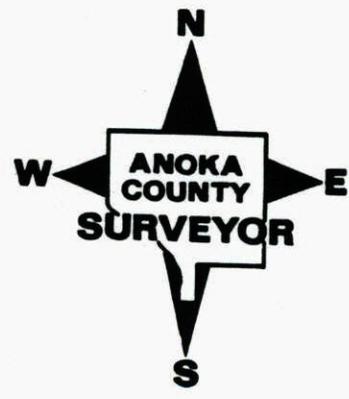

CERTIFICATE OF LOCATION OF GOVERNMENT CORNER

County of Anoka


State of Minnesota

MEANDER COR.
WEST SIDE LADDIE LAKE
Corner of Sec. 1 Township 30 Range 24


I hereby certify that on the 27TH day of JUNE, 1960, I found the described corner which was evidenced by CONCRETE MONUMENT

and I further certify that to perpetuate the location of said corner, I did, at the exact location thereof, place a permanent marker consisting of CAST IRON MONUMENT
SIGN & POST ON SOUTH SIDE

which reference or witness monuments are located in the manner following:

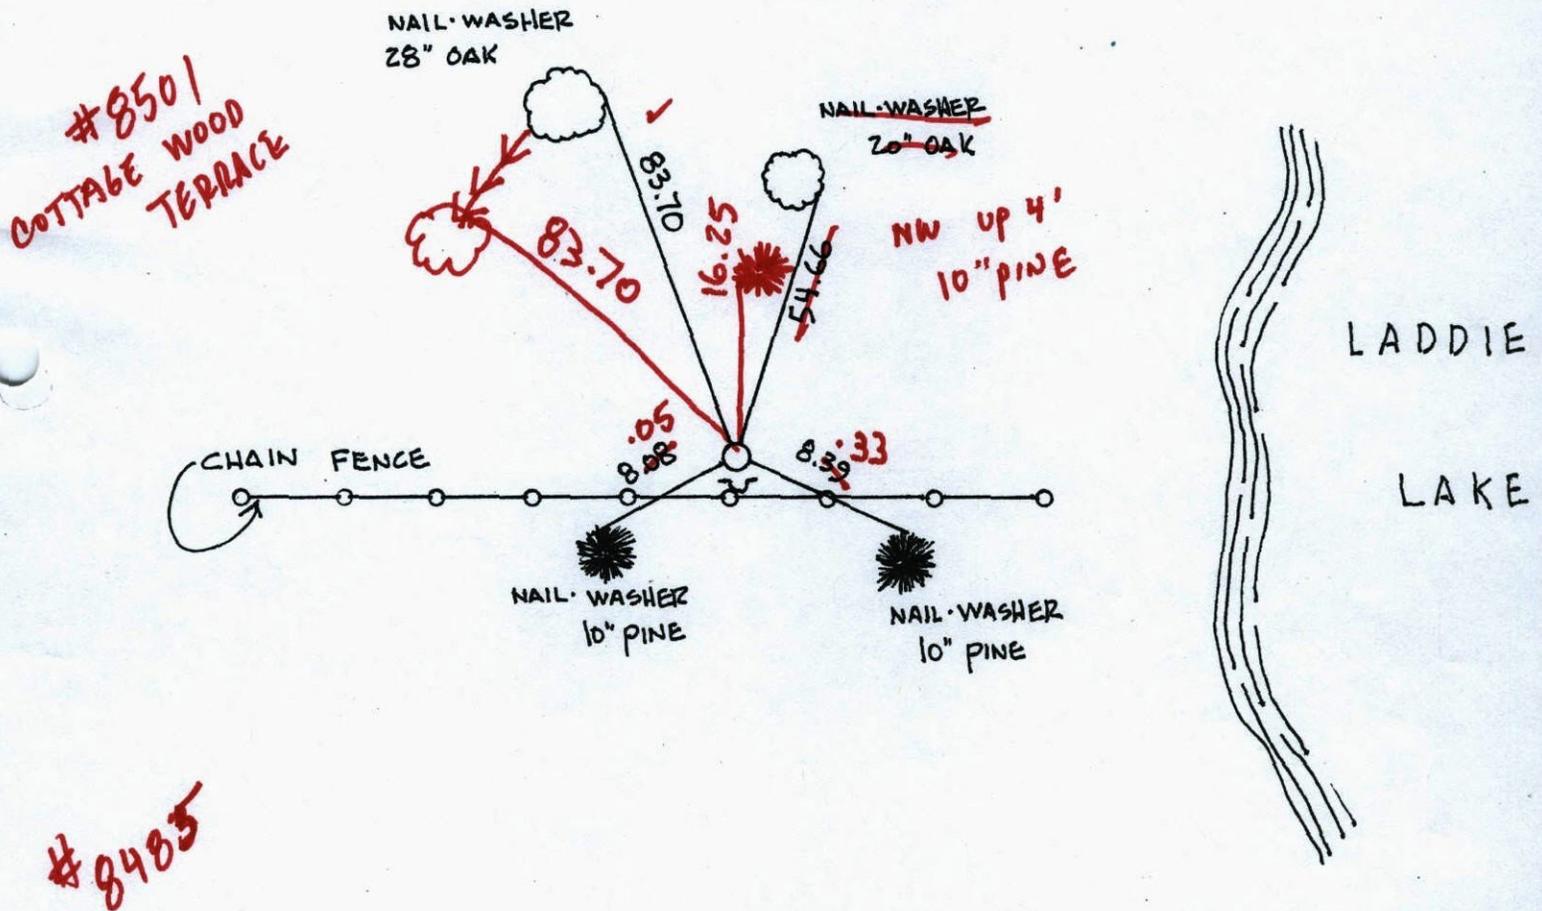


Revised date	Revised date	Revised date
1.10.89		
7.13.89		
8.2.94		
2.2.00		

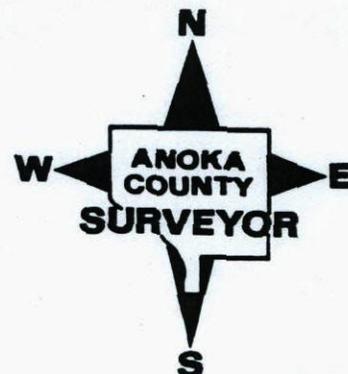

MEANDOR COR.

SEC 1 T 30 R 24

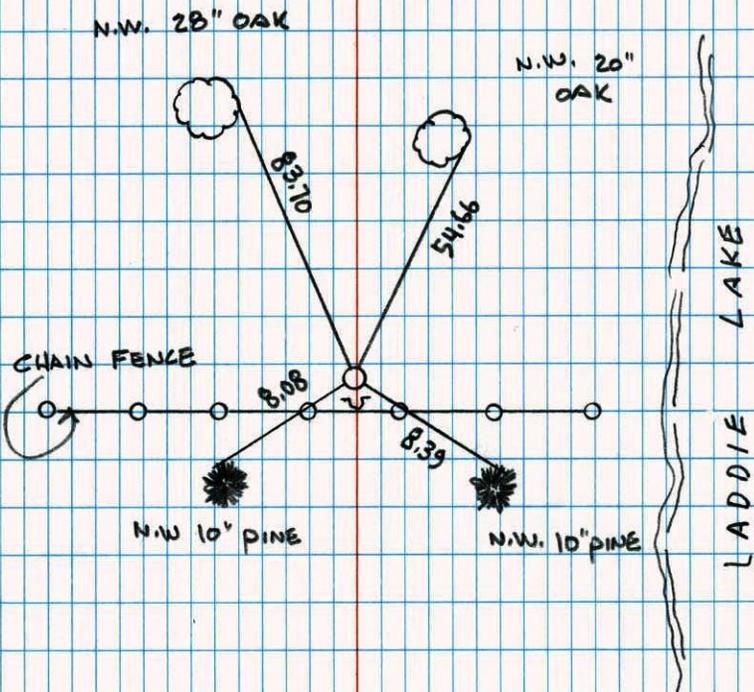W. SIDE LADDIE
LAKEGPS & RETIED CAST IRON
W/ SIGN & POST S. SIDE

2.2.00


J. SIMMER

T. SCHWAB

MEANDER CORNER WEST SIDE LADDIE LAKE

SEC. 1 T 30 R 24

RETIED CAST IRON MONUMENT.

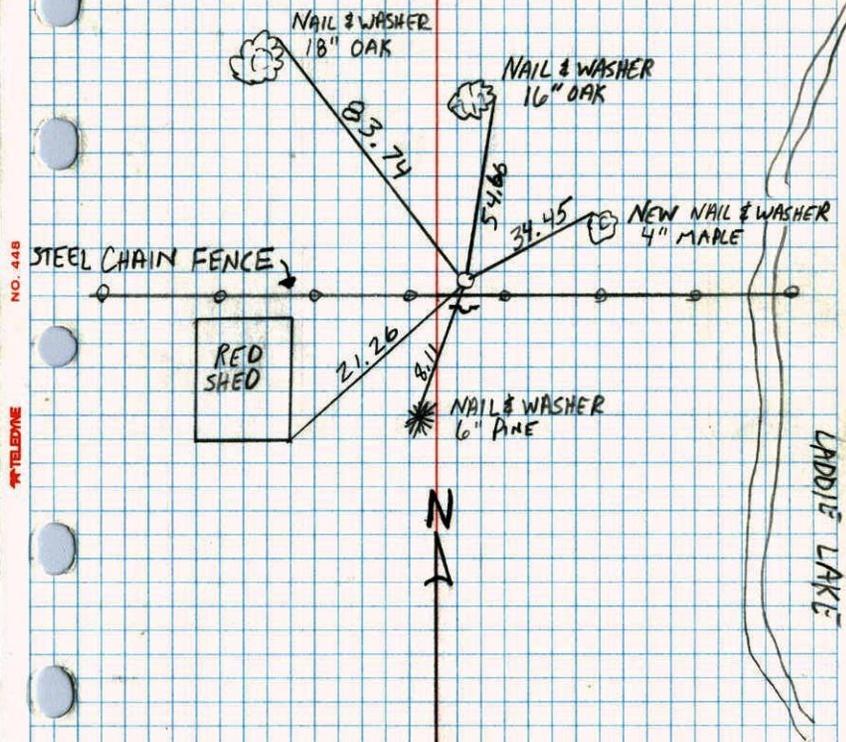

7-13-89

A. SHROYER
M. ZIMMERMAN

MEANDER CORNER WEST SIDE LADDIE LAKE SEC. 1, T30, R24


RETIED CONCRETE MONUMENT 1/2" IRON PIPE ON NORTH SIDE. NAIL & WASHER IN ALL TIE TREES.

CONCRETE DOWN 1.00'±.

REPLACED CONCRETE WITH CAST IRON MONUMENT (DOWN .1'±) STEEL SIGN POST WITH WARNING SIGN 1'± SOUTH ON MONUMENT.

6 JUL 66
H. LARSON
D. POTTER

20 JUN 74
R. FARMER
N. DAHL
D. DAHL

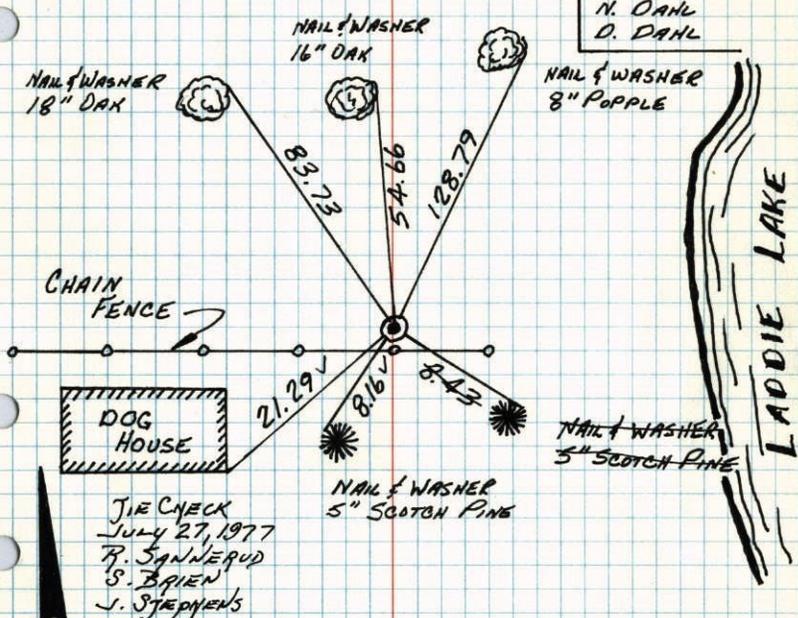

TIE CHECK
JULY 27, 1977
R. SANNEBUD
S. BRIEN
J. SJEPHENS

TIE CHECK
7-22-80
B. STEPHENS
P. ROSS
P. HORNBY


ROLAND W. ANDERSON
COUNTY SURVEYOR
ANOKA COUNTY, MINNESOTA

TEMPERATURE CORRECTED
AND HORIZONTALLY
TAPED MEASUREMENTS

REDRAWN
JAN '77
R. GUETZKO

Meander Corner West side Laddie Lake Sec 1 T30 R24

Retied Concrete monument 1/2" Iron pipe on North side. Nail & washer in all Tie trees. down 1.00'±

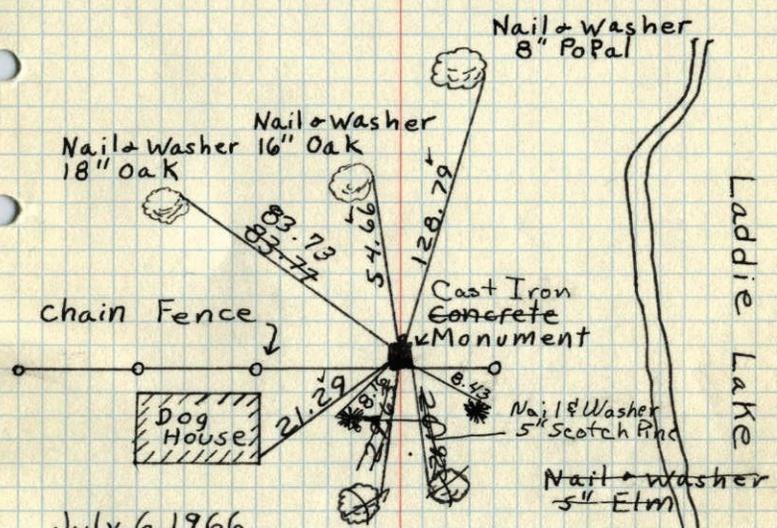

July 6, 1966
H. Larson
D. Potter
Temp 78°
Tape #1

Tie Check
Aug 14, 1970
P. Brien
B. Olson

Replaced con with Cast Iron mon. (down .1'±). steel sign post with warning sign 1'± South of Mon.

June 20, 1974
R. Farmer
N. Dahl
D. Dahl


TEMPERATURE CORRECTED
AND HORIZONTALLY
TAPED MEASUREMENTS

ROLAND W. ANDERSON
COUNTY SURVEYOR
ANOKA COUNTY, MINNESOTA

1970 3

Meander Corner West side Laddie Lake Sec 1 T30 R24

Retied Concrete monument $\frac{1}{2}$ " Iron pipe on North side. Nail + washer in all Tie trees. down 1.00'

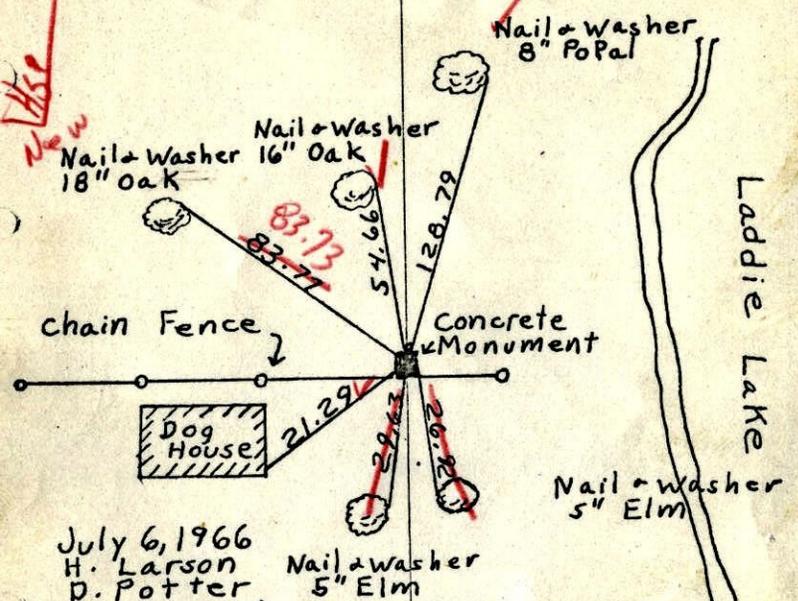

July 6, 1966
H. Larson
D. Potter
Temp 78°
Tape #1

Temp 80° - #10
8-14-70
R. Brion
B. Olson

Placed 2" Iron Pipe on South Side up 2 Feet


TEMPERATURE CORRECTED AND HORIZONTALLY TAPED MEASUREMENTS

ROLAND W. ANDERSON
COUNTY SURVEYOR
ANOKA COUNTY, MINNESOTA

1966

M.C. on west side Laddie Lake Sec. 1 T30 R24

Retied concrete mon. $\frac{1}{2}$ " iron pipe on N. side. Nail + washers in all Tie Trees. down 1.00'

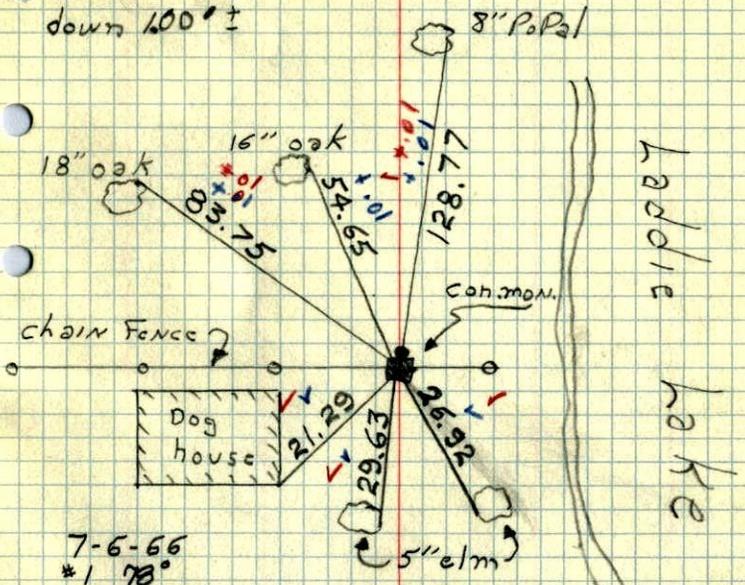

7-6-66
#1 78°
H. Larson
D. Potter


PLACED 2" IRON PIPE ON SOUTH SIDE UP 2 FEET

Laddie Lake

1960 3

M.C. #14 on West Side of Laddie Lake - Sec 1, T30, R24

Conc. Mon. down .5'
Iron on North Side
on fence running east & west
south of 2 Dog Kennels

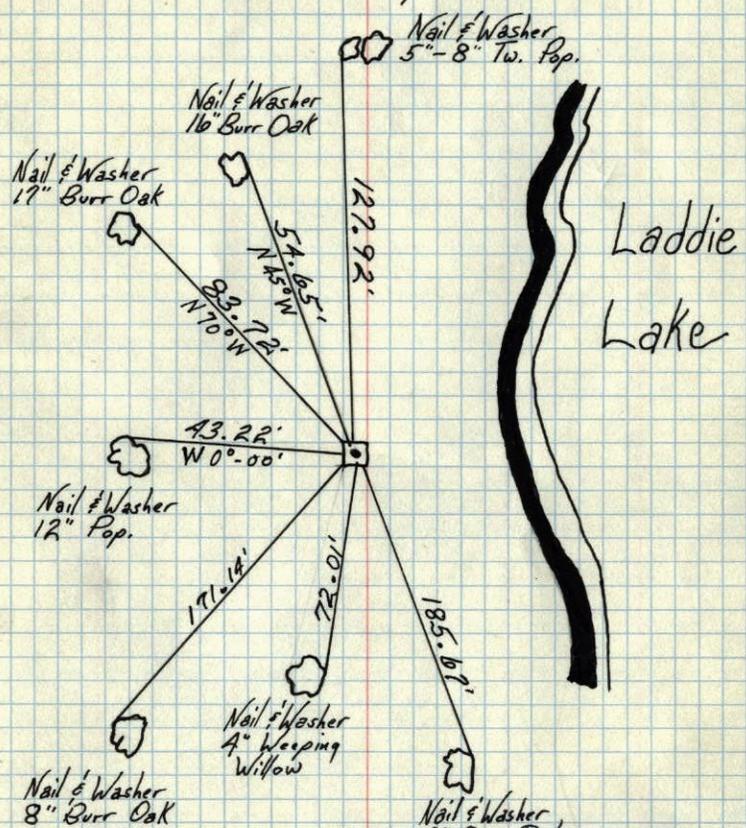

TEMPERATURE CORRECTED
AND HORIZONTALLY
TAPED MEASUREMENTS
ROLAND W. ANDERSON
COUNTY SURVEYOR
ANOKA COUNTY, MINNESOTA

6/27/60
Dennis Potter
Ralph Robinson


1960

M.C. on West Laddie Lake
T30, R24

Down .5'
Iron on North side

on fence running east & west

5-8 Tw, Pop
M
46736.9
46713.2
23.7

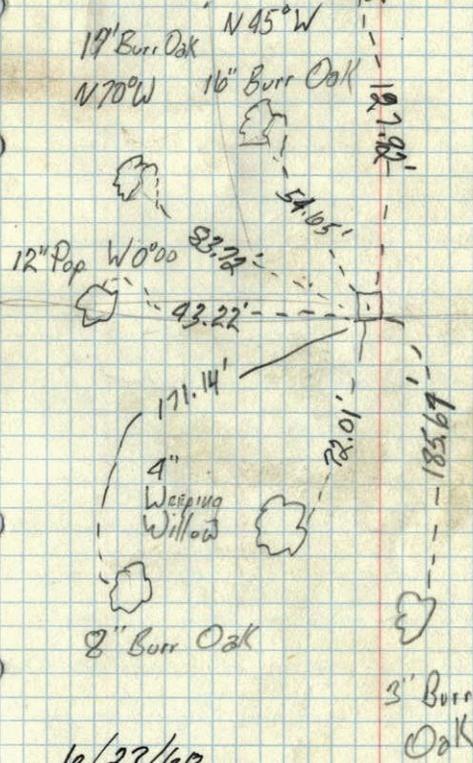

Laddie Lake

6/27/60

~~6/27/60~~